


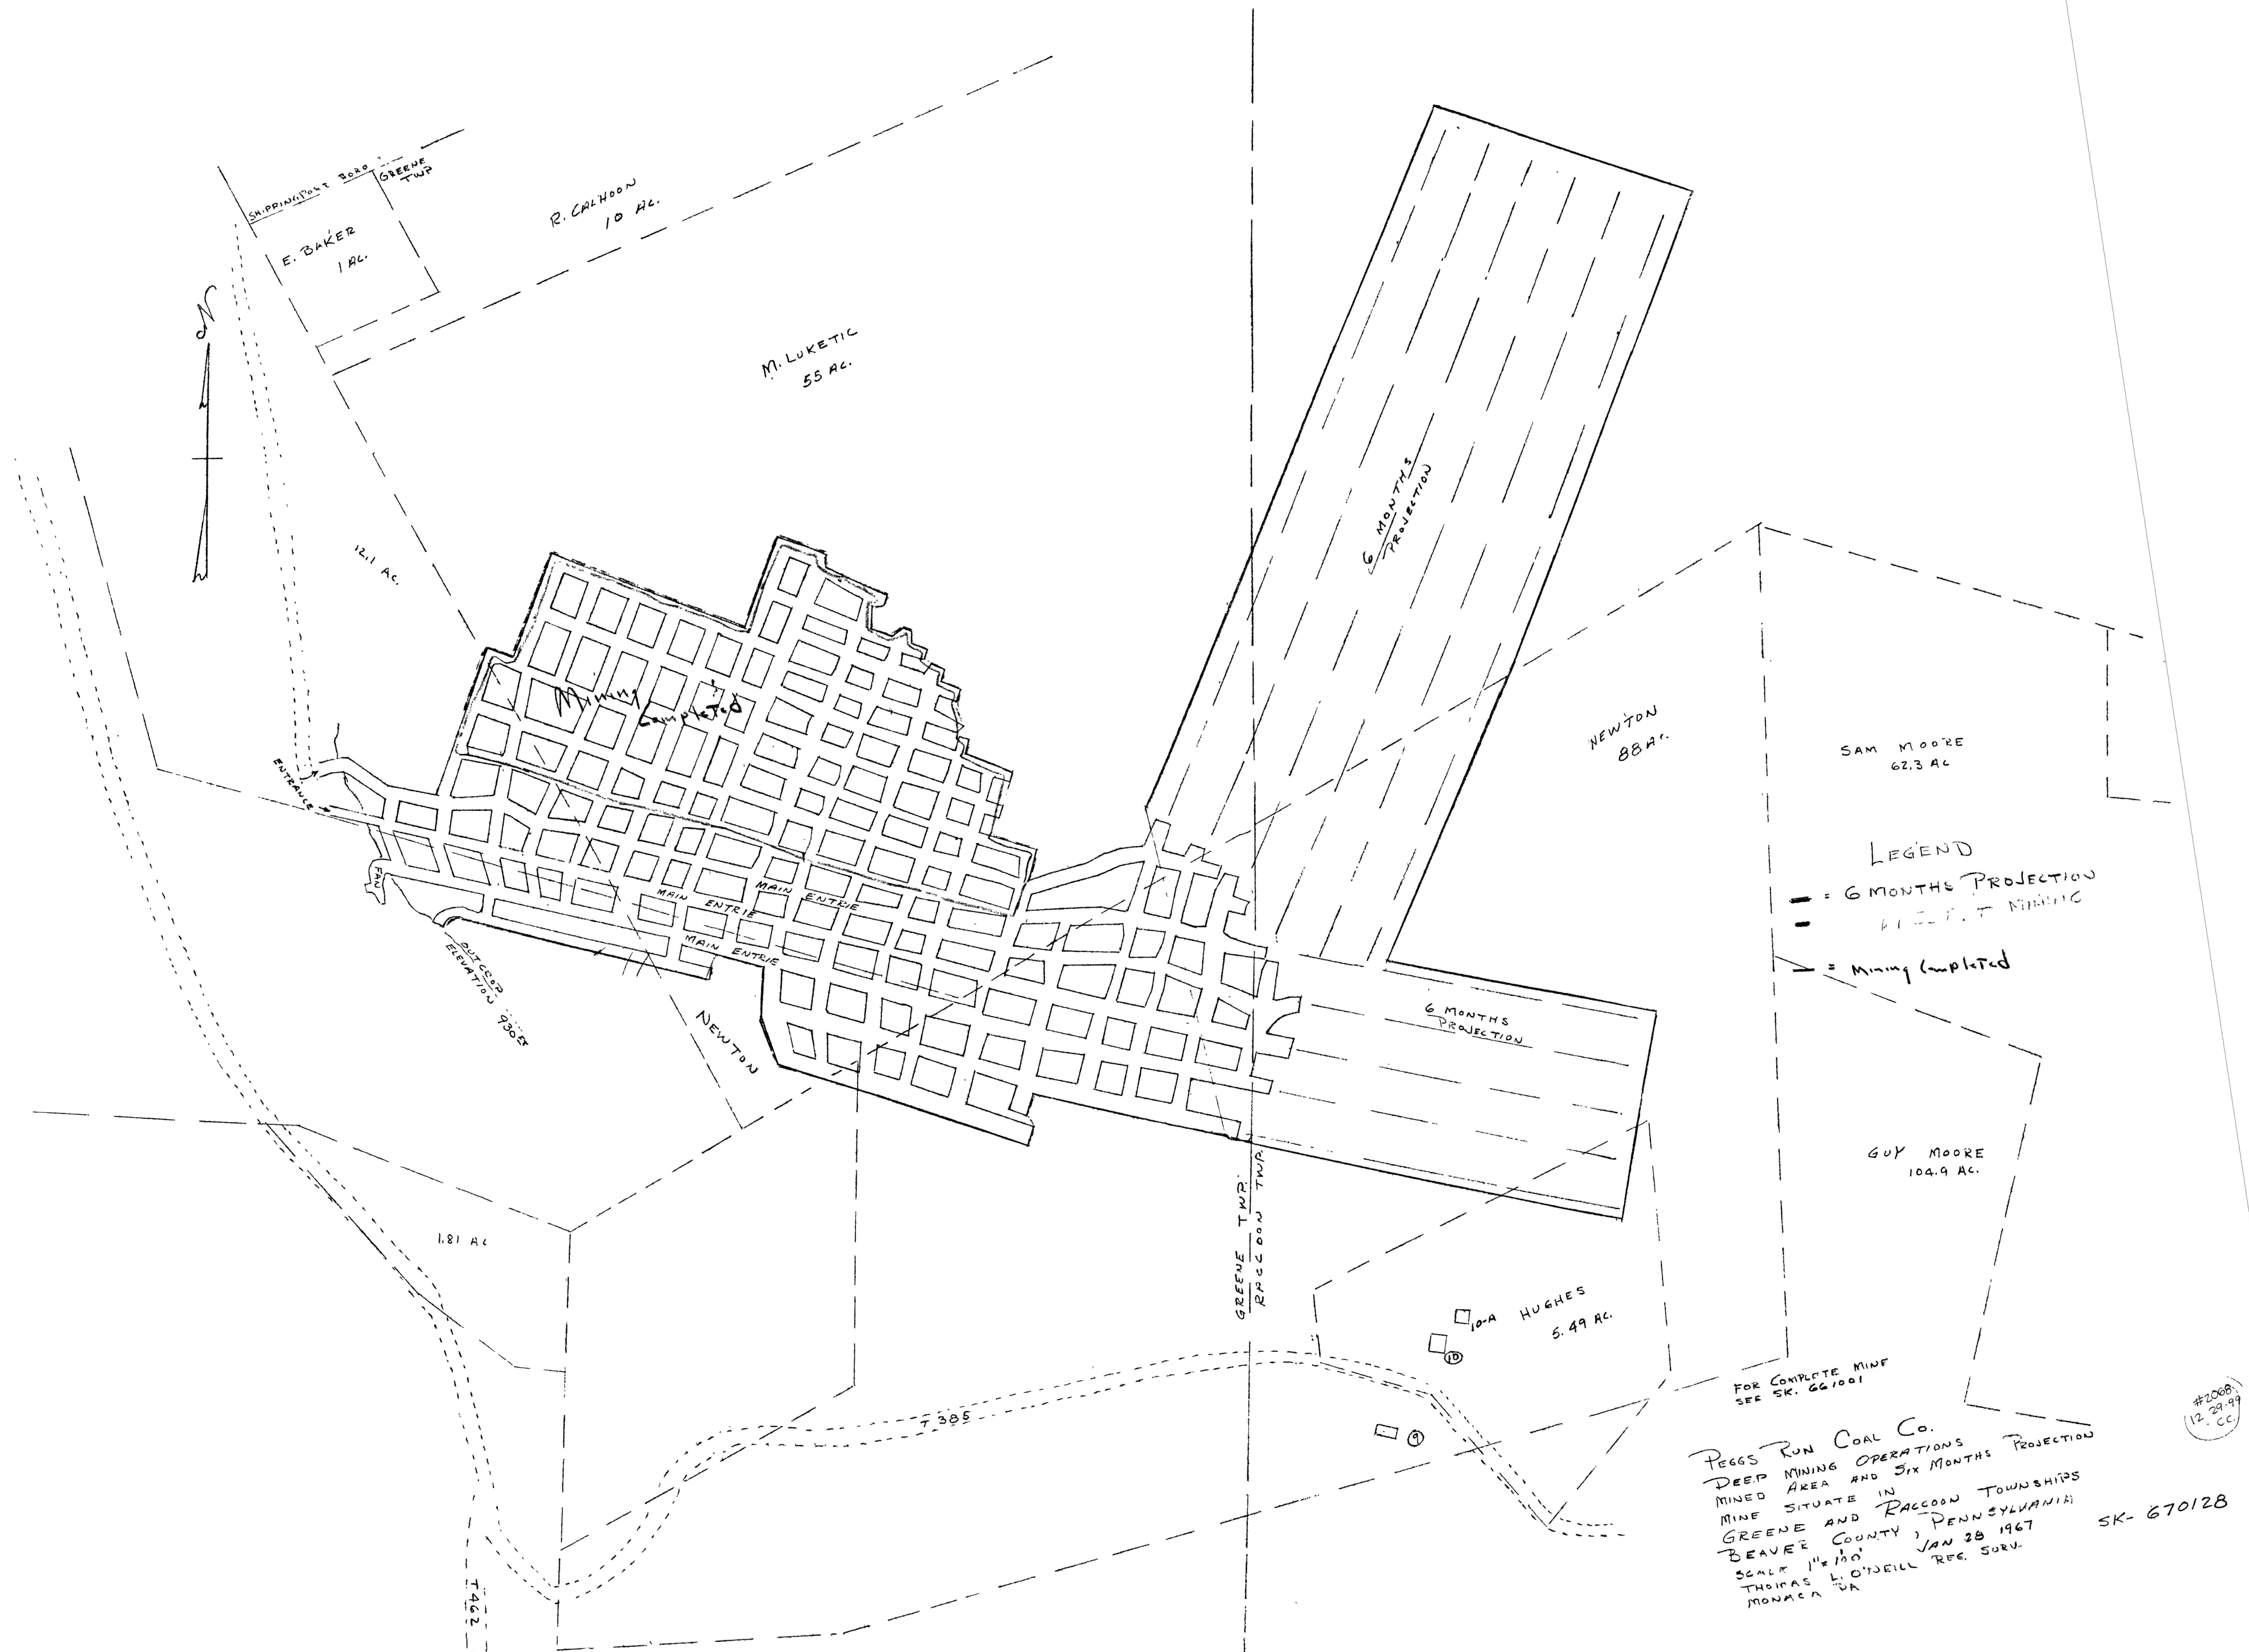

PEGGS RUN COAL CO.
 DEEP MINING OPERATIONS
 MINED AREA AND SIX MONTHS PROJECTION
 MINE SITUATE IN
 GREENE AND RACCOON TOWNSHIPS
 BEAVER COUNTY, PENNSYLVANIA
 SCALE 1"=100' JAN 28 1967
 THOMAS L. O'DWELL REG. SURV.
 MONACA PA

#2008
 12-29-99
 CC