


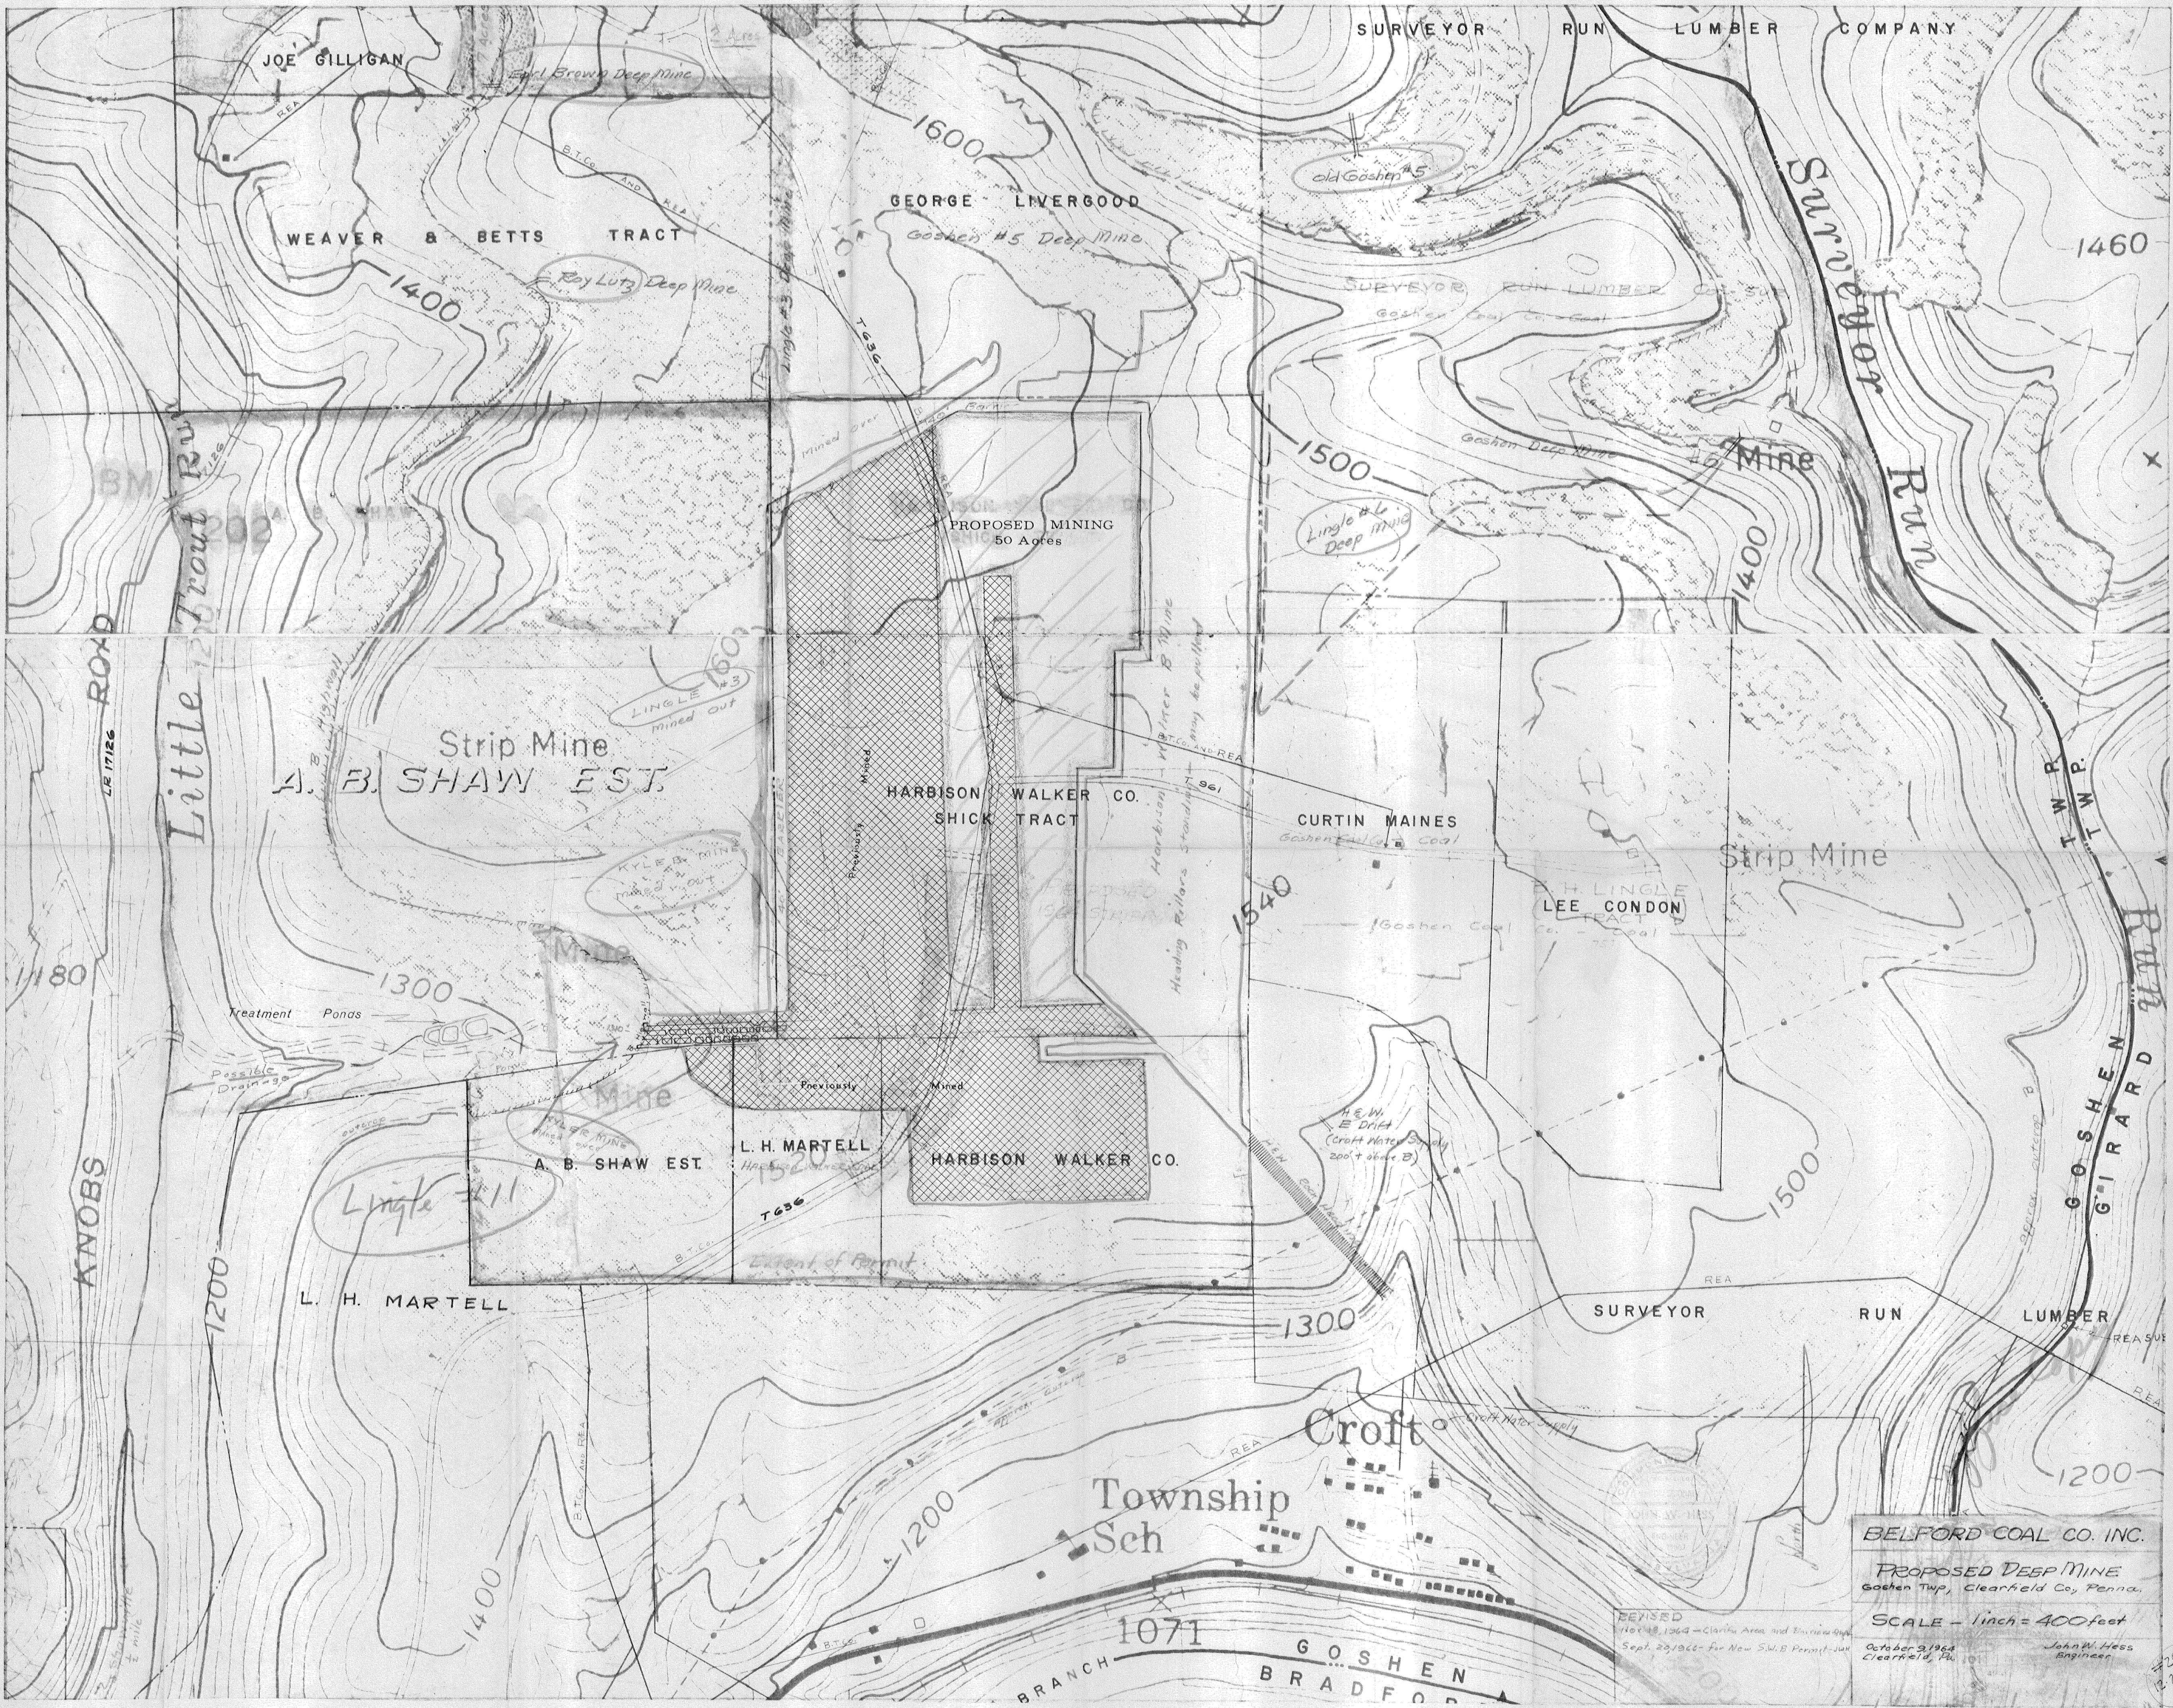

BELFORD COAL CO. INC.

PROPOSED DEEP MINE
Goshen Twp., Clearfield Co., Penna.

SCALE - 1 inch = 400 feet

REVISED
1101-18-1364 - Clarified Area and Enlarged
Sept. 28/1966 - for New S.W.B. Permit - JUN
October 3/1964
Clearfield, Pa.

John W. Hess
Engineer

#206
12-28-97
CC