


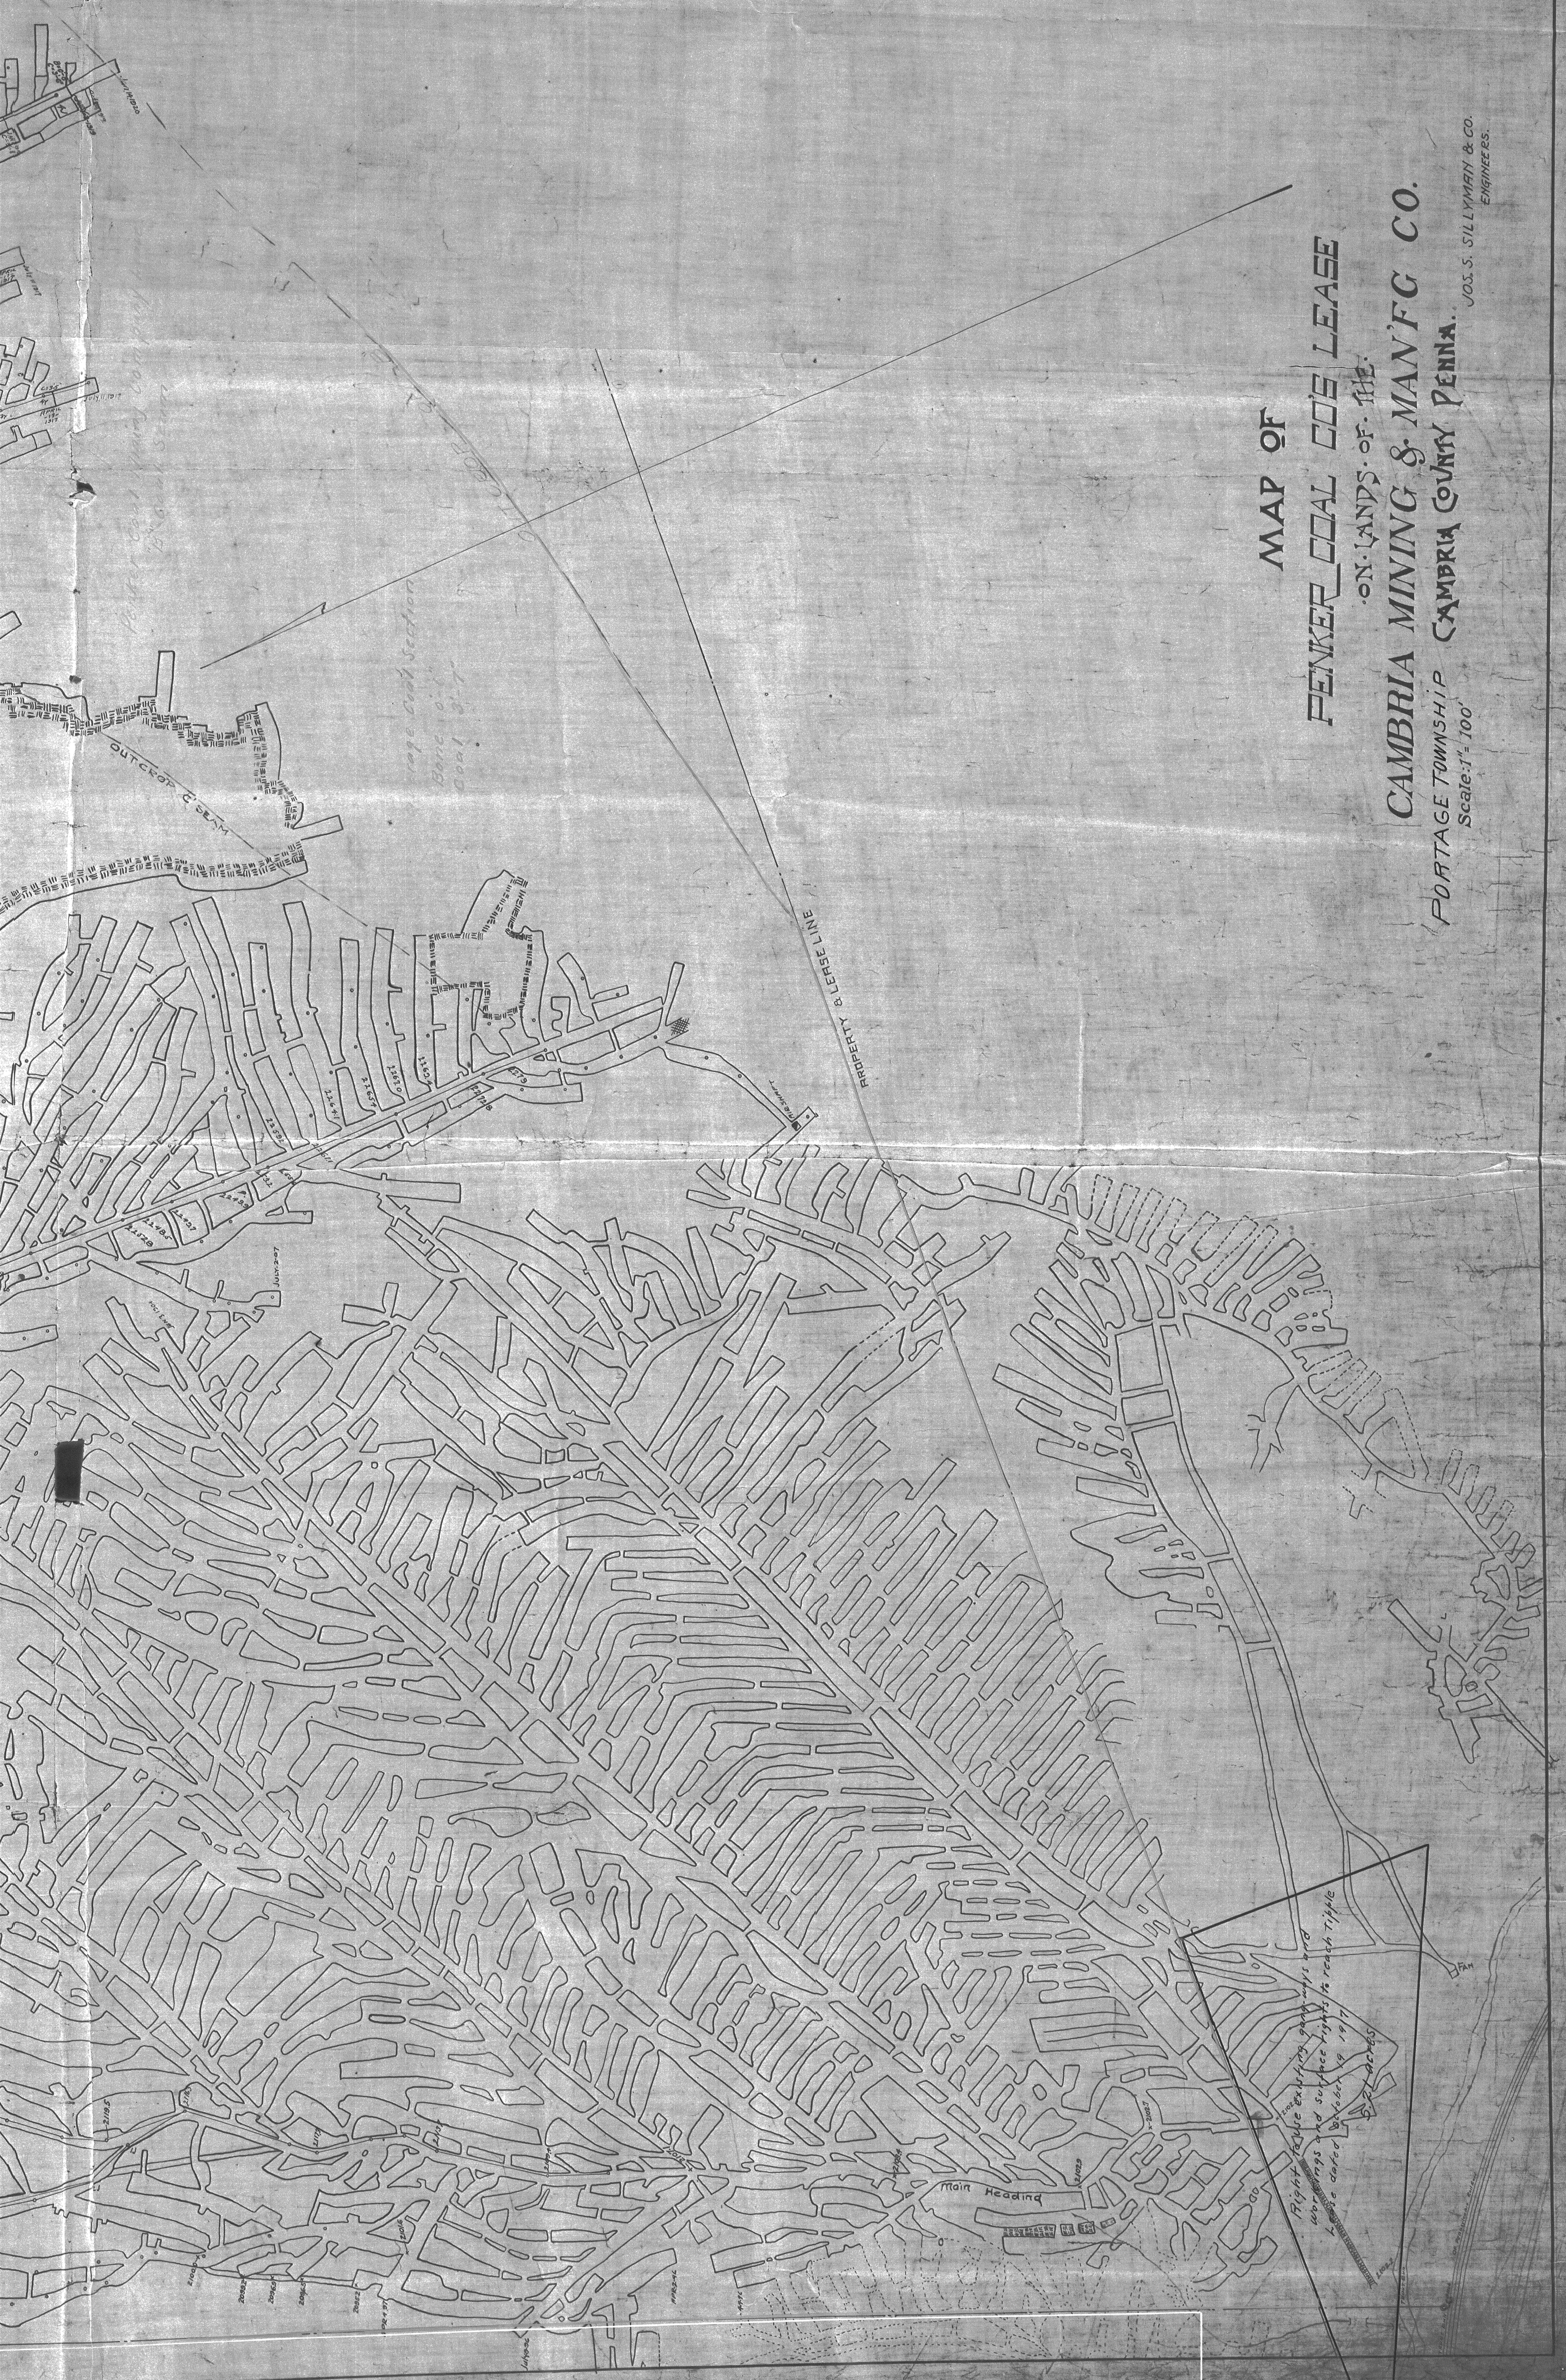

MAP OF
PENNER COAL CO'S LEASE
ON LANDS OF THE
CAMBRIA MINING & MAN'G CO.
PORTAGE TOWNSHIP CAMBRIA COUNTY PENNA.
Scale 1" = 100'

ENGINEERS.

