


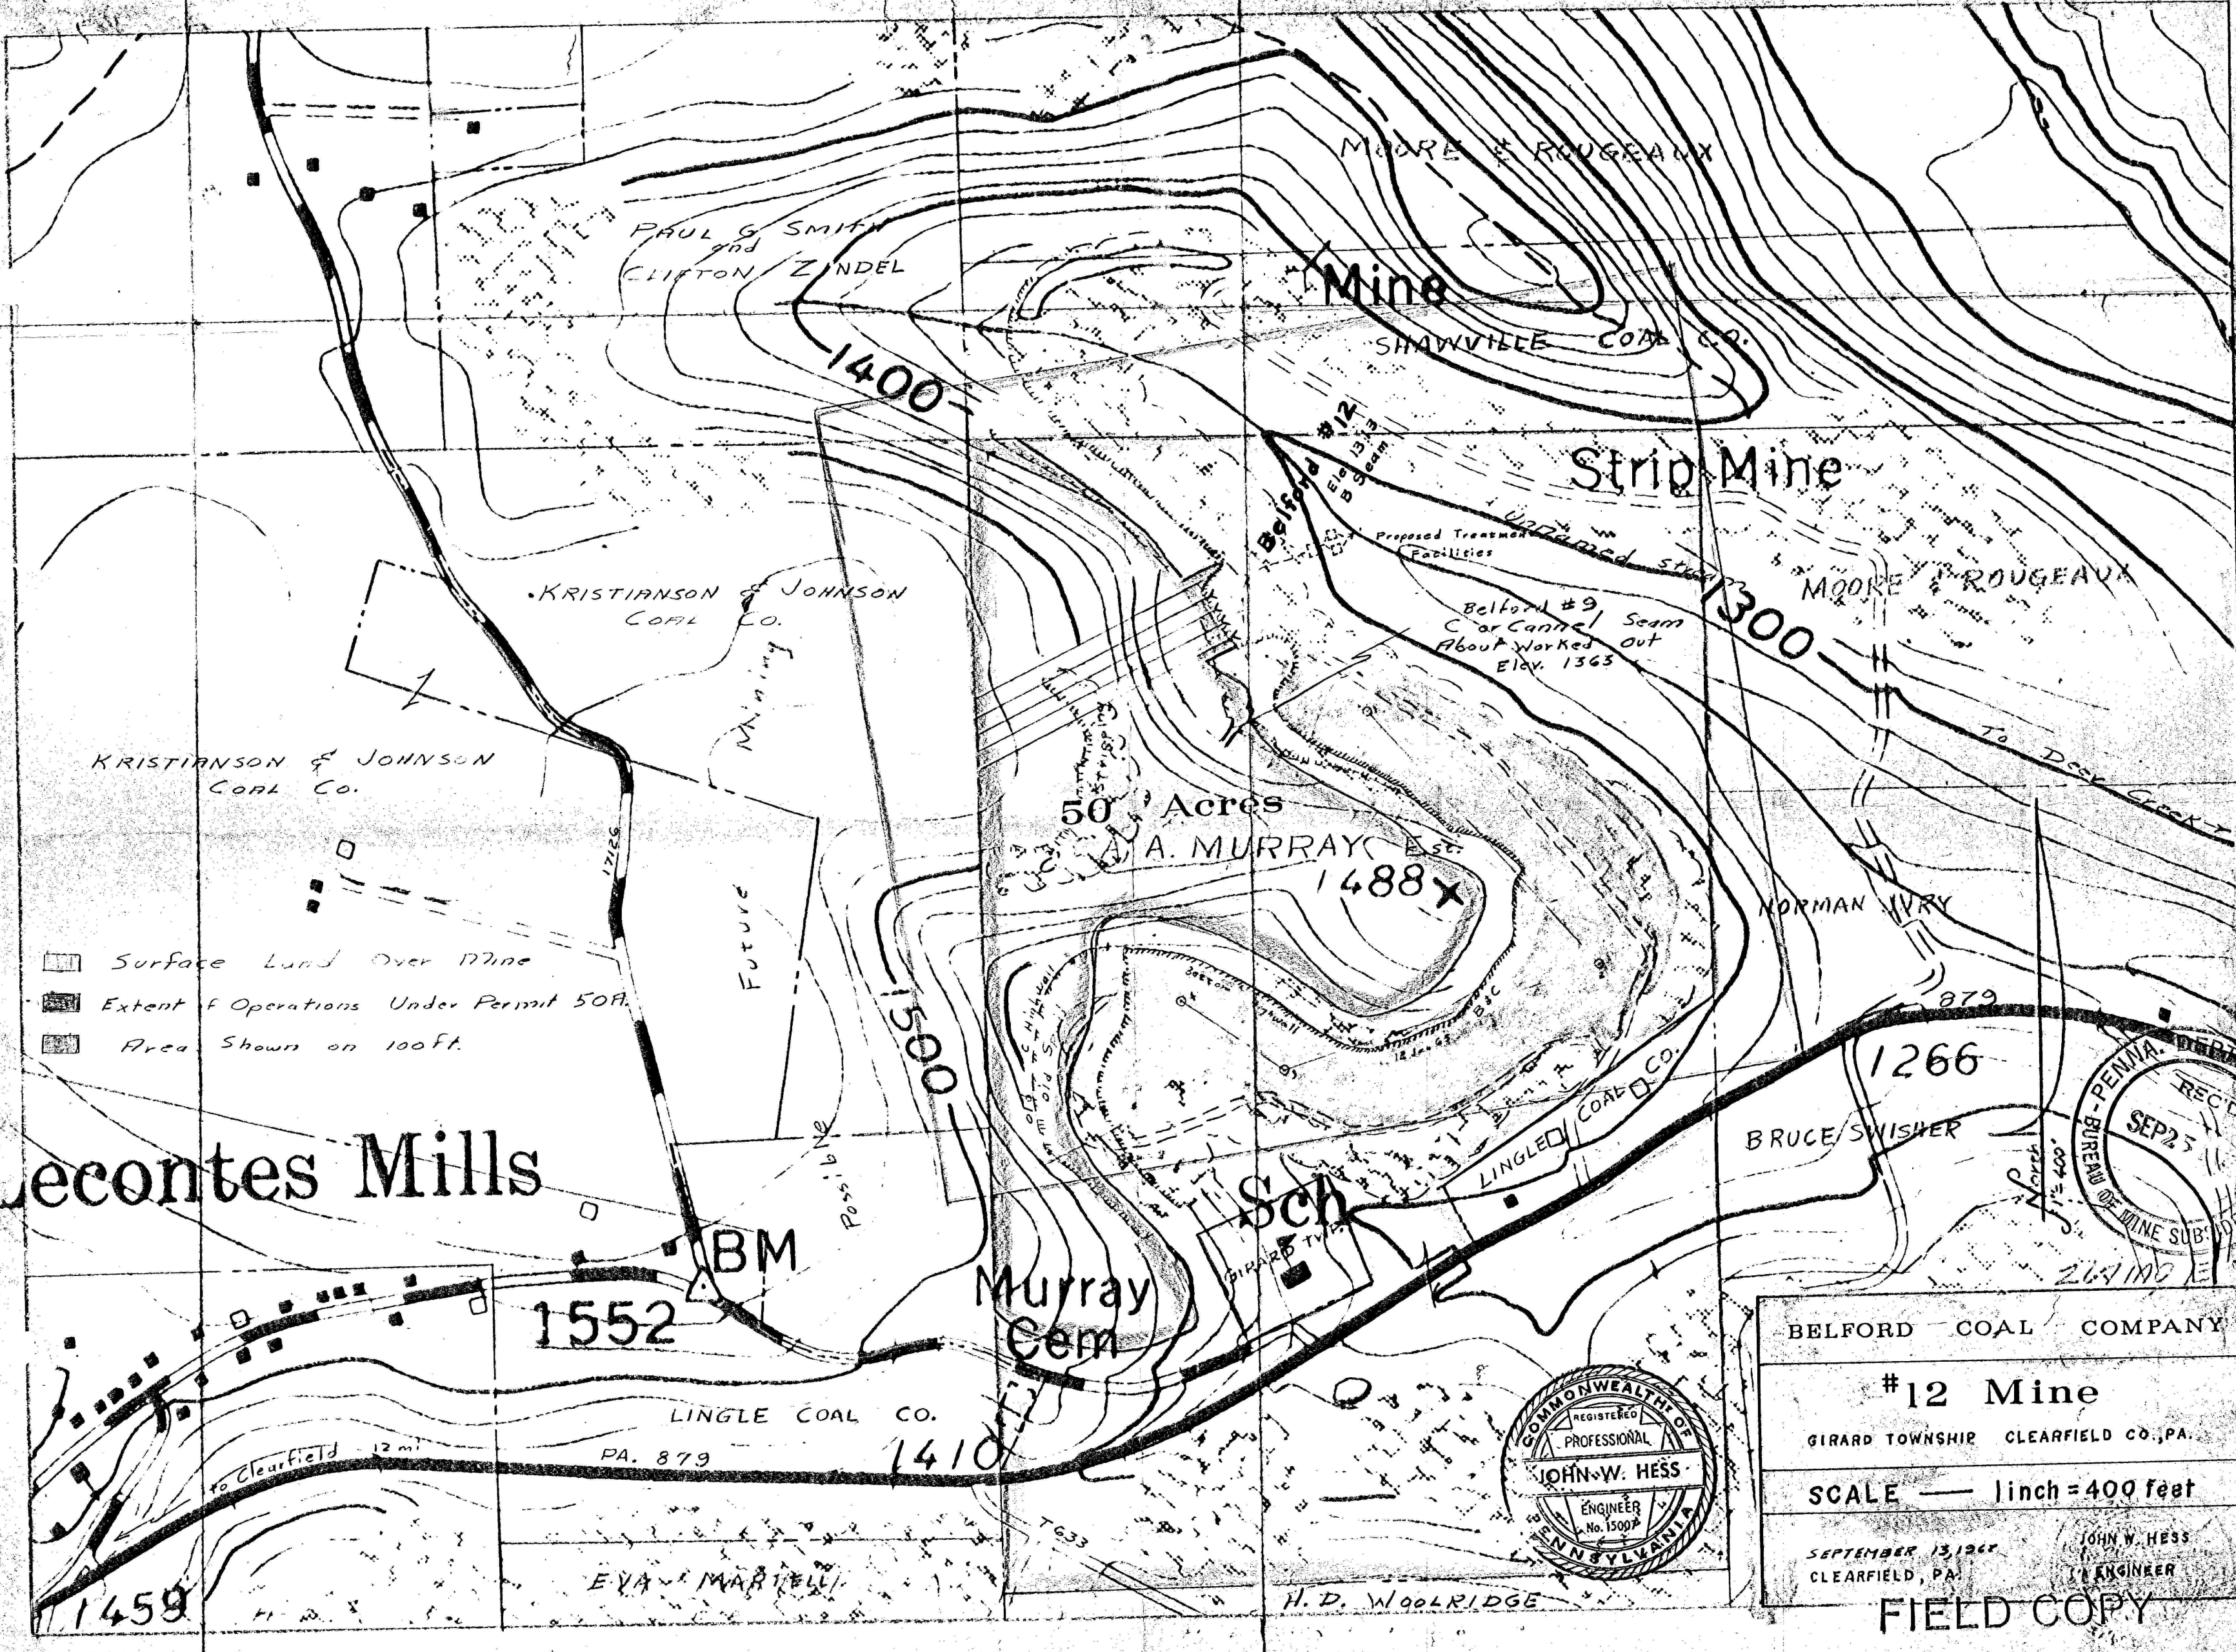

- Surface Land Over Mine
- Extent of Operations Under Permit 50A
- Area Shown on 100 ft.

Lecontes Mills

BELFORD COAL COMPANY	
#12 Mine	
GIRARD TOWNSHIP CLEARFIELD CO., PA.	
SCALE — 1 inch = 400 feet	
SEPTEMBER 13, 1967 CLEARFIELD, PA.	JOHN W. HESS ENGINEER No. 15002
FIELD COPY	

