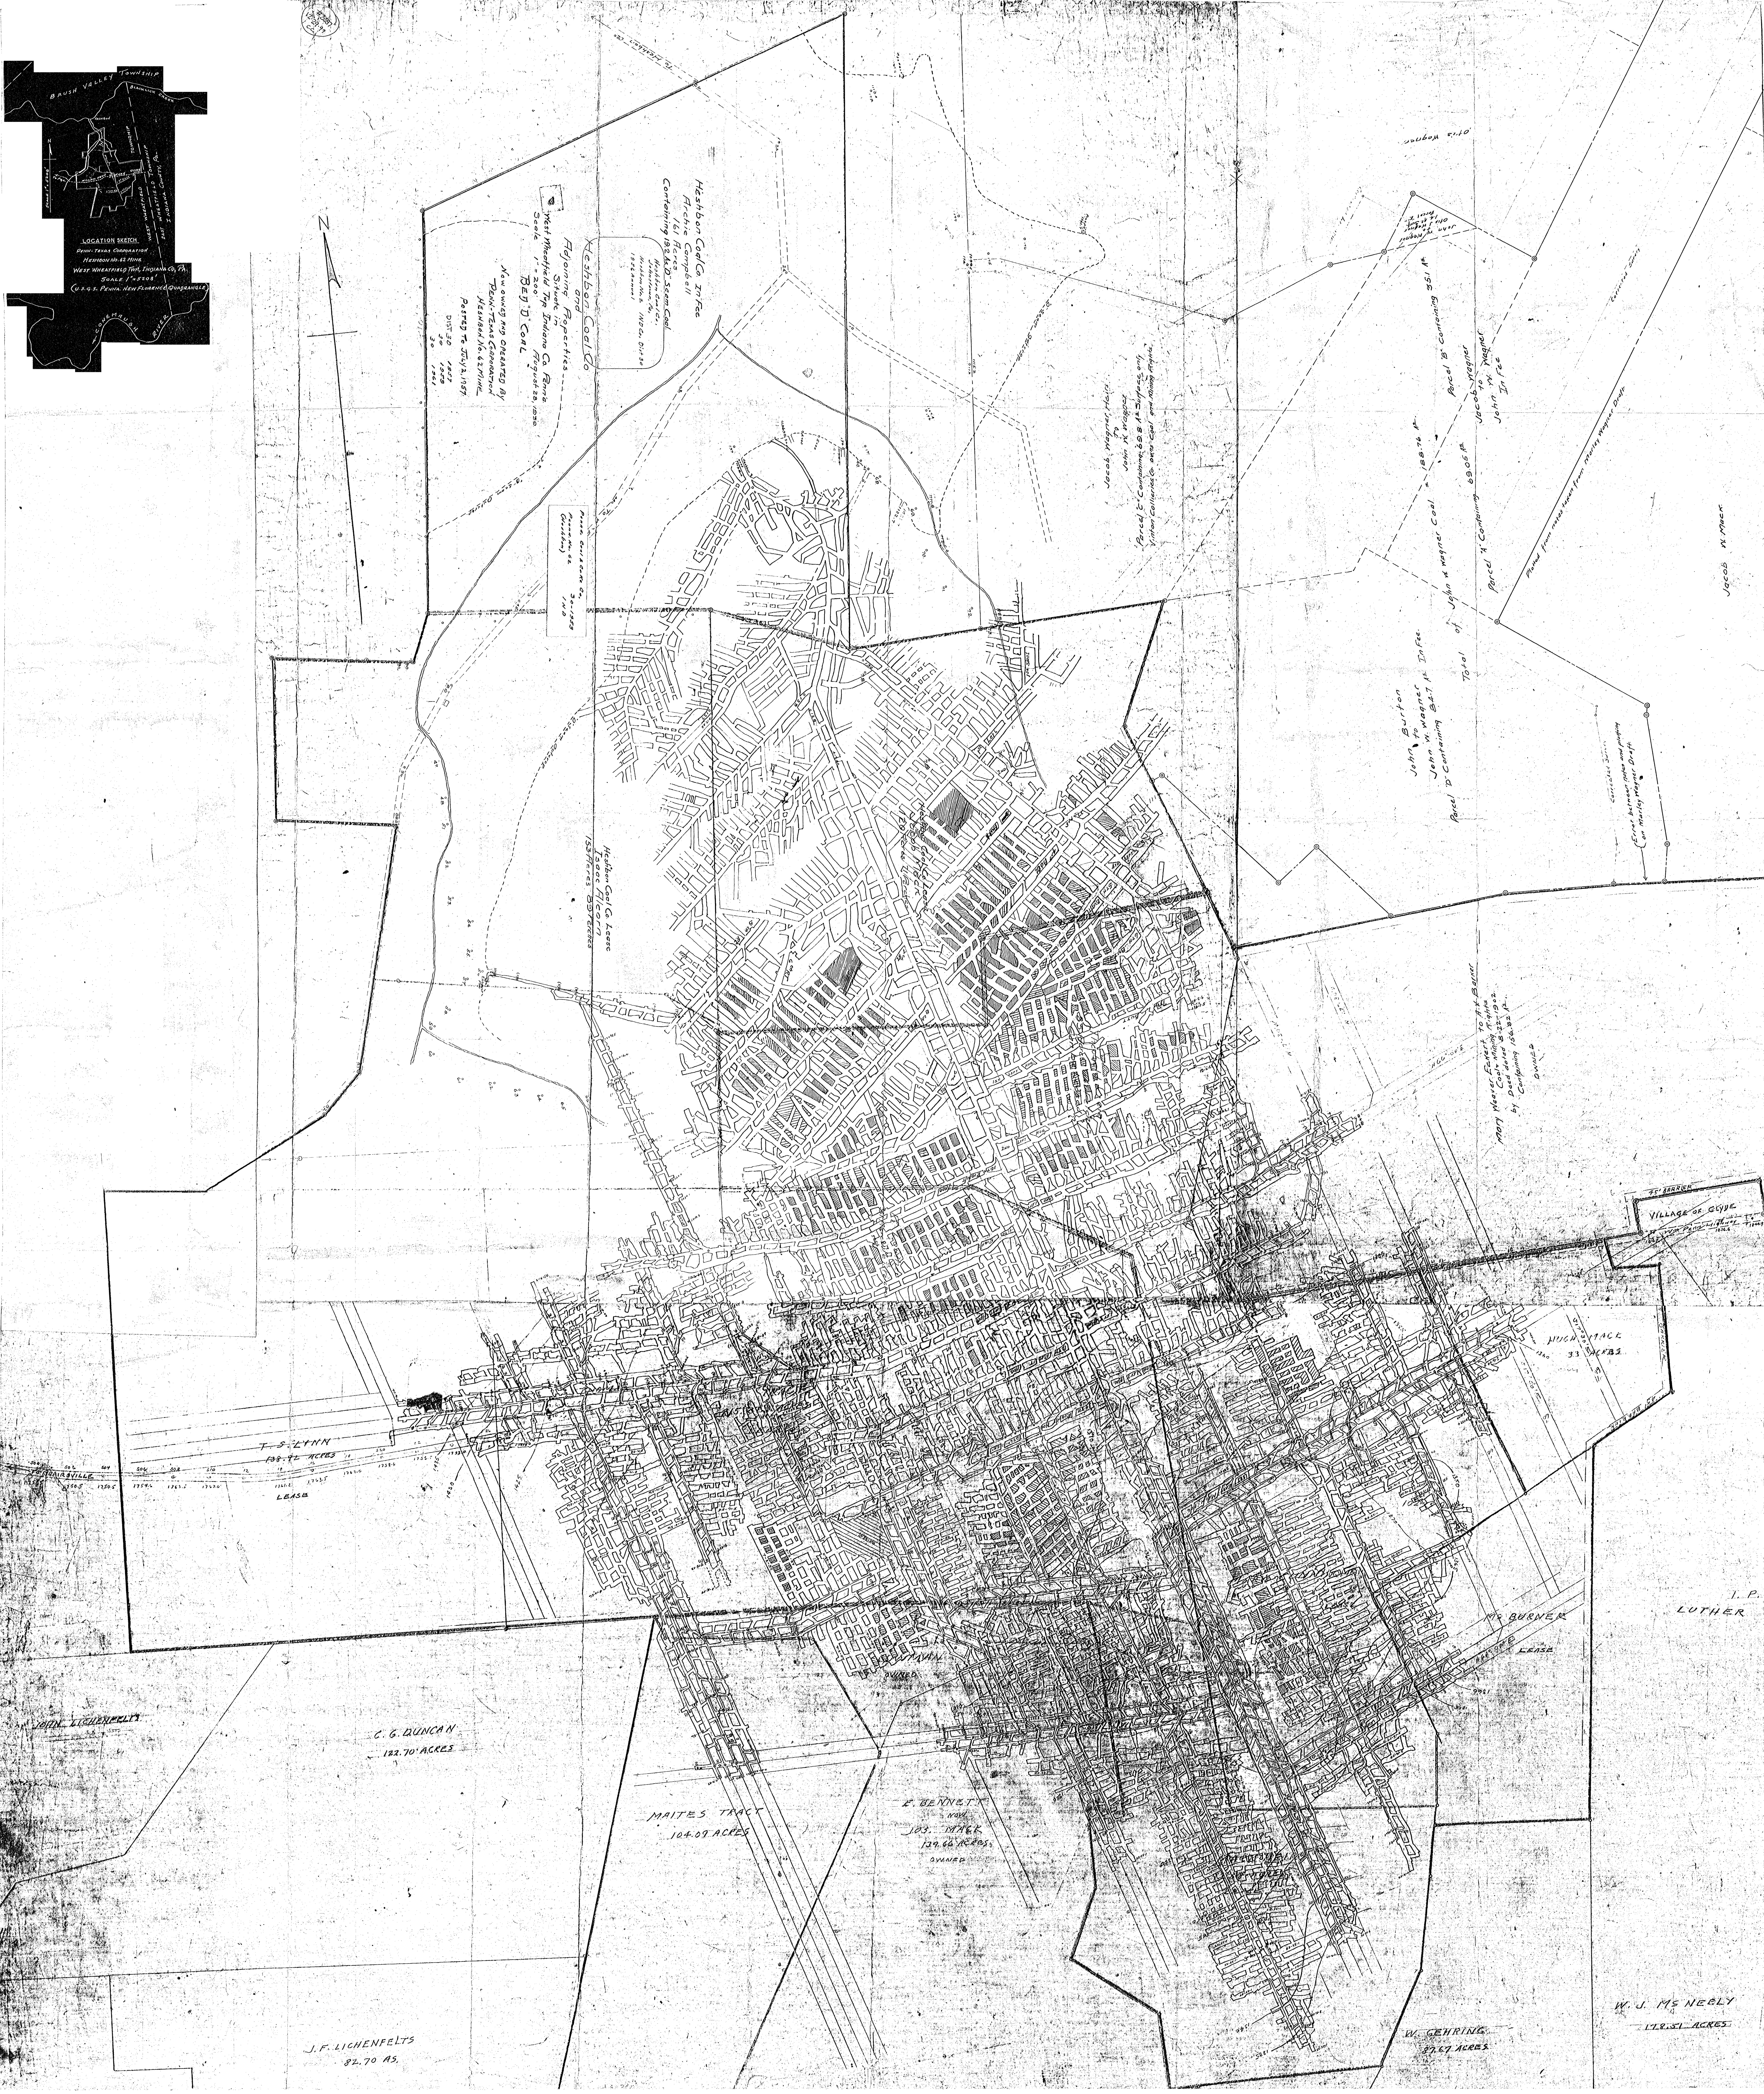
#2587
12-29-99
CC
BRUSH VALLEY TOWNSHIP
BLACKLICK CREEK
HESHBON
N
TOWNSHIP
WEST WHEATFIELD TOWNSHIP
EAST WHEATFIELD TOWNSHIP
INDIANA COUNTY, PA.
SCALE 1"=5208'
WILLIAM PENN HIGHWAY
CLYDE
LOCATION SKETCH
PENN-TEXAS CORPORATION
HESHBON NO. 62 MINE
WEST WHEATFIELD TWP, INDIANA CO, PA.
SCALE 1"=5208'
(U.S.G.S. PENNA. NEW FLORENCE QUADRANGLE)
CONEMAUGH RIVER
N
To Heshbon
Heshbon Coal Co. In Fee
Archie Campbell
161 Acres
Containing 192 A± "D" Seam Coal.
Heshbon Coal Co.
Johnstown, Pa.
Heshbon No. 2 IND Co. Dist 30
1956 Annual
Heshbon Coal Co
and
Adjoining Properties
Situate in
West Wheatfield Twp Indiana Co. Penn'a
Scale 1" = 200' August 28, 1939
BEJ "D" COAL
NOW OWNED AND OPERATED BY
PENN-TEXAS CORPORATION
HESHBON NO. 62 MINE
POSTED TO JULY 2, 1957
DIST 30 1957
30 1959
30 1961
D Seam Outcrop
Penna. Coal & Coke Co.
Penna. No. 62 30-1959
(Heshbon) IND
Heshbon Coal Co. Lease
Isaac Alcorn
153 Acres 89 Perches
Otis Wagner
John W. Wagner
to Otis J. Wagner
1/4 Acre Surf.
Parcel C
Jacob Wagner Heirs
to
John W. Wagner
Parcel 'C' Containing 69.8 A± Surface only
Vinton Collieries Co. owns Coal and Mining Rights.
Parcel 'B' Containing 35.1 A±
Jacob Wagner
to
John W. Wagner
In Fee
John Burton
to
John W. Wagner In Fee.
Parcel 'D' Containing 84.7 A±
Total of John W. Wagner Coal = 188.76 A±
Parcel 'A' Containing 69.05 A±
Corrected Survey
Plotted from notes taken from Morley Wagner Draft
Jacob W. Mack
Corrected Survey
Error between notes and plotting on Morley Wagner Draft
Mary Weaver Eckert to A.K. Barker
Coal & Mining Rights
Deed dated 8-22-1902
by Containing 156.82 A±
OWNED
N 66° 00' E
45' BARRIER
VILLAGE OF CLYDE
Wm. Penn Highway
HUGH MACK
33 ACRES
T. S. LYNN
138.92 ACRES
LEASE
TO BLAIRSVILLE
JOHN LICHENFELTS
C. G. DUNCAN
122.70 ACRES
MAITES TRACT
104.07 ACRES
E. BENNETT
NOW
JOS. MACK
139.66 ACRES
OWNED
MC BURNER
LEASE
I. P.
LUTHER
W. J. MC NEELY
178.51 ACRES
W. GEHRING
87.67 ACRES
J. F. LICHENFELTS
82.70 AS.