
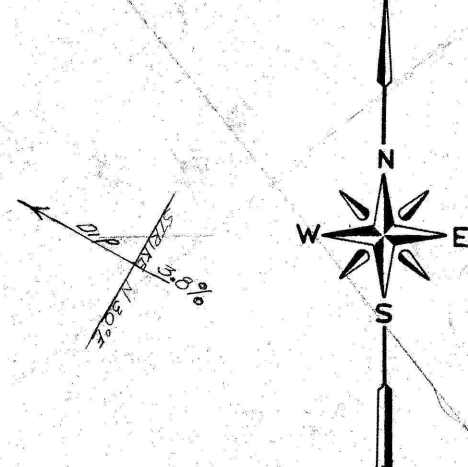


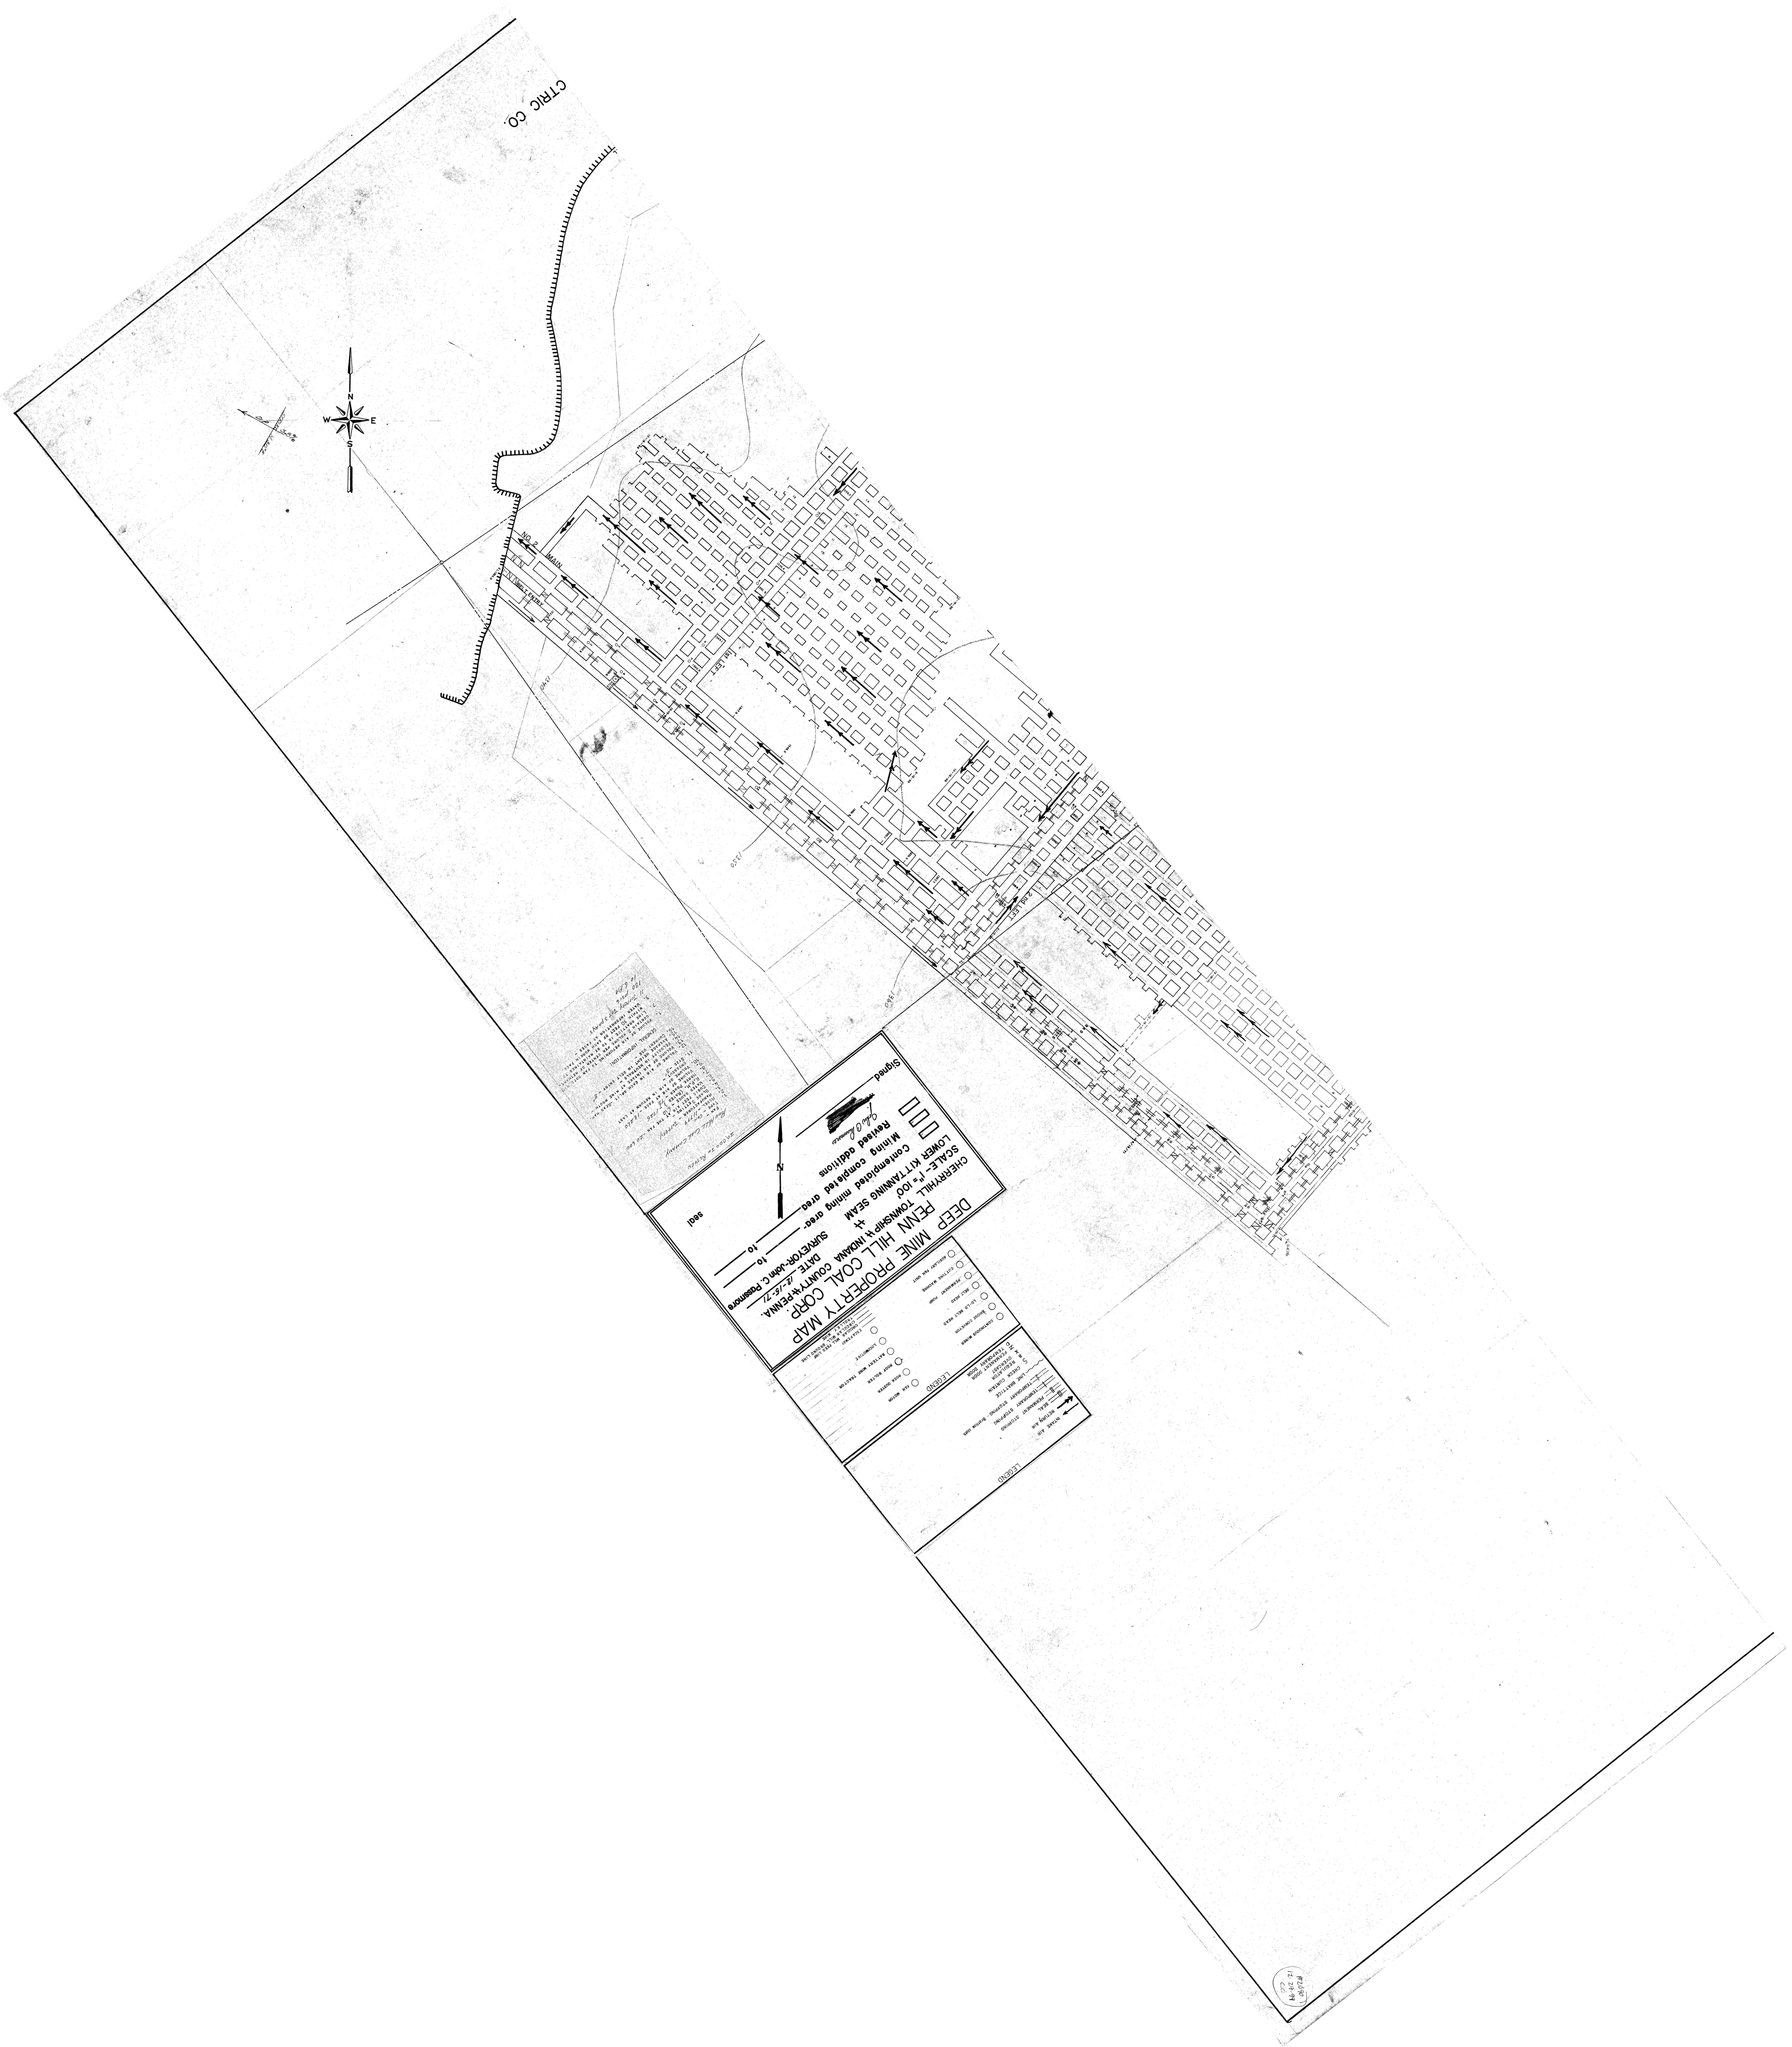

CTRIC CO.

DEEP MINE PROPERTY MAP
PENN HILL COAL CORP.
CHERRYHILL TOWNSHIP IN INDIANA COUNTY, PENNA.
SCALE: 1" = 100'
Mining completed
Revised additions
Signed
DATE: 08-18-71
SUPERVISOR: J. C. Pendergast
TO: _____

