


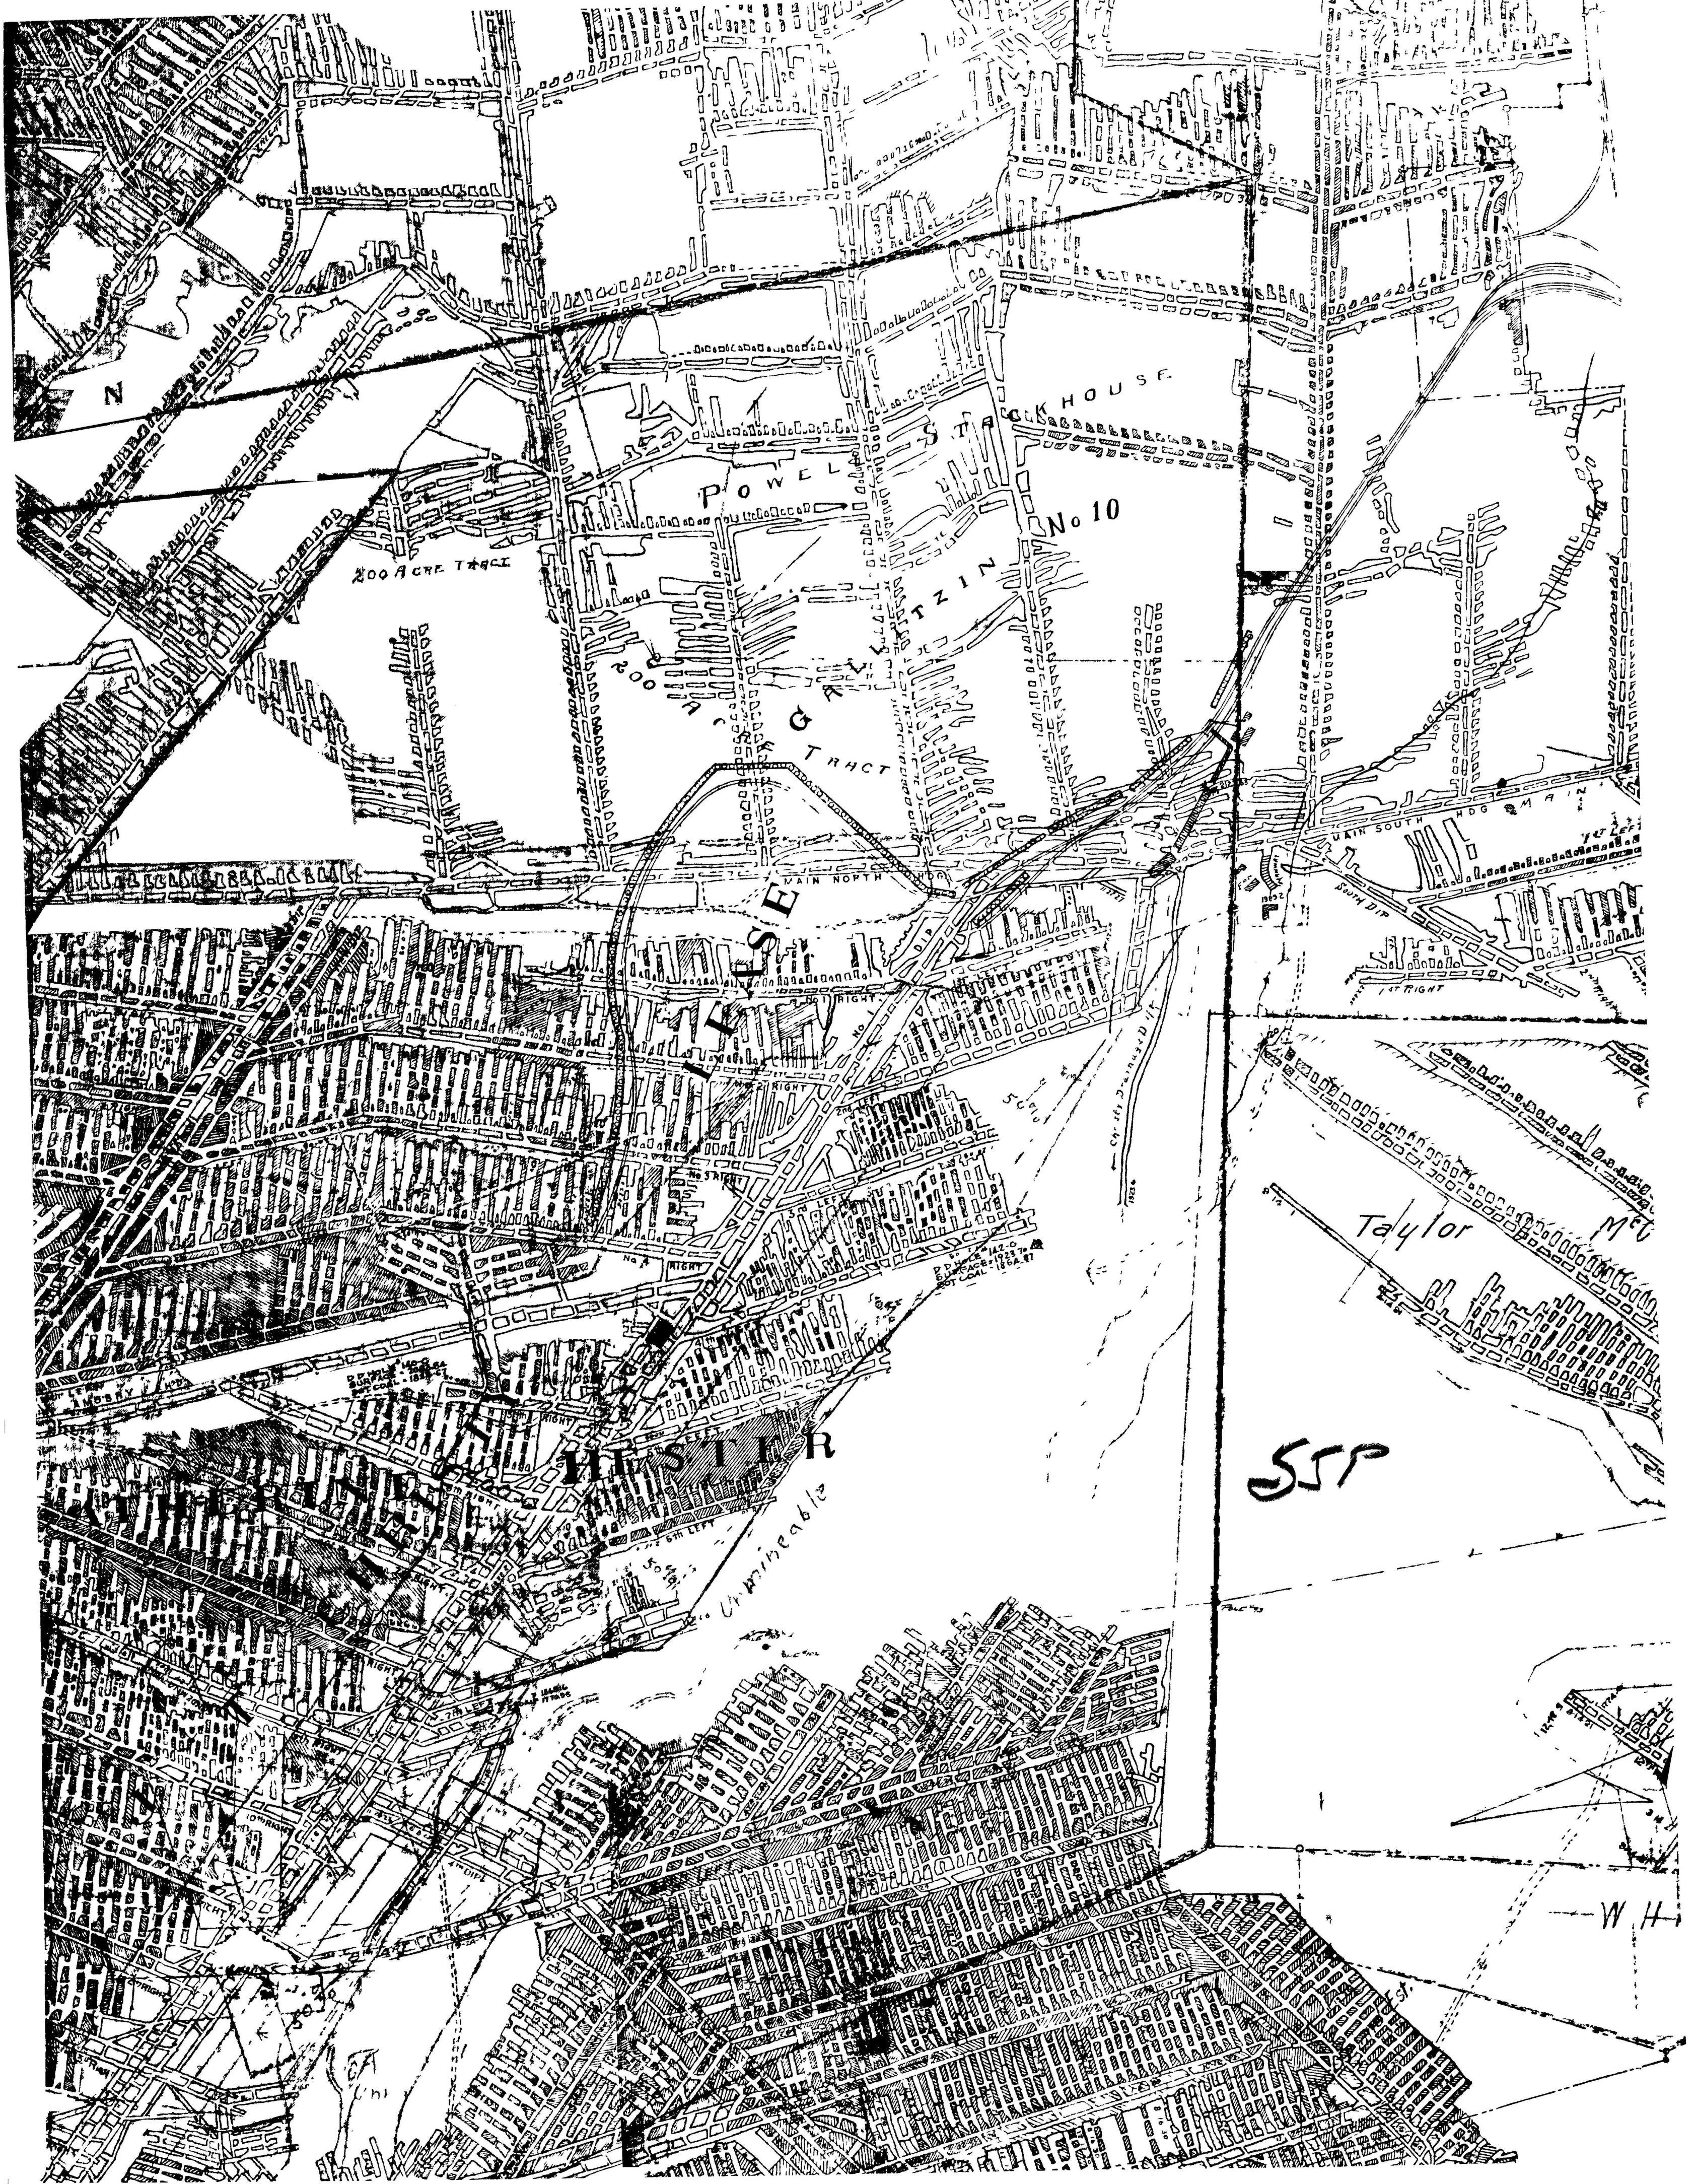

N

200 ACRE TRACT

POWELL


No 10

TIN

HOUSE

Taylor

Mc

SSP

W.H.