



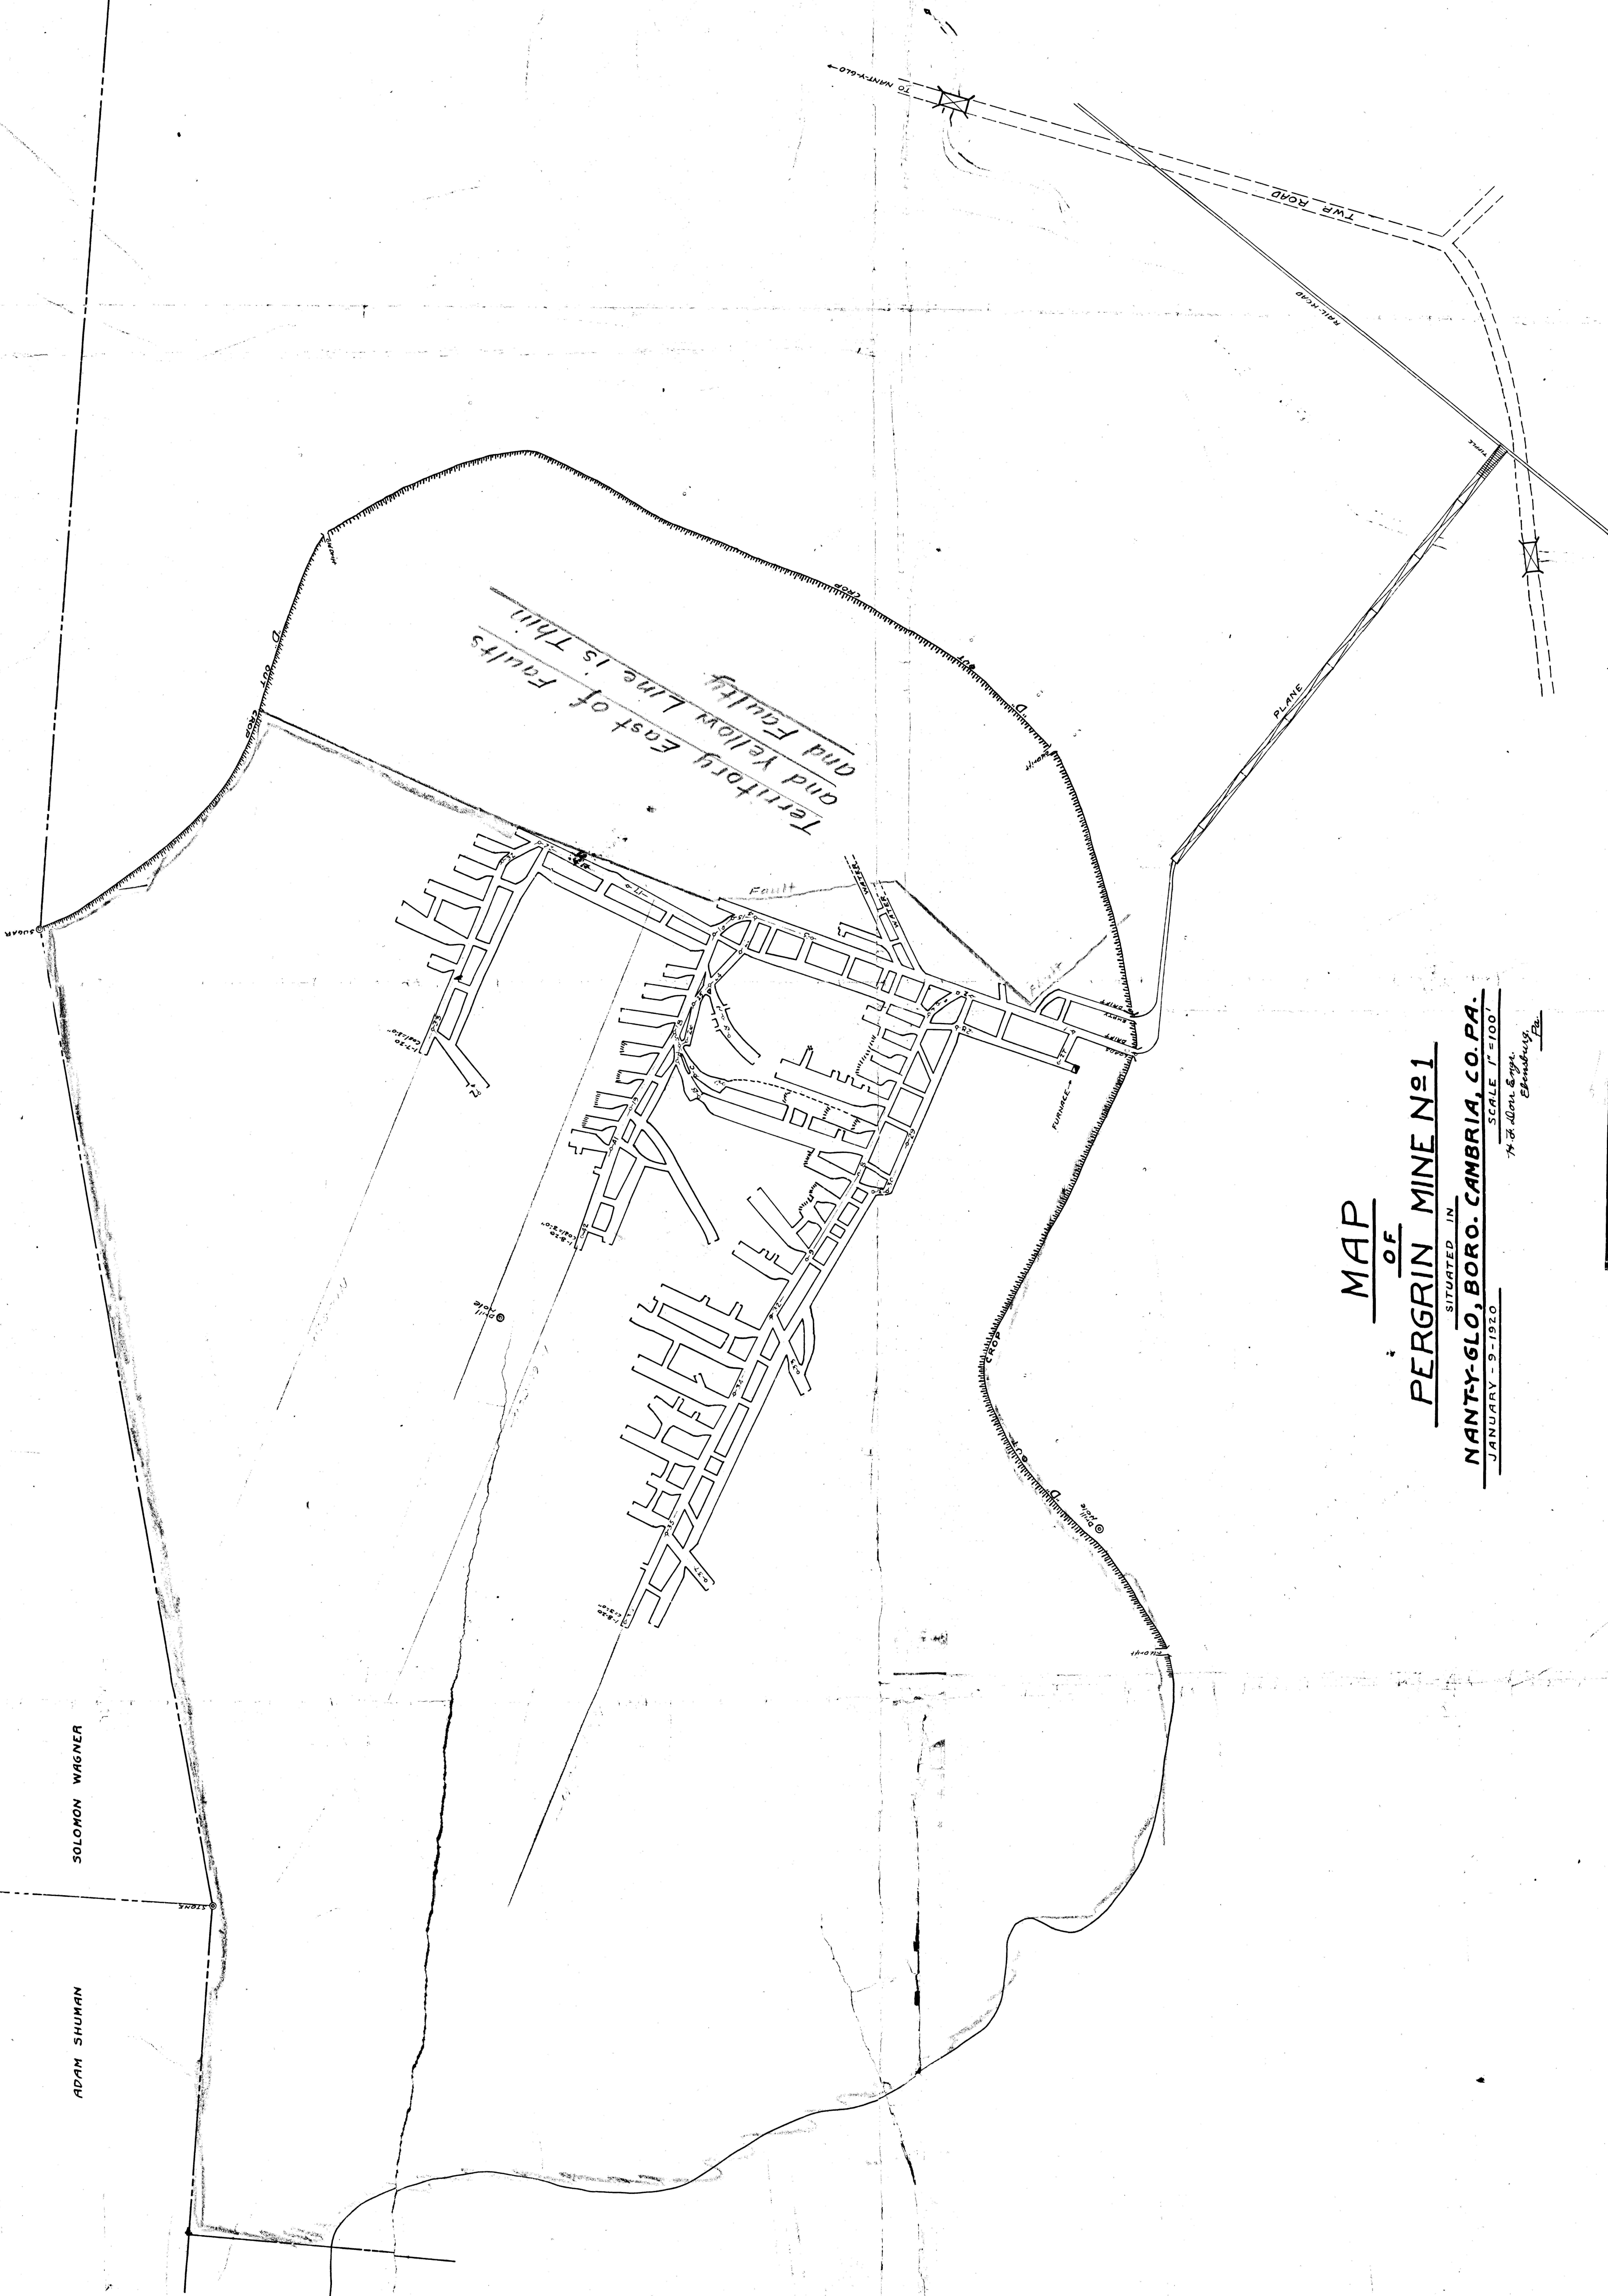

MAP
OF
PERGRIN MINE No. 1
SITUATED IN
NANTY-GLO, BORO. CAMBRIA, CO. PA.
JANUARY - 9-1920
H. & Son, Engs. Elmberg, Pa.

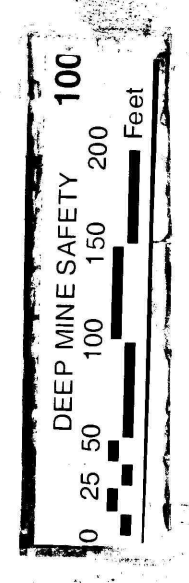

ADAM SHUMAN

SOLOMON WAGNER