


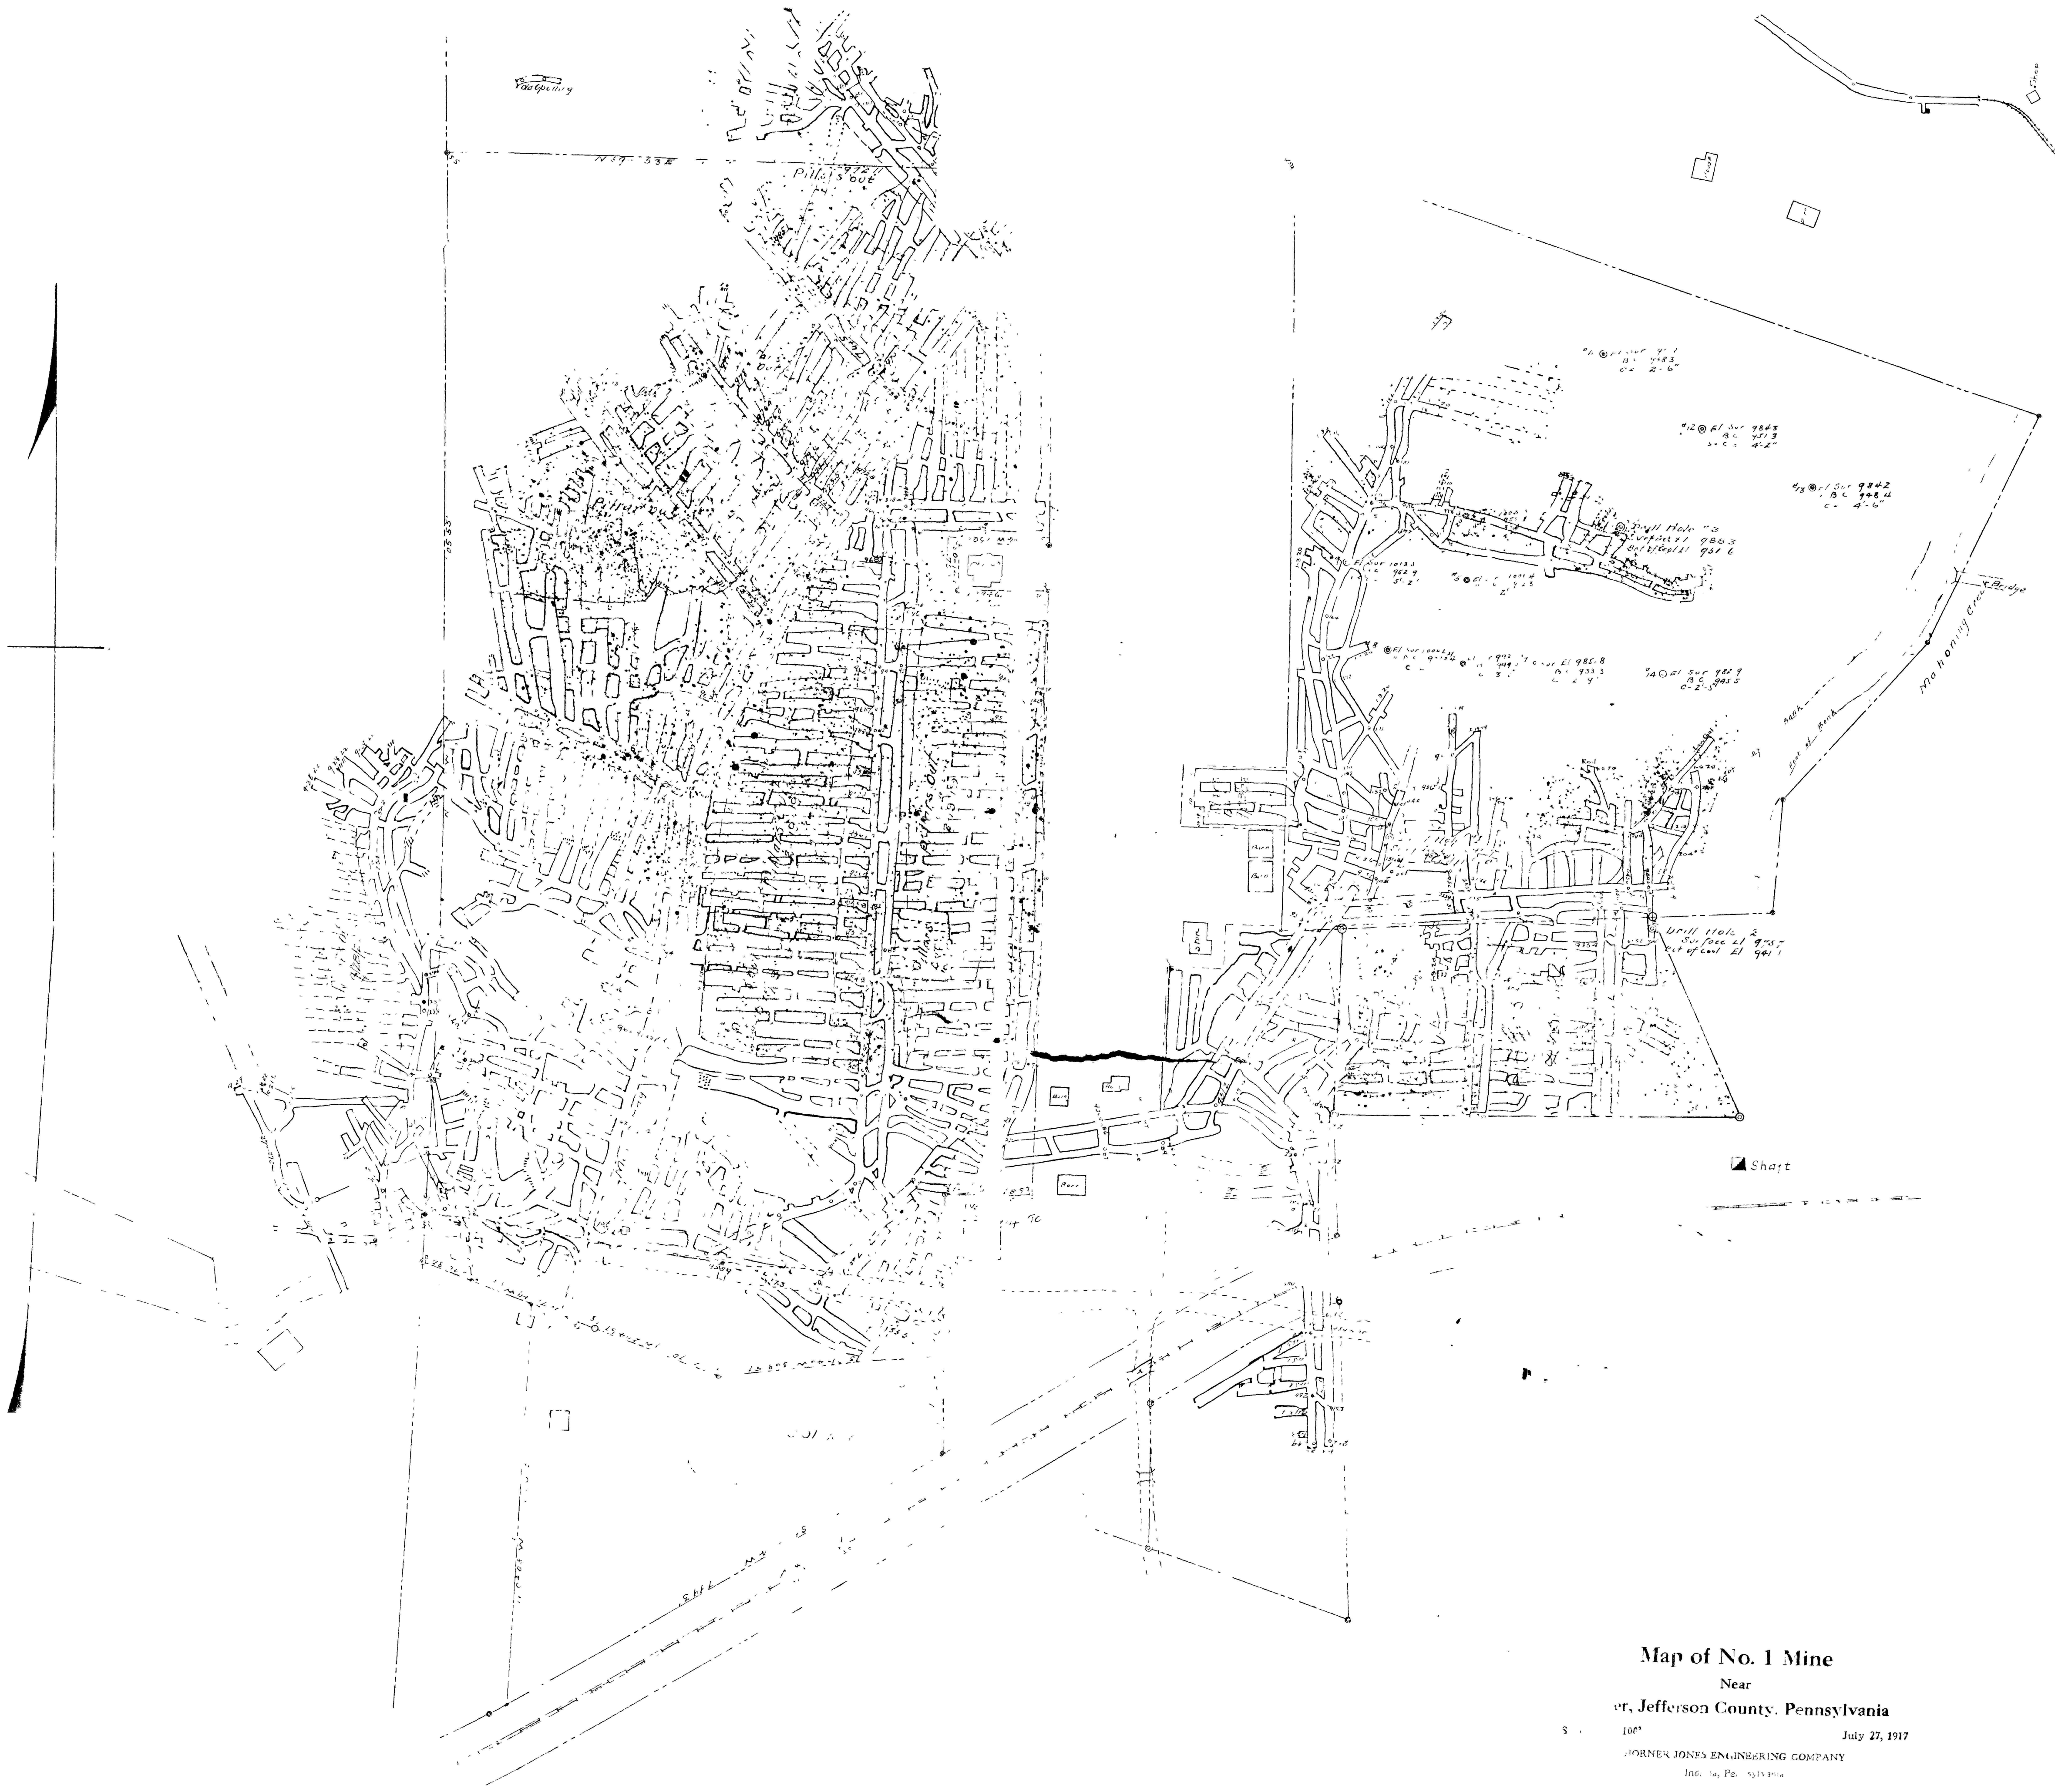

Map of No. 1 Mine
Near
Jefferson County, Pennsylvania