


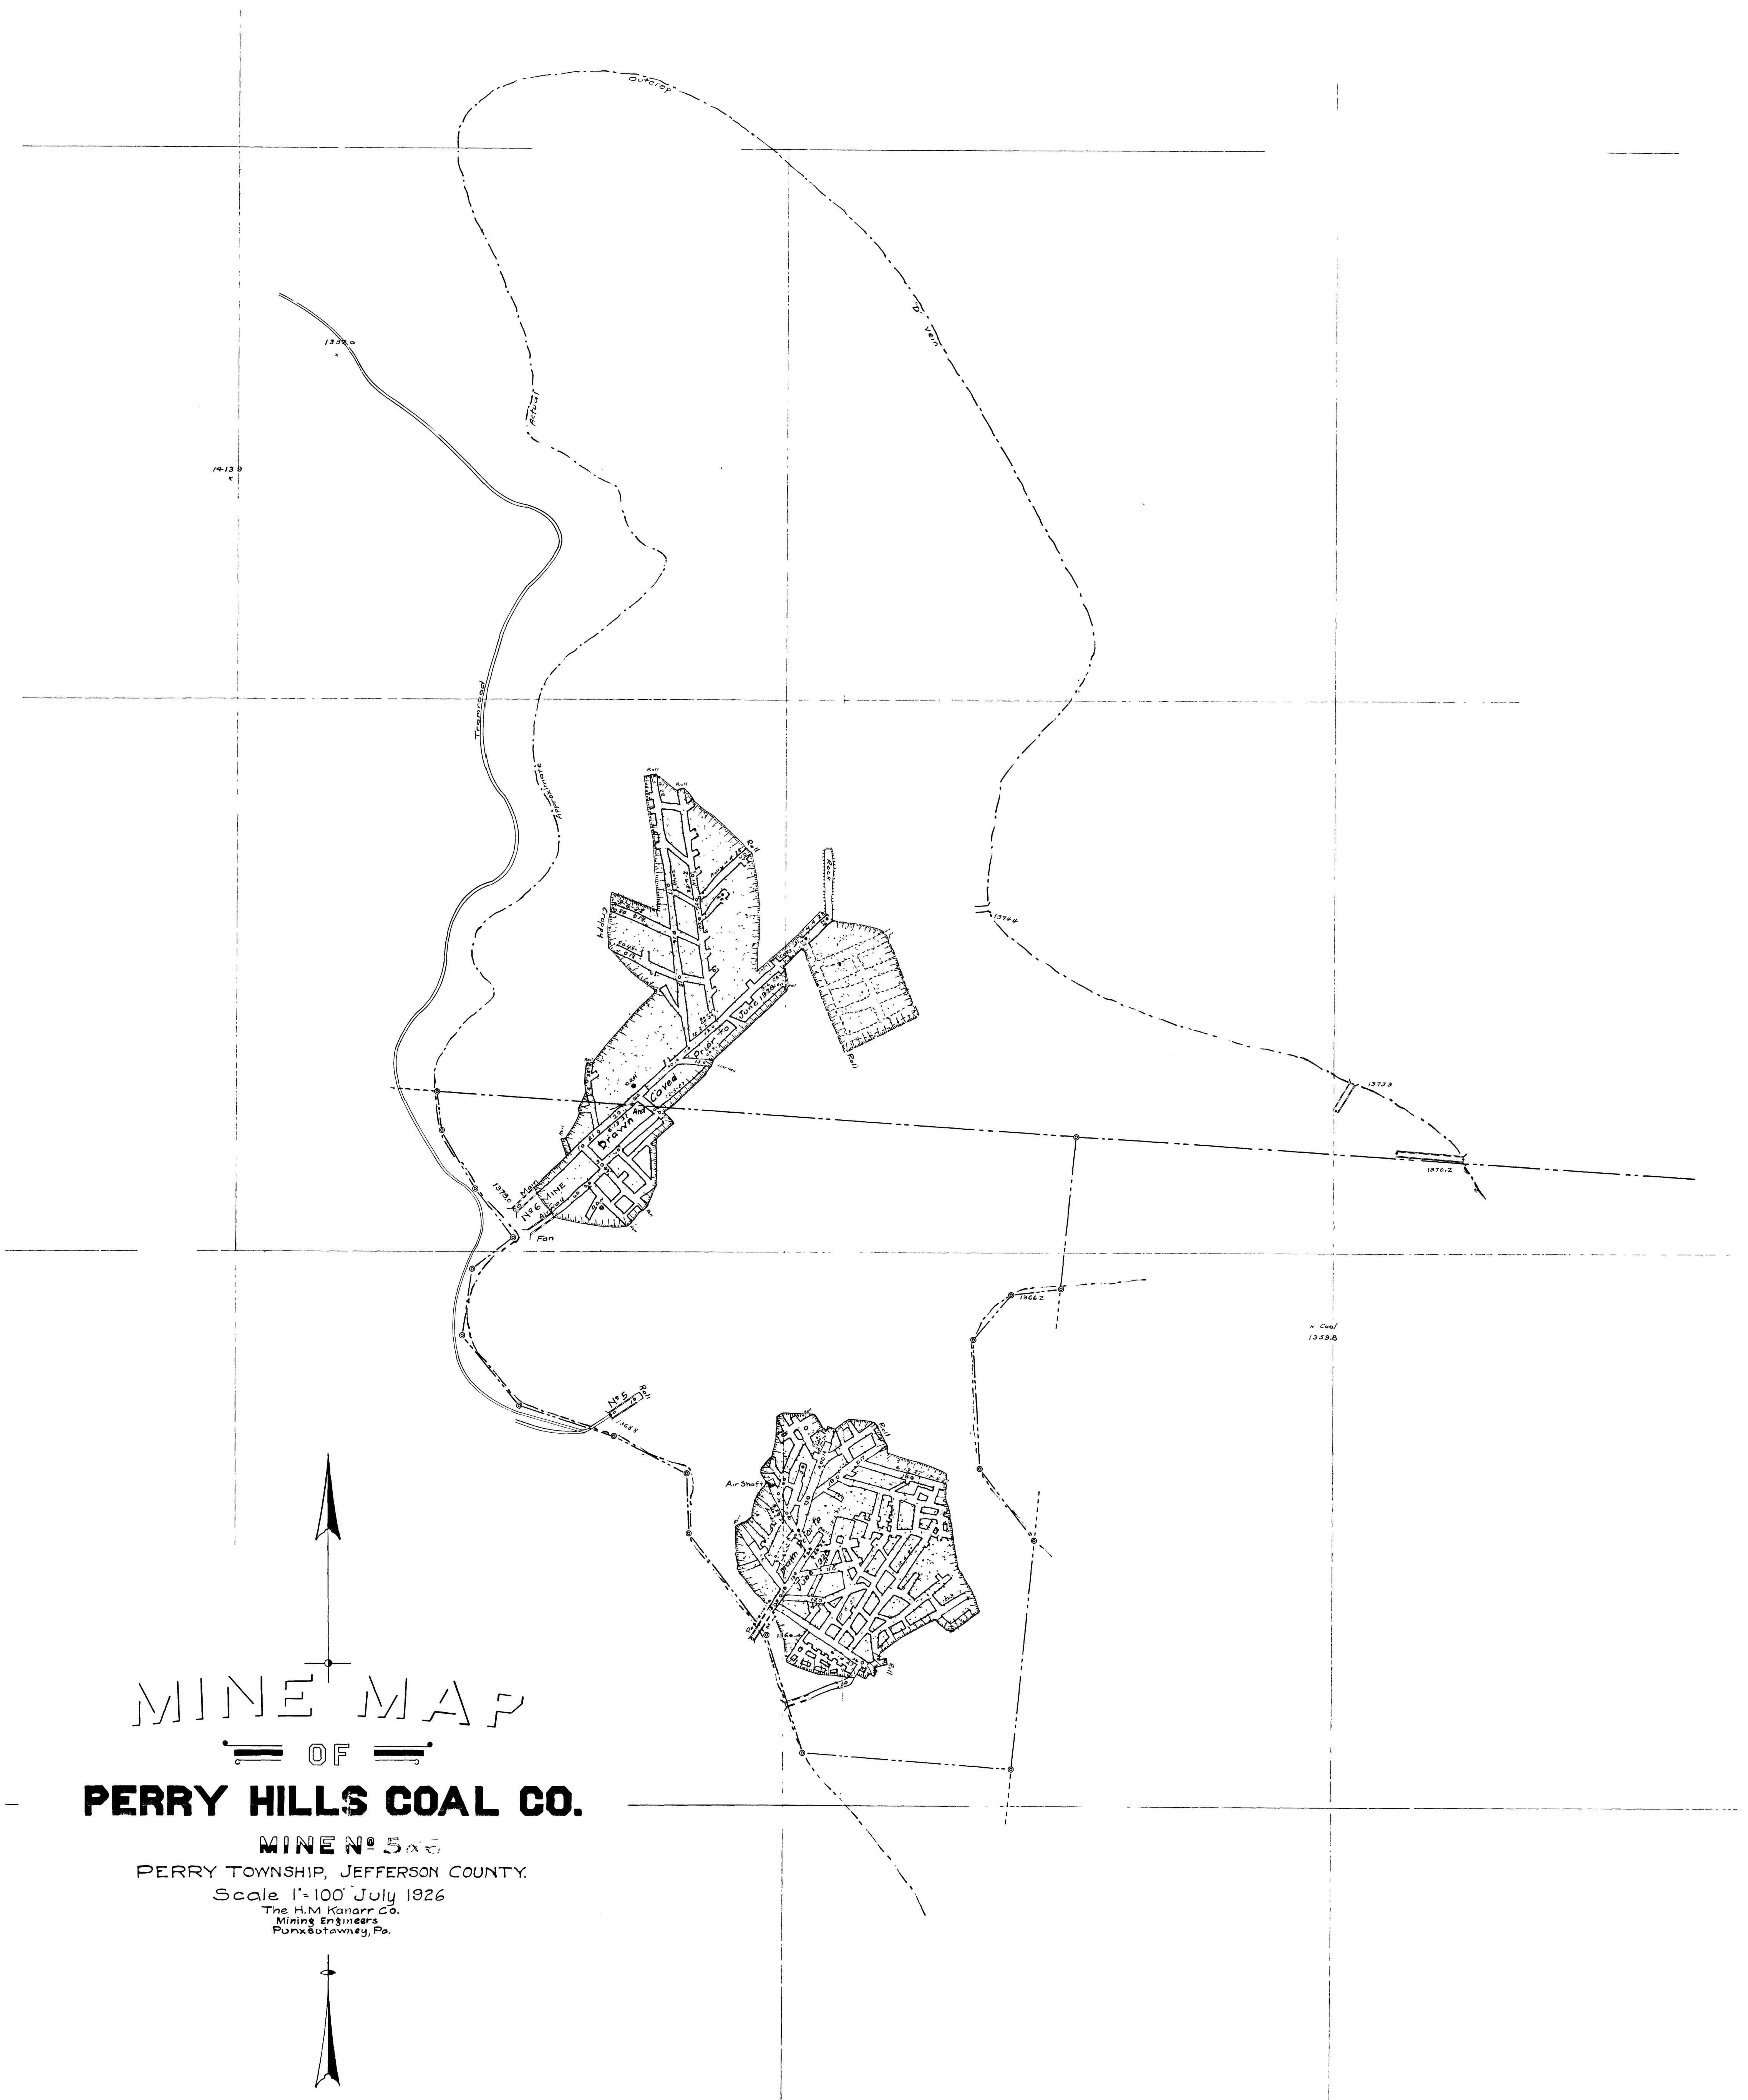

MINE MAP
OF

PERRY HILLS COAL CO.

MINE NO 5 & 6
PERRY TOWNSHIP, JEFFERSON COUNTY.
Scale 1"=100' July 1926
The H.M. Kanarr Co.
Mining Engineers
Punxsutawney, Pa.