

71A. PROPOSED LEASE AREA 4,508.1 AC.

RAMBER PILLAR TO REMAIN 1,819 AC.

36% RECOVERABLE COAL 23,068 AC.

STEP NO. 1 - ADVANCE HEADINGS TO ROSEDALE COAL

STEP NO. 2 - DEplete COAL EAST OF ADVANCE HEADINGS

STEP NO. 3 - COMPLETE UNMINED COAL, ROSEDALE PROPERTY

STEP NO. 4 - PETTIE COAL, WEST OF ADVANCE HEADINGS

NOTE: THIS STUDY OF THE

WAS APPROVED 7-24-07

N 10° 48' 00" E

101

BARBIE

3-15-74

14-01-6

3-15-74

9-22-74

9-22-74

PETTIE BROS. COAL CO.
36 COALS
FINAL MINE MAP

N

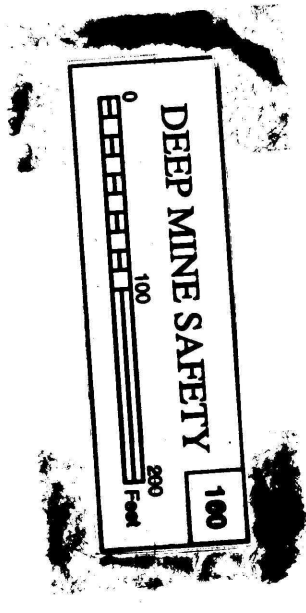

Boysen

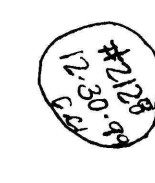

Next to the town of The Ridge
about 10 miles N.W. of

COMP. RESERVE

SEWICKLEY

SEWICKLEY

Distance Left Company

25000