


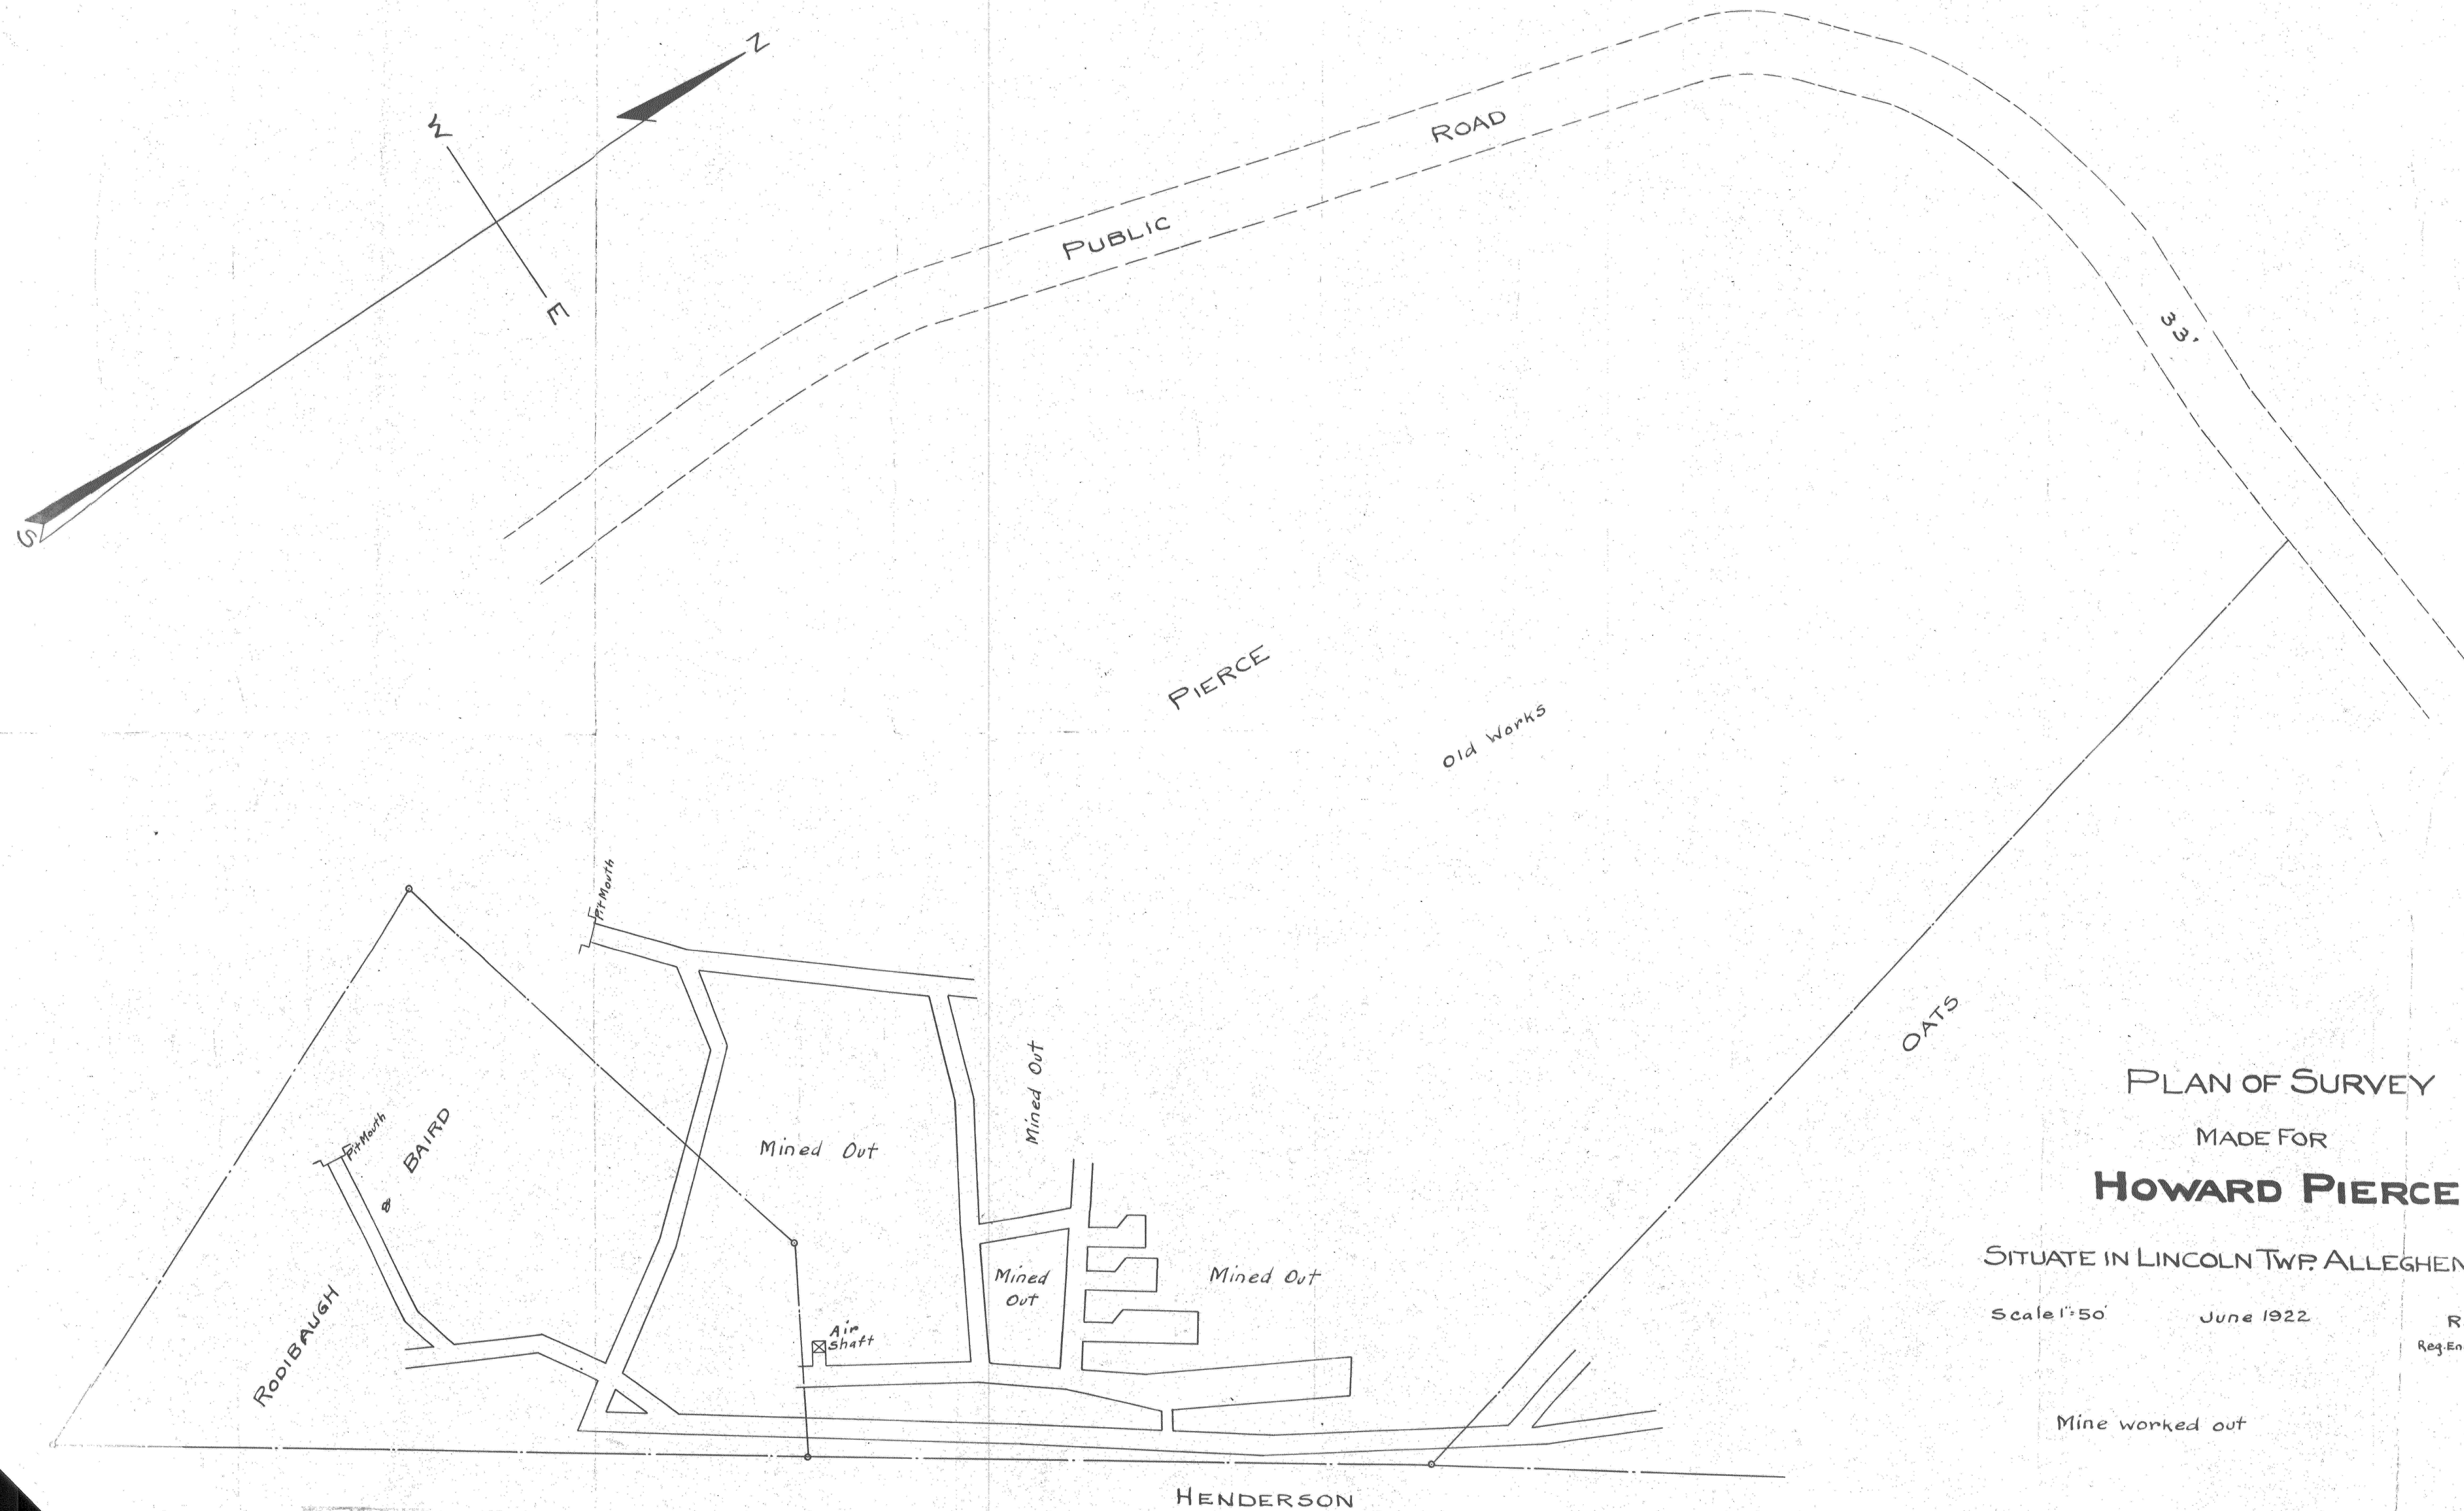

PLAN OF SURVEY

MADE FOR

HOWARD PIERCE

SITUATE IN LINCOLN TWP. ALLEGHENY CO. PA.

Scale 1"=50'

June 1922

R. C. Bayne
Reg. Eng. & Surveyor

Mine worked out