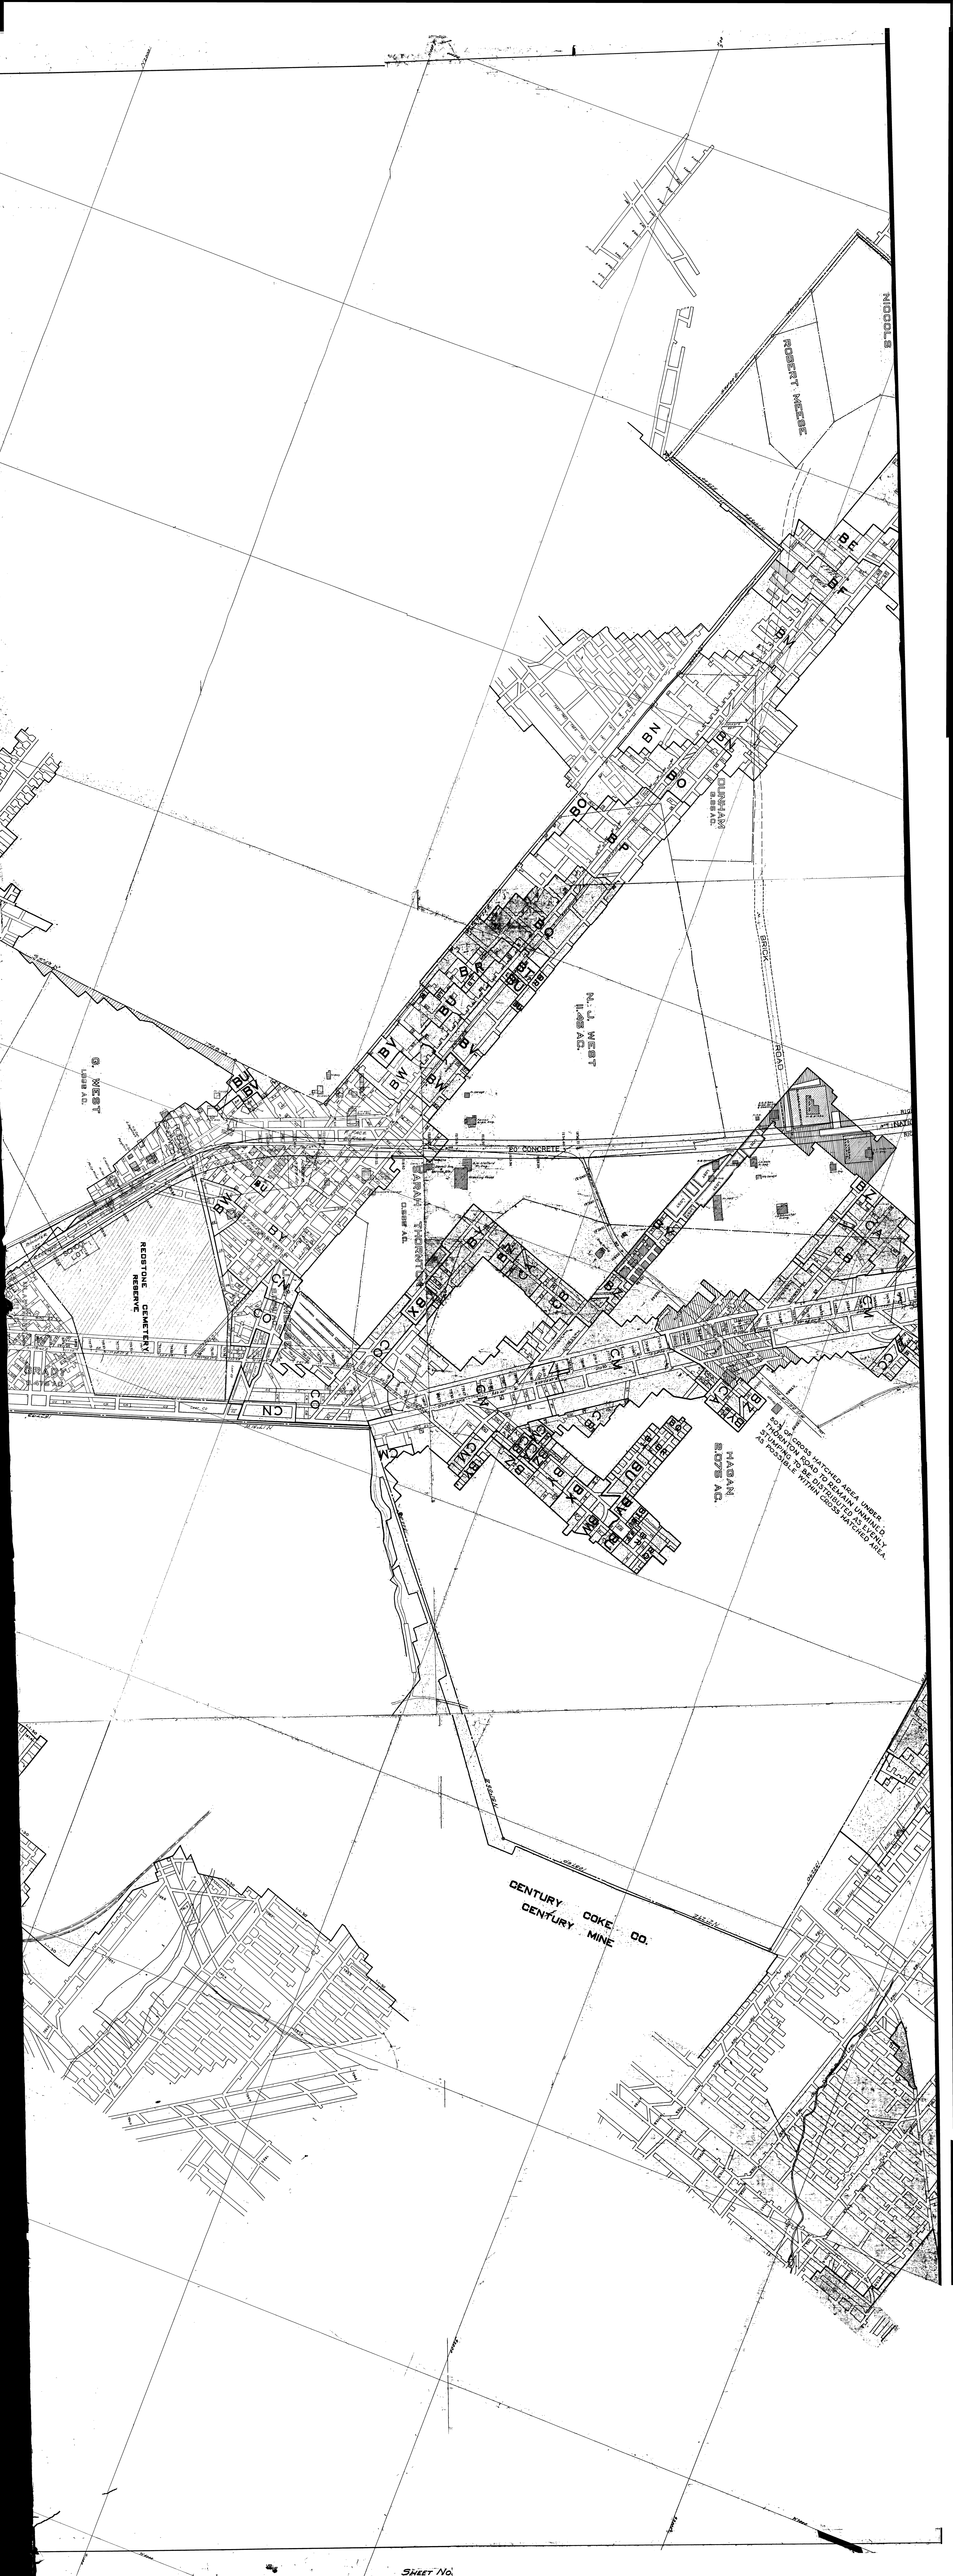

SHEET NO.
CENTURY COKE CO.
CENTURY MINE
HAGAN
2.075 AC.
5.0% OF CROSS HATCHED AREA UNDER THORNTON ROAD TO REMAIN UNMINED. STUMPING TO BE DISTRIBUTED AS EVENLY AS POSSIBLE WITHIN CROSS HATCHED AREA.
SARAH THORNTON
0.588 AC.
J. WEST
REDSTONE CEMETERY
RESERVE
SCHOOL LOT
N. J. WEST
11.46 AC.
G. WEST
1.668 AC.
CONCRETE
BRICK ROAD
DUNHAM
3.95 AC.
ROBERT MEESE
NICCOLS
CN
CO
CM
BX
BY
BZ
BU
BV
BW
CA
CB
CC
BR
BT
BS
BP
BO
BN
BM
BL
BQ
BK
LOST