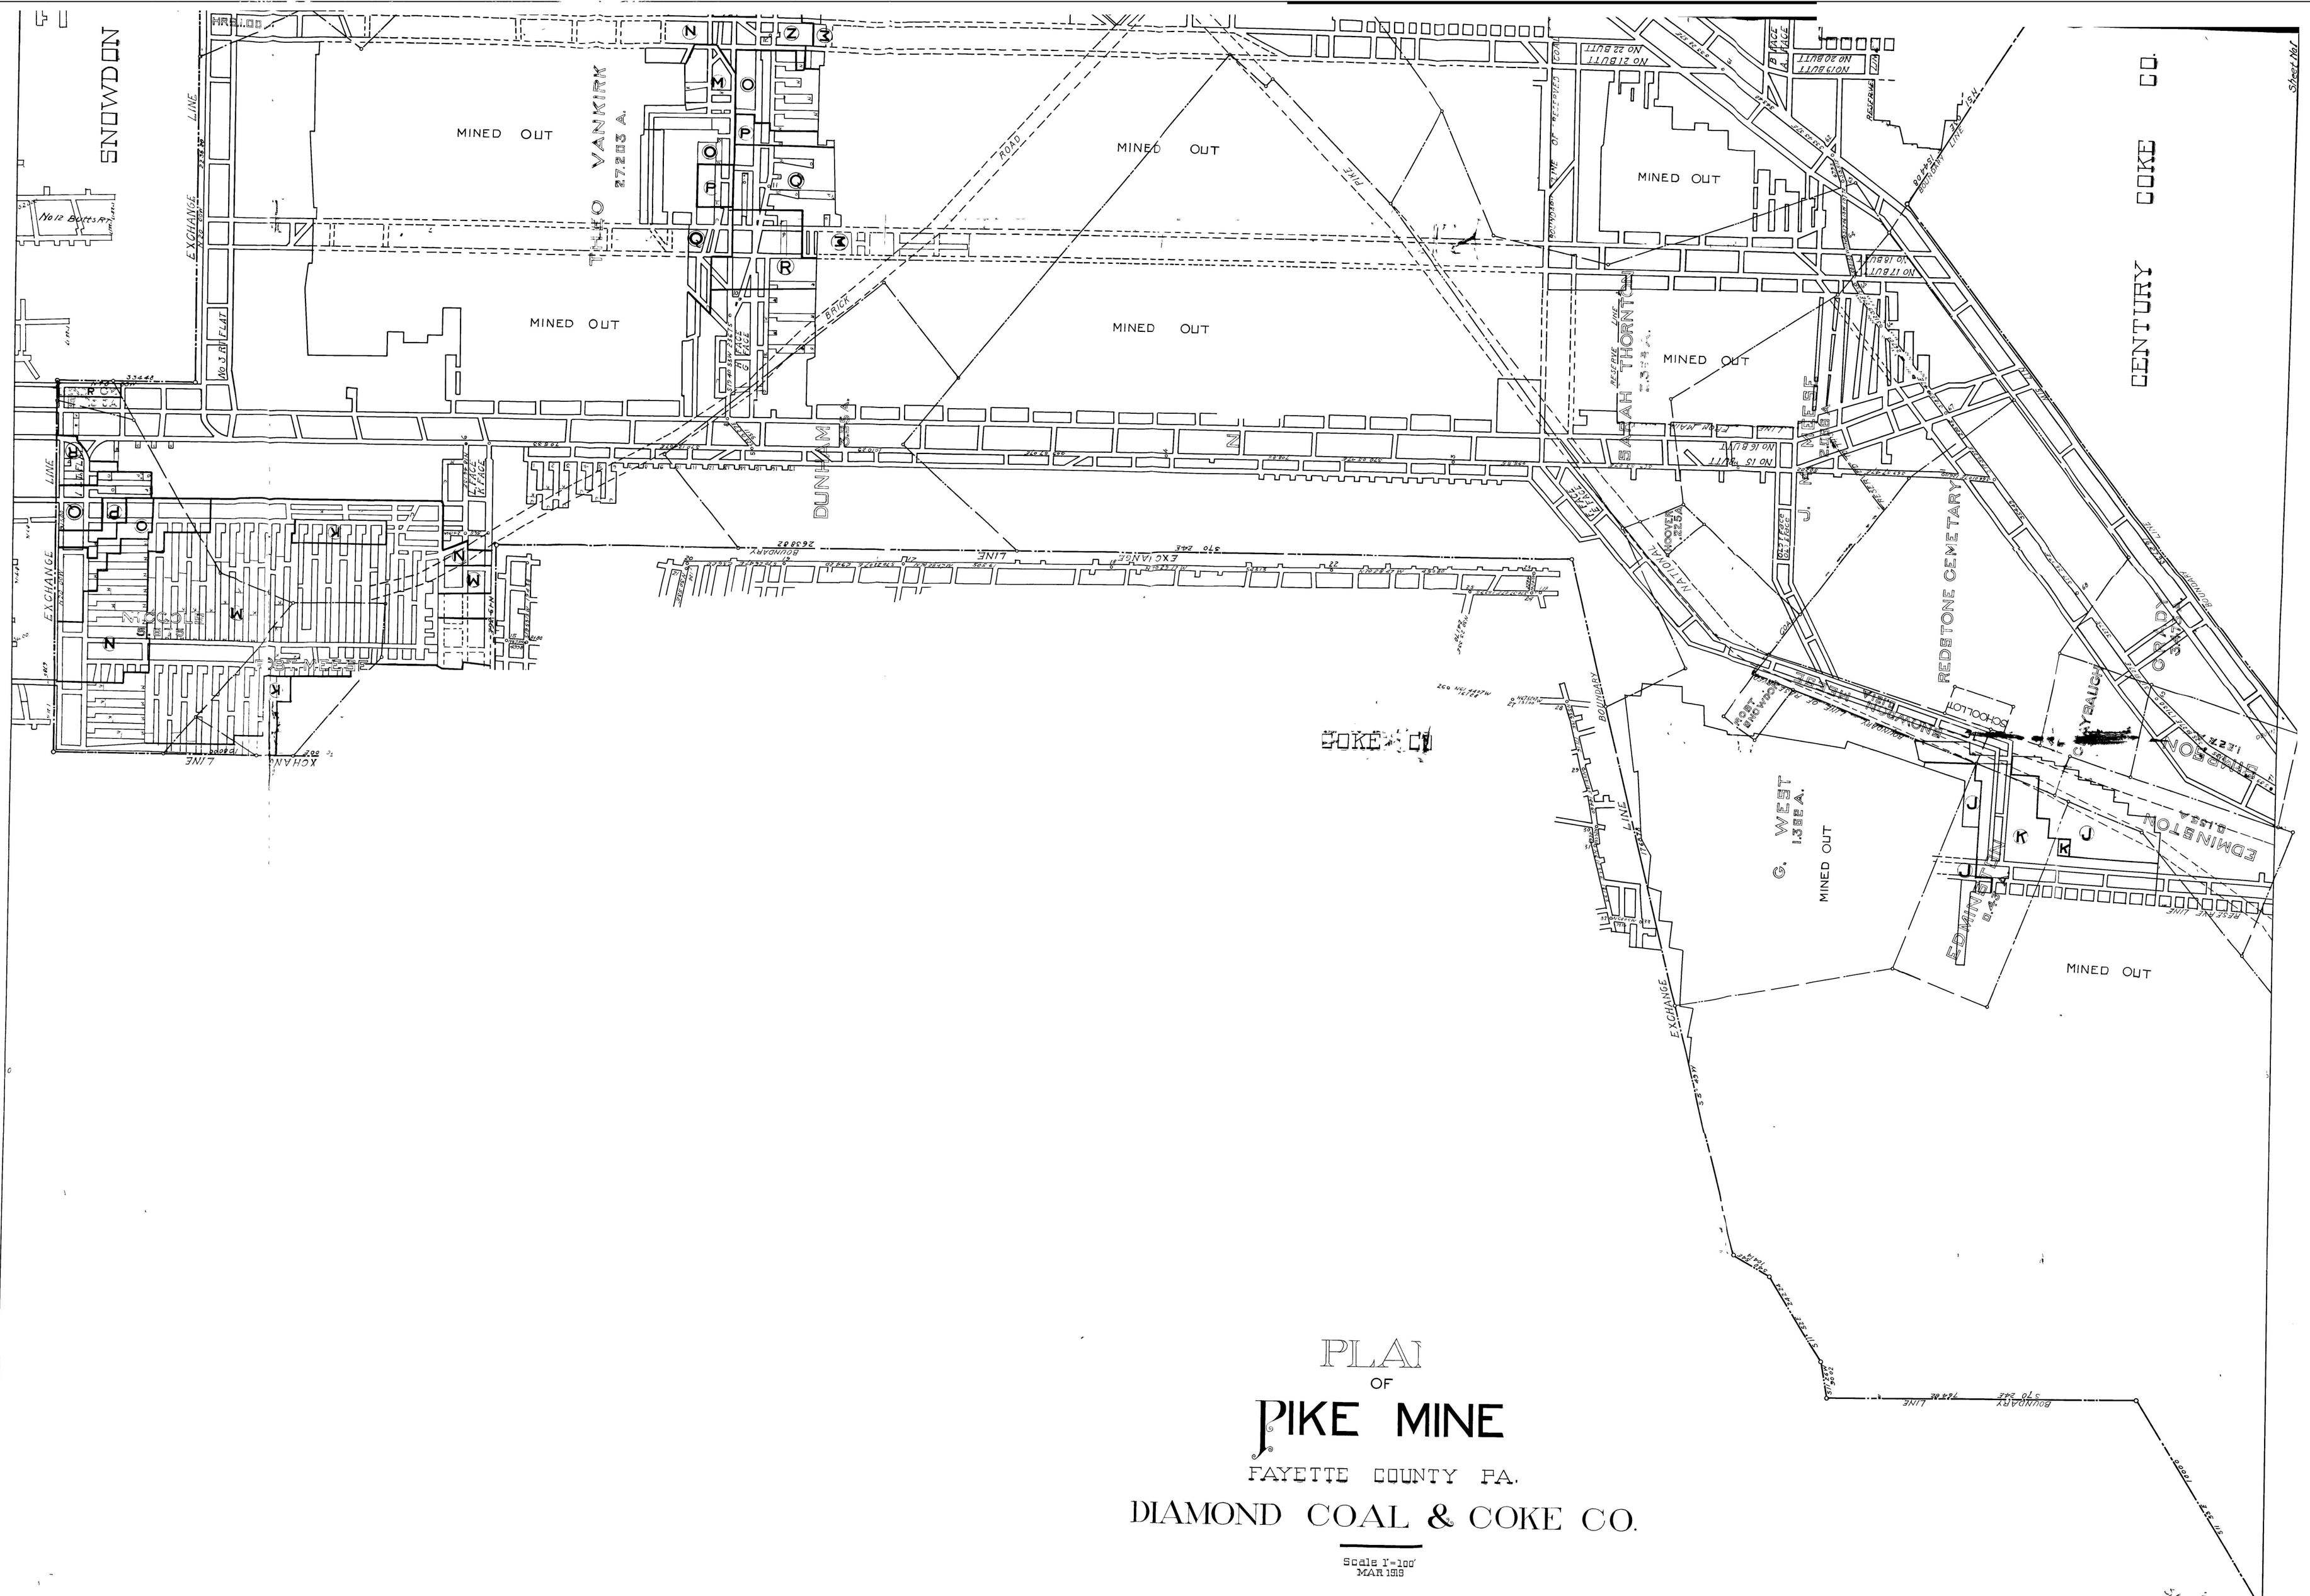

PLAN OF PIKE MINE

FAYETTE COUNTY PA.

DIAMOND COAL & COKE CO.

Scale 1"=100'
MAR 1918