


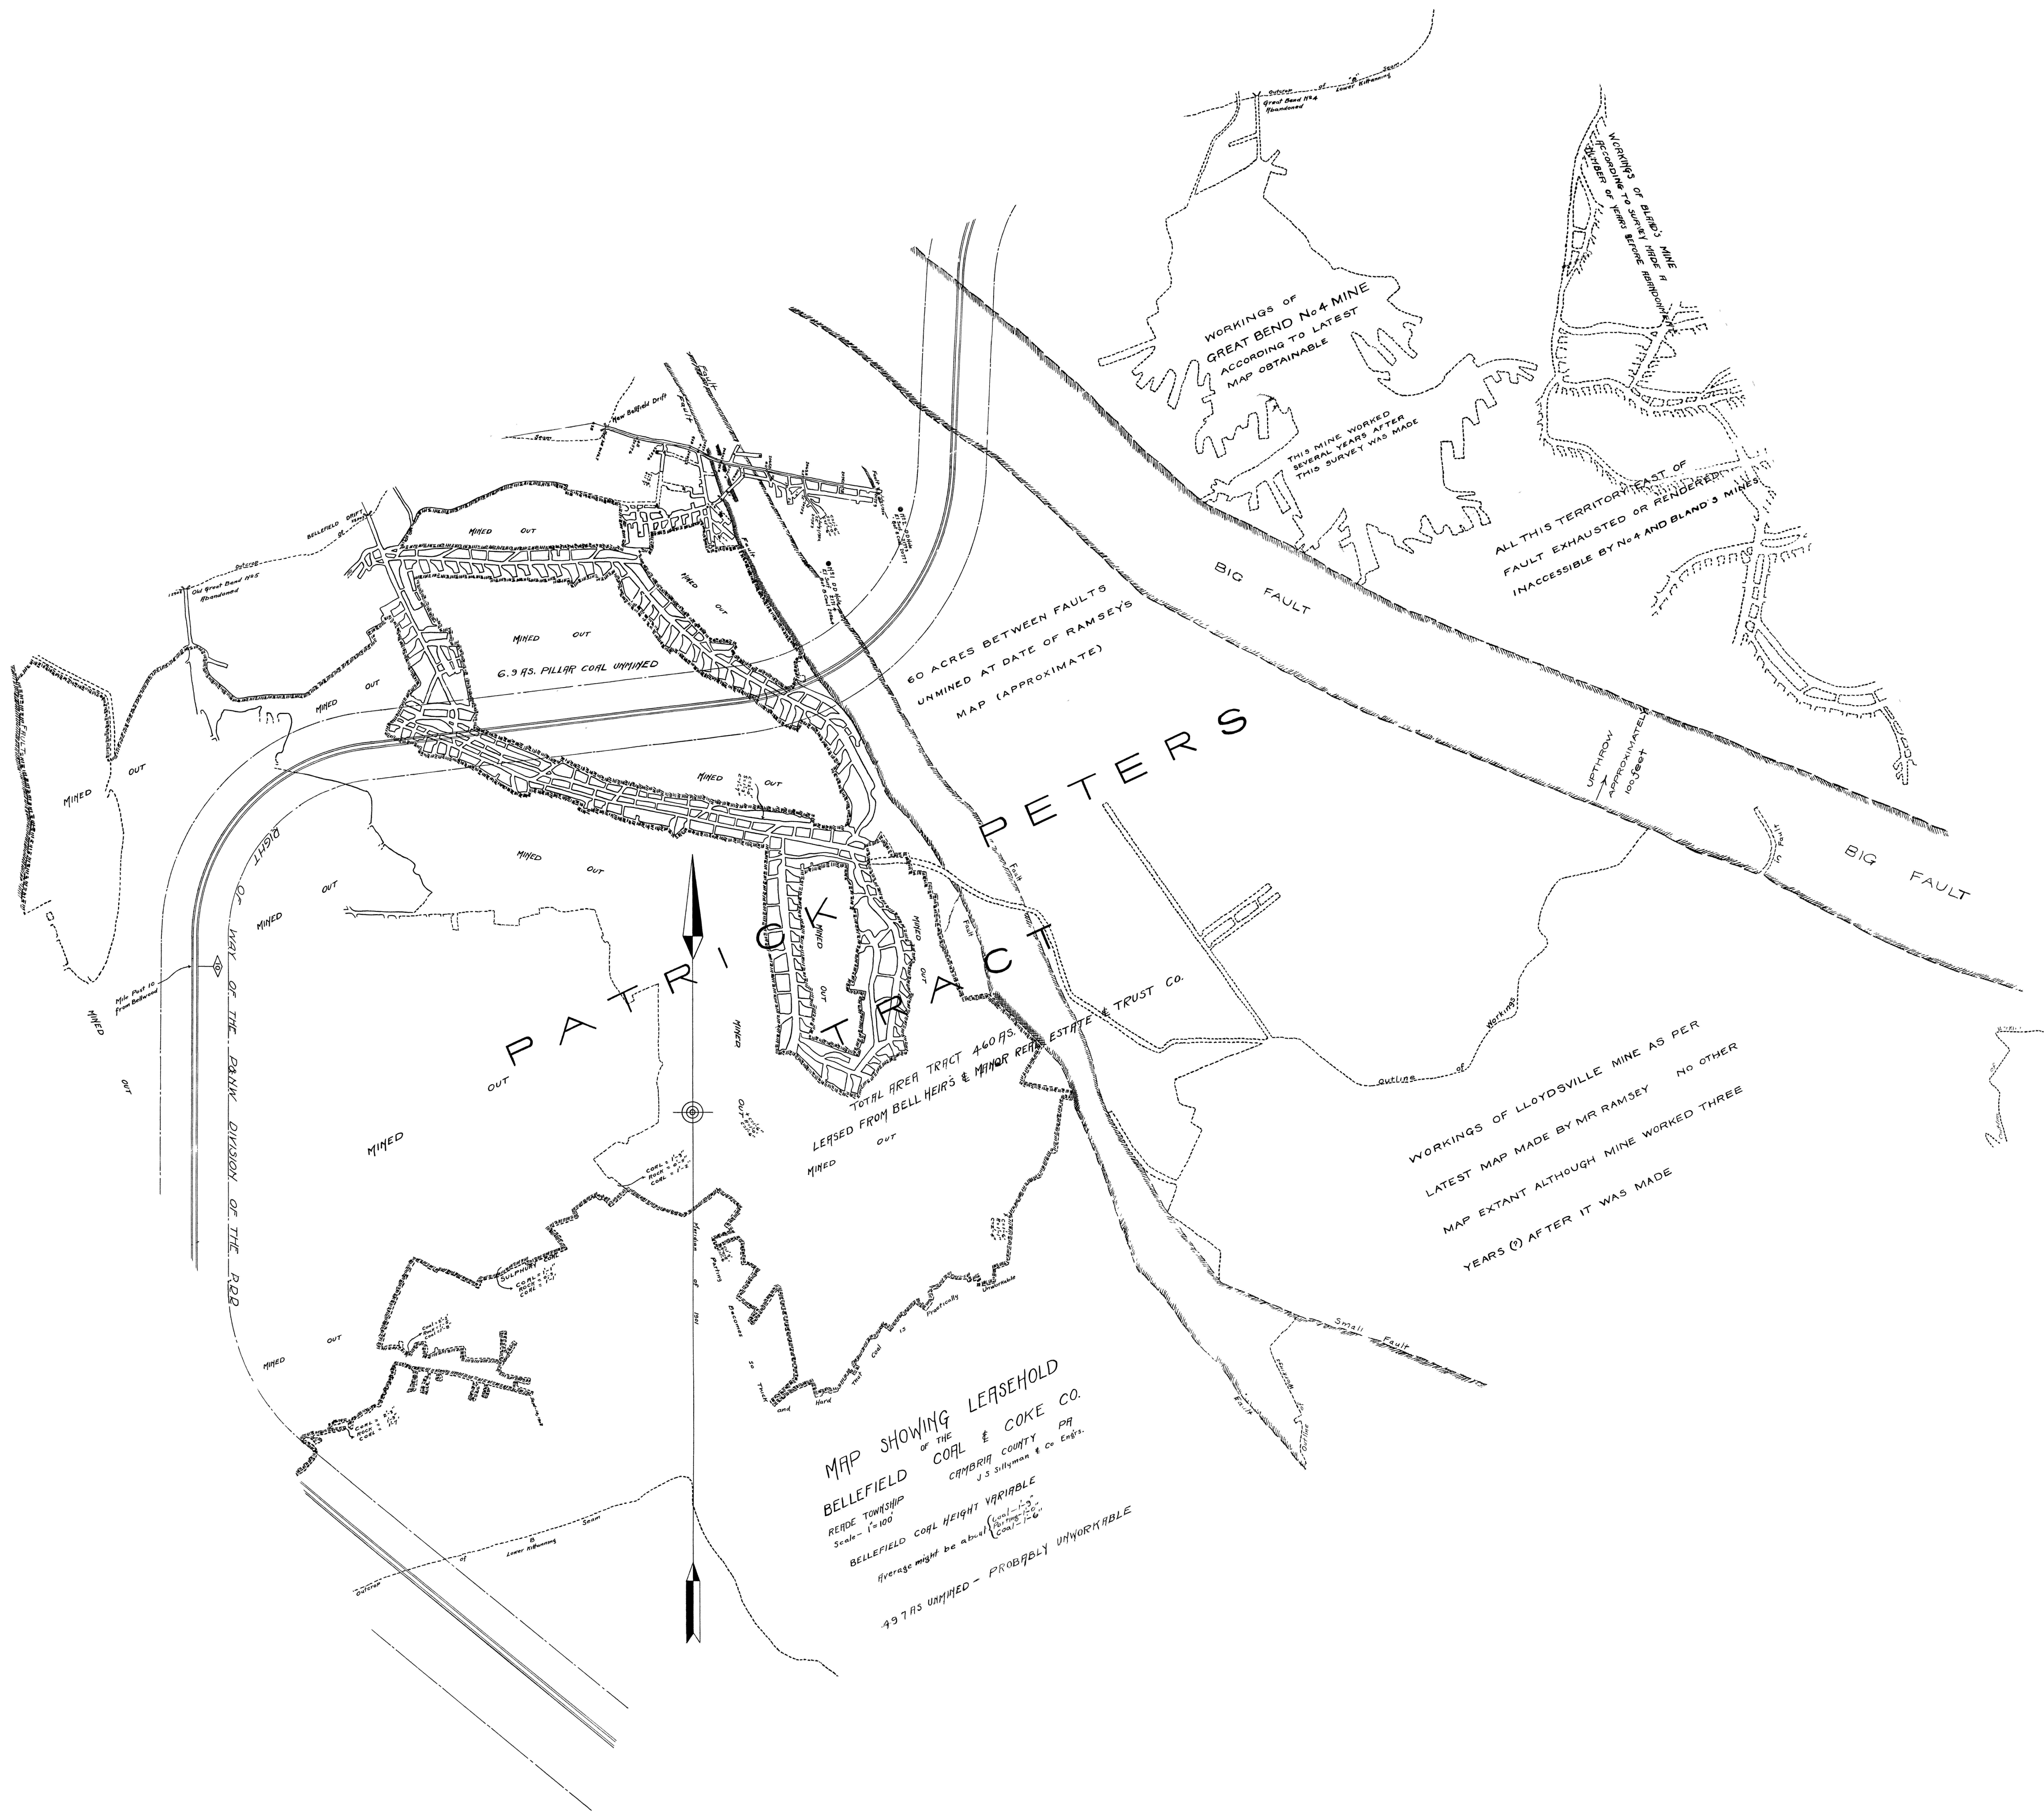

MAP SHOWING LEASEHOLD
OF THE BELLEFIELD COAL & COKE CO.
CAMBRIA COUNTY PA.
J. S. Silliman & Co. Eng'rs.
READE TOWNSHIP
Scale - 1"=100'
BELLEFIELD COAL HEIGHT VARIABLE
Average might be about 10' (Coal 1-15'
16-20')
497 AS UNMINED - PROBABLY UNWORKABLE

WORKINGS OF
GREAT BEND No. 4 MINE
ACCORDING TO LATEST
MAP OBTAINABLE

THIS MINE WORKED
SEVERAL YEARS AFTER
THIS SURVEY WAS MADE

ALL THIS TERRITORY EAST OF
FAULT EXHAUSTED OR RENDERED
INACCESSIBLE BY No. 4 AND BLAND'S MINES

60 ACRES BETWEEN FAULTS
UNMINED AT DATE OF RAMSEY'S
MAP (APPROXIMATE)

PATRICK TRACT

TOTAL AREA TRACT 460 AS.
LEASED FROM BELL HEIR'S & MAJOR REAL ESTATE & TRUST CO.

WORKINGS OF LLOYDSVILLE MINE AS PER
LATEST MAP MADE BY MR RAMSEY NO OTHER
MAP EXTANT ALTHOUGH MINE WORKED THREE
YEARS (?) AFTER IT WAS MADE

RIGHT OF WAY OF THE B&O DIVISION OF THE R.R.

BIG FAULT

BIG FAULT

Small Fault

UPTHROW
APPROXIMATELY
100 Feet

