


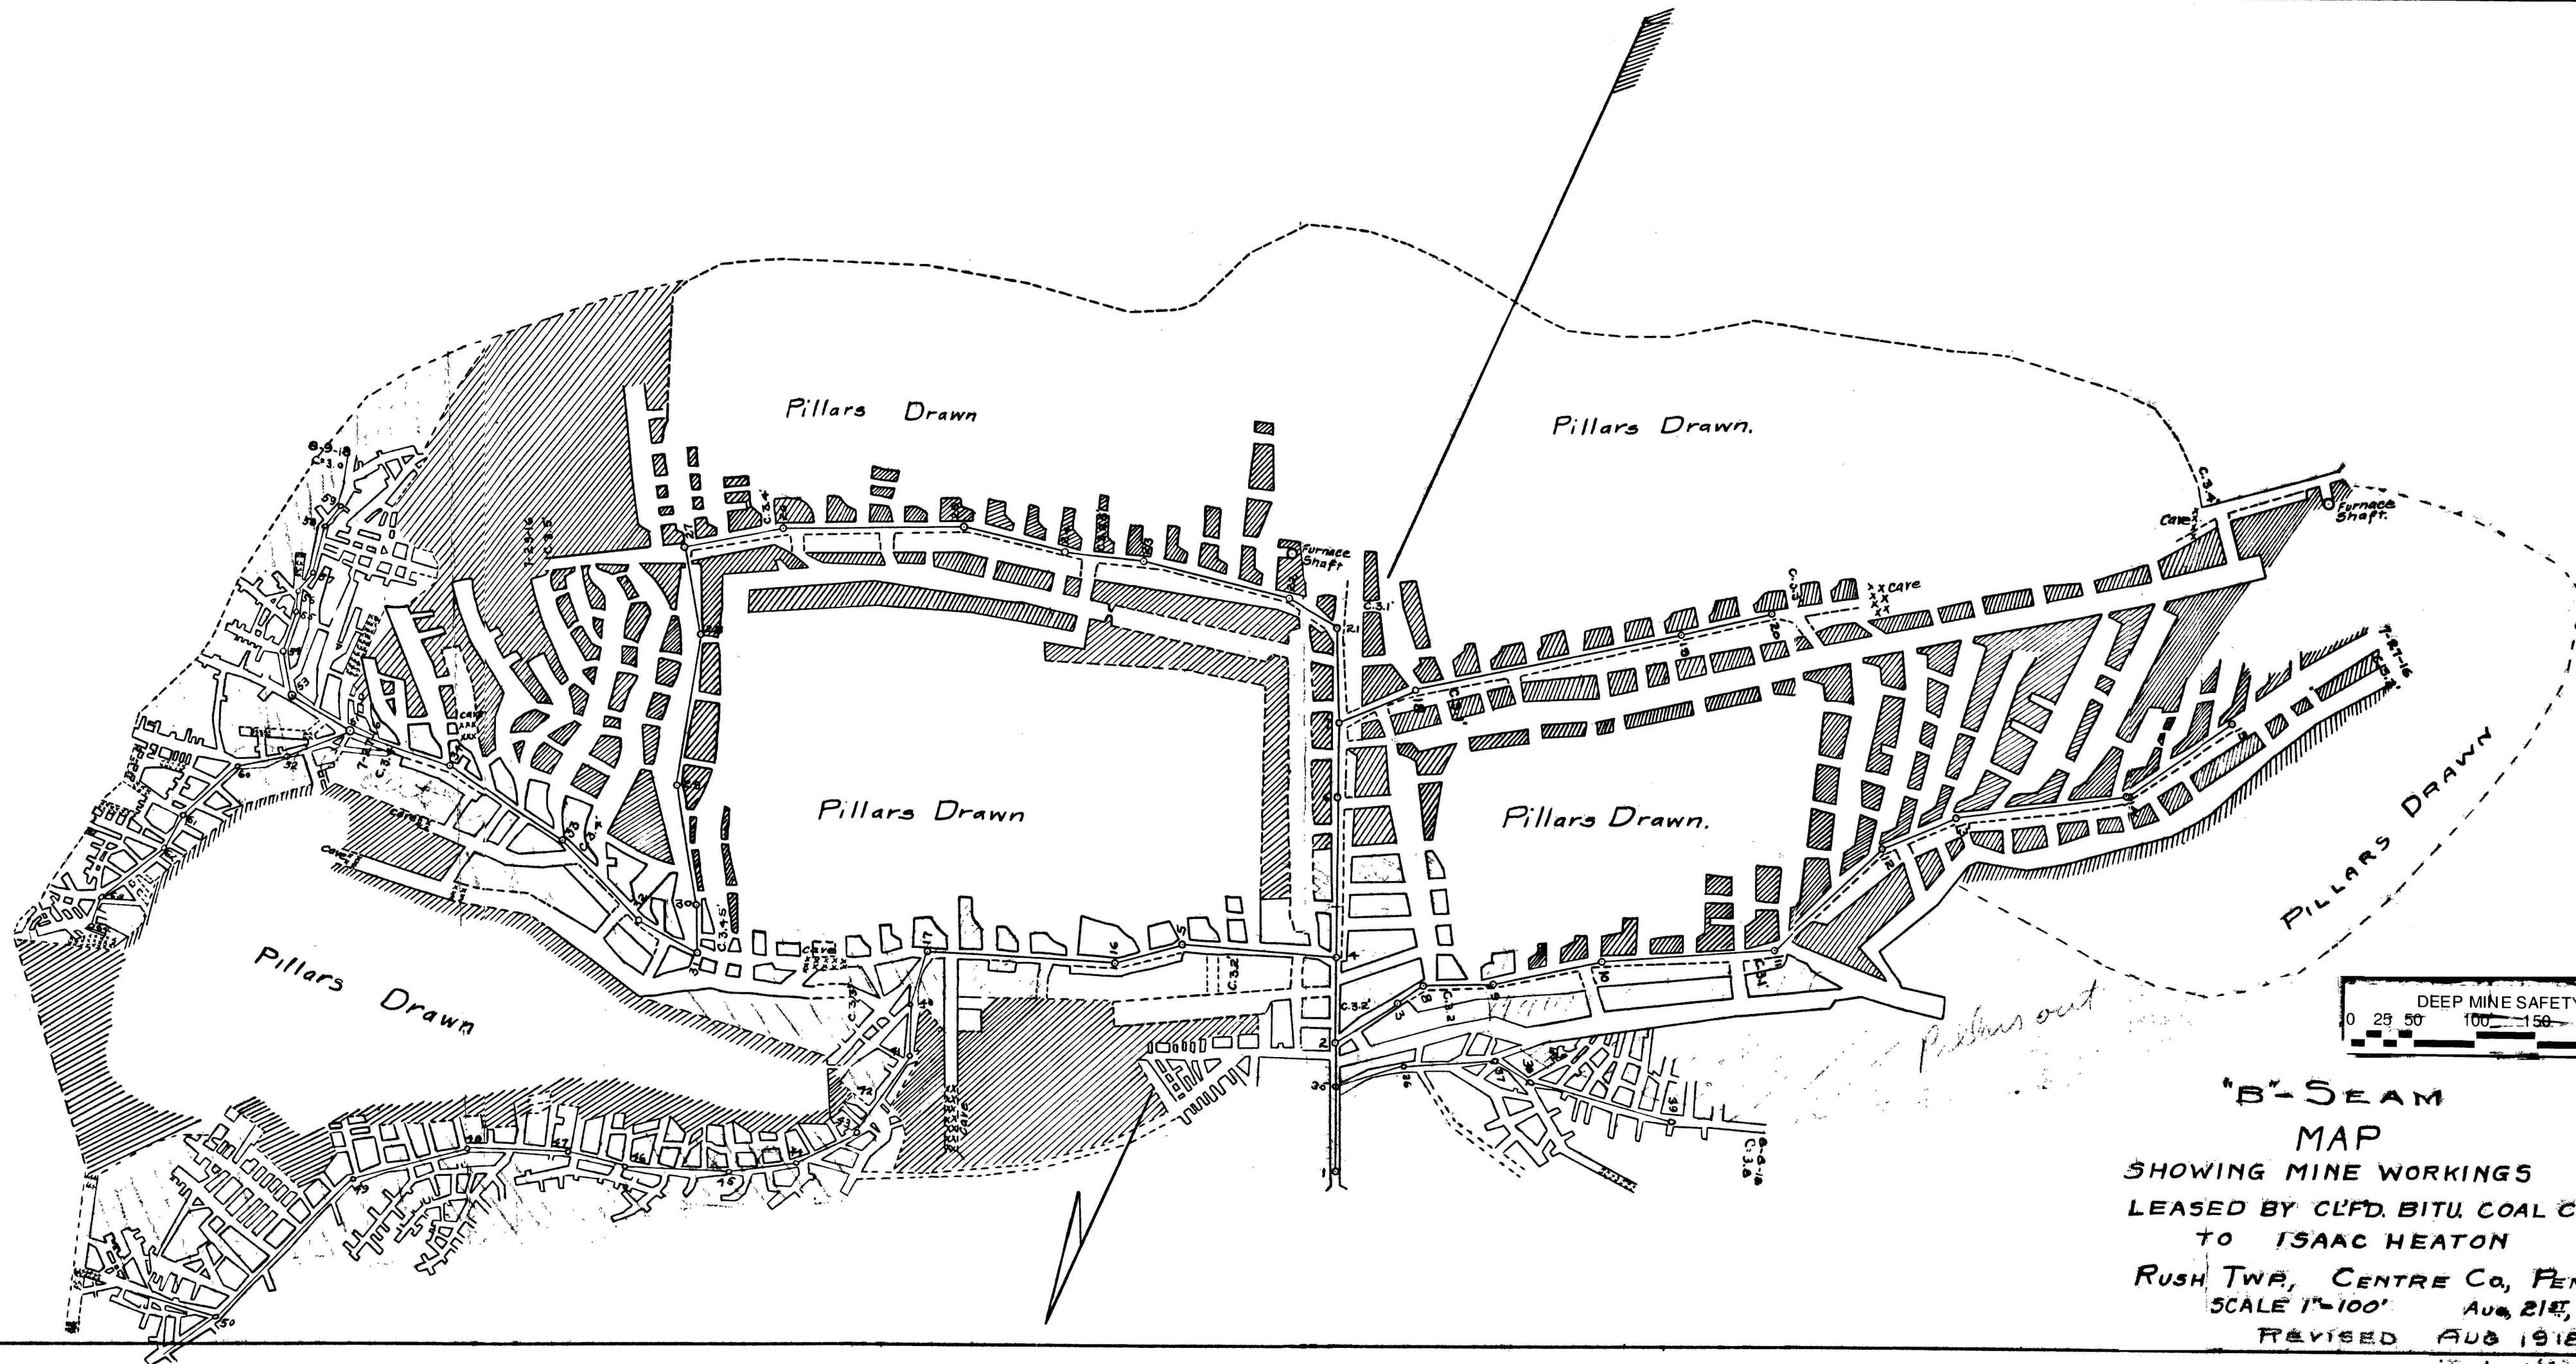

"B" SEAM
MAP
SHOWING MINE WORKINGS
LEASED BY CLFD. BITU. COAL CORPN.
TO ISAAC HEATON
RUSH TWP, CENTRE CO, PENNA.
SCALE 1"=100' AUG 21ST, 1916.
REVISED AUG 1918
JULY 1920