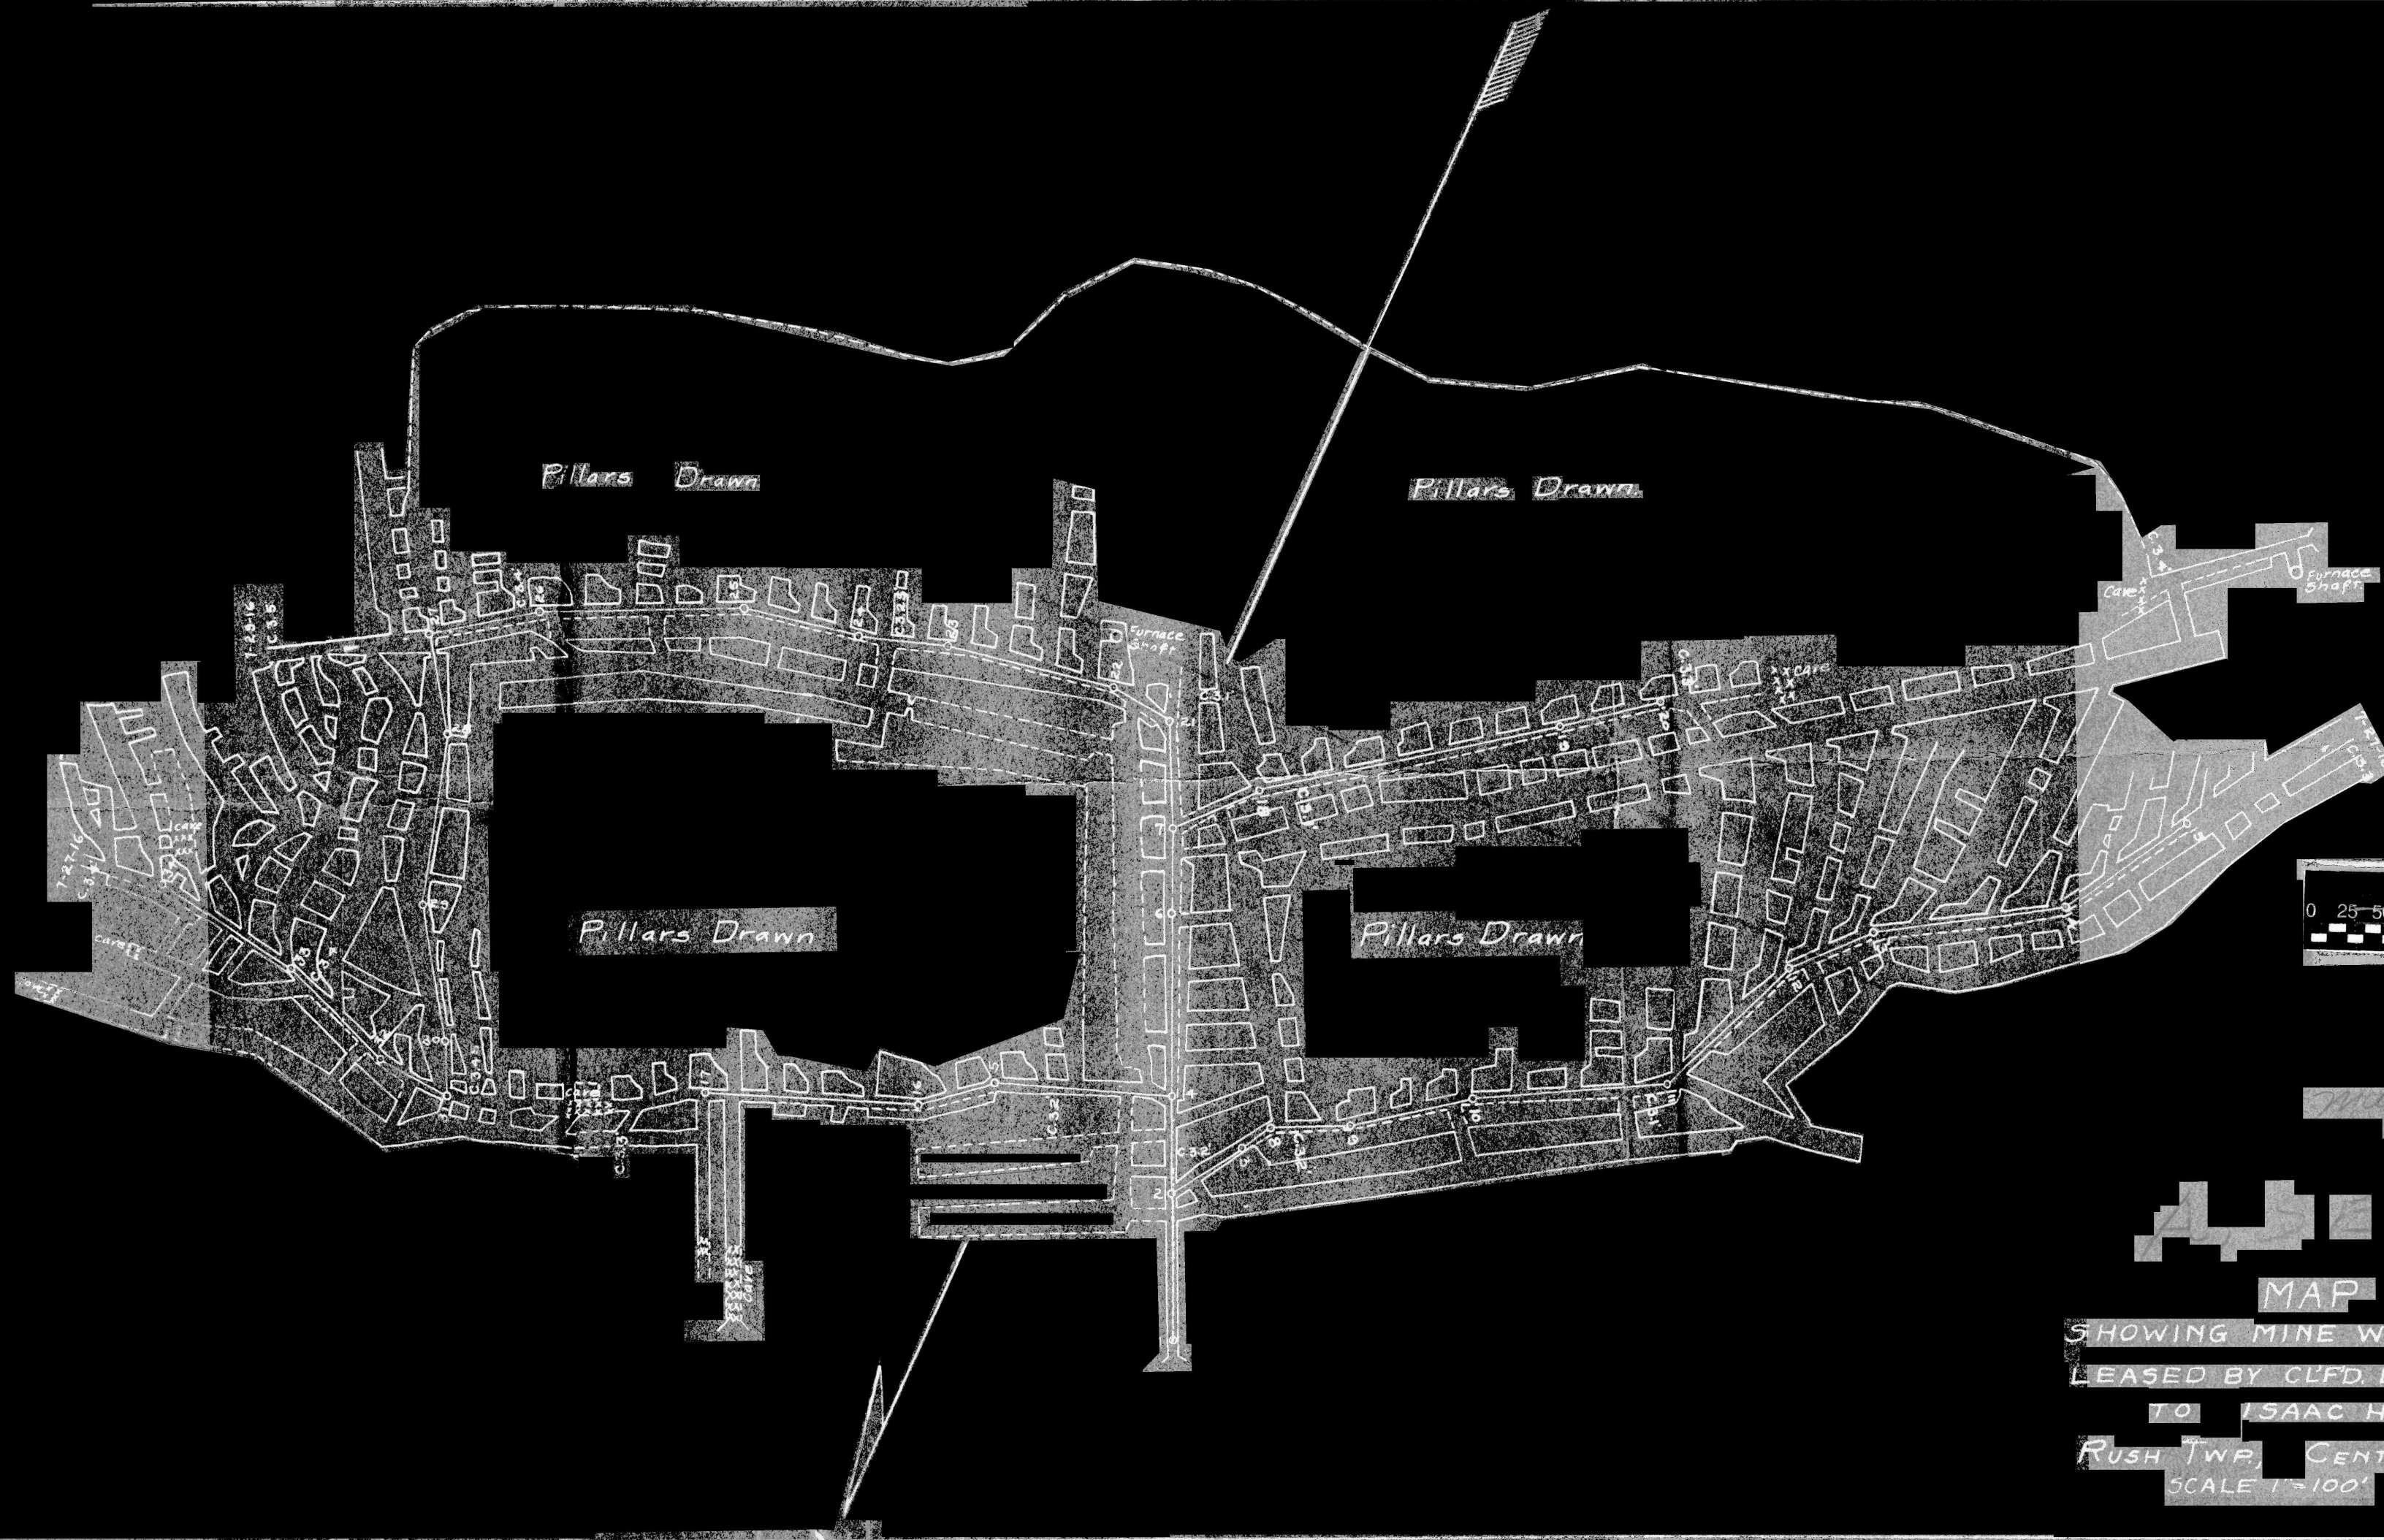


MAP
SHOWING MINE WORKINGS
LEASED BY CLFD. BITU. COAL CORPN.
TO ISAAC HEATON
RUSH TWP., CENTRE CO., PENNA.
SCALE 1"=100'
AUG. 21ST, 1916