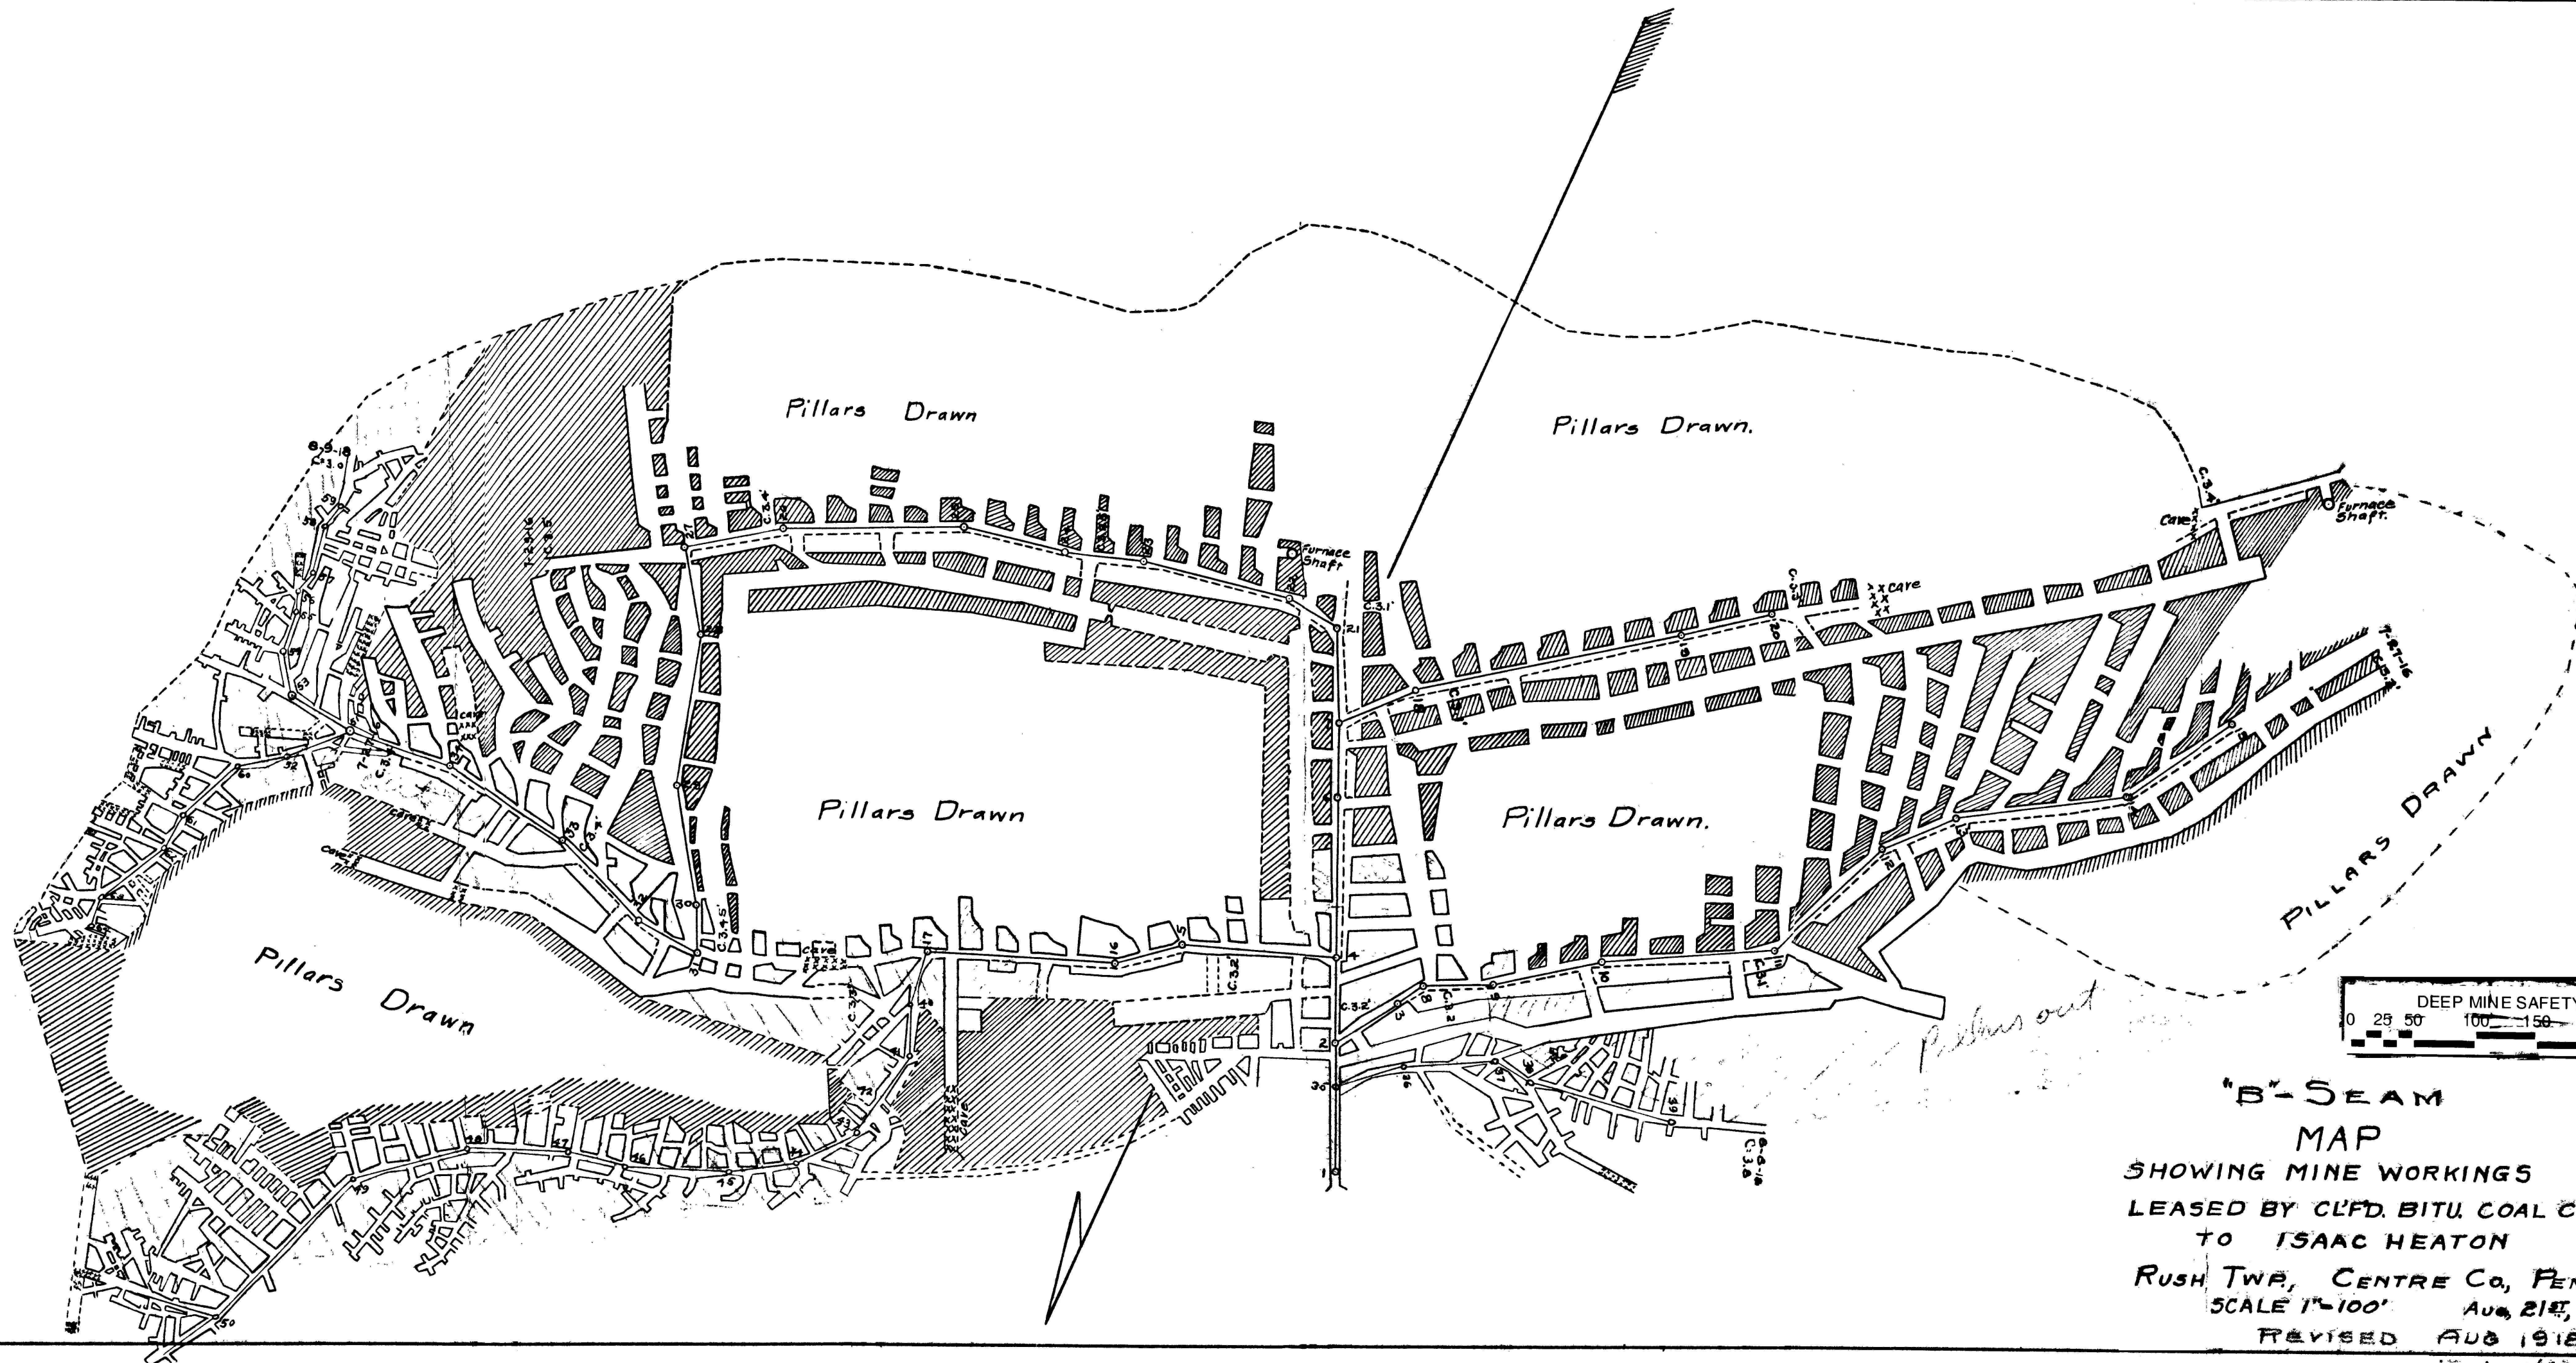


"B"-SEAM
MAP
 SHOWING MINE WORKINGS
 LEASED BY CLFD. BITU. COAL CORPN.
 TO ISAAC HEATON
 RUSH TWP, CENTRE CO, PENNA.
 SCALE 1"=100' AUG 21ST, 1916.
 REVISED AUG 1918
 JULY 1920