


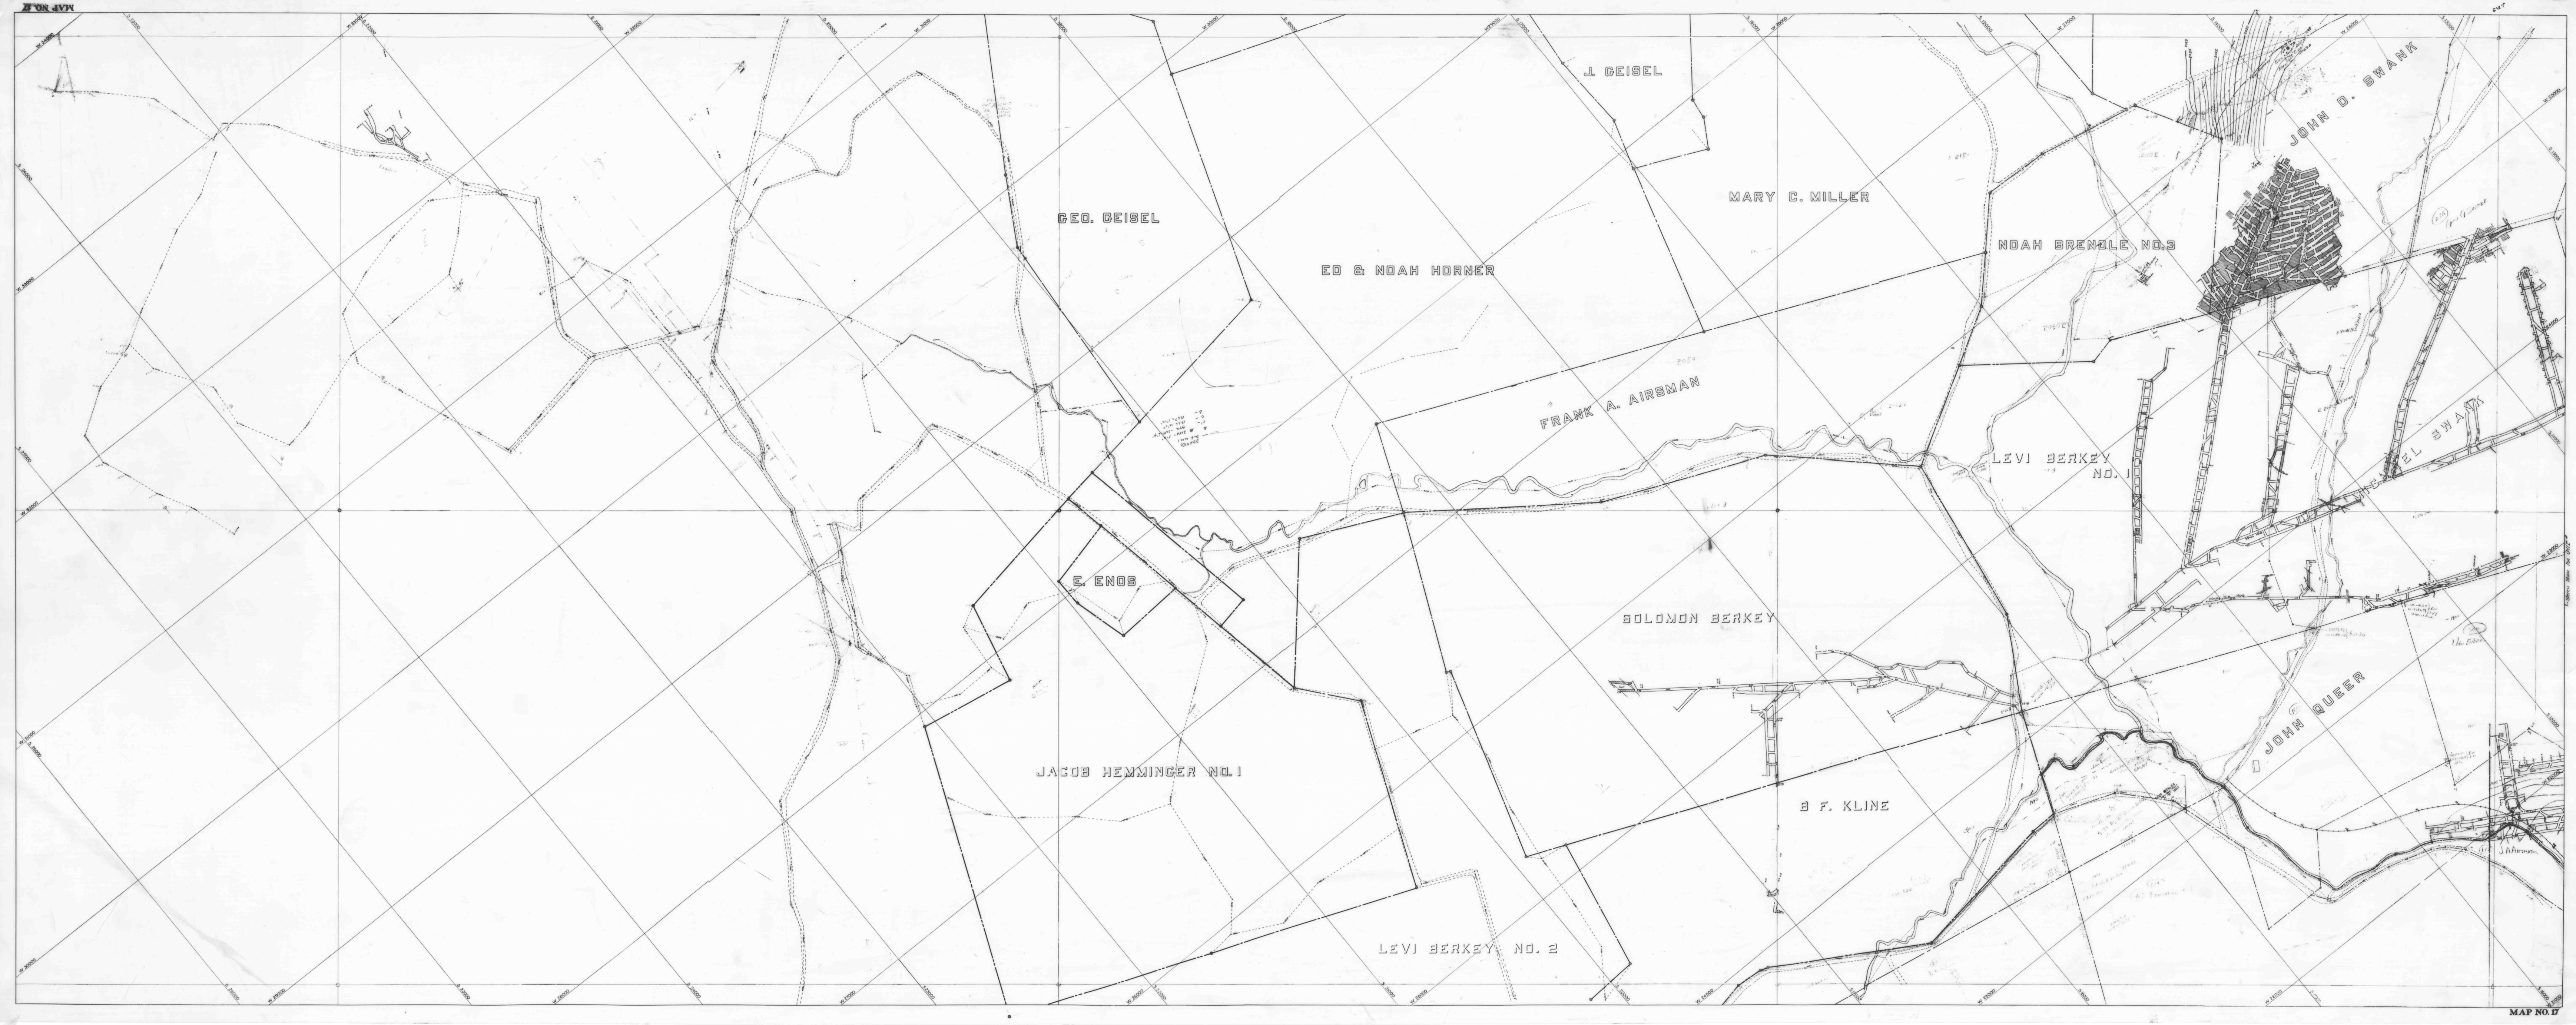

J. GEISEL

GEO. GEISEL

MARY C. MILLER

ED & NOAH HORNER

NOAH BRENDLE NO. 3

JOHN D. SWANK

FRANK A. AIRSMAN

LEVI BERKEY NO. 1


E. ENOS

SOLOMON BERKEY

JACOB HEMMINGER NO. 1

JOHN QUEER

B. F. KLINE

LEVI BERKEY NO. 2