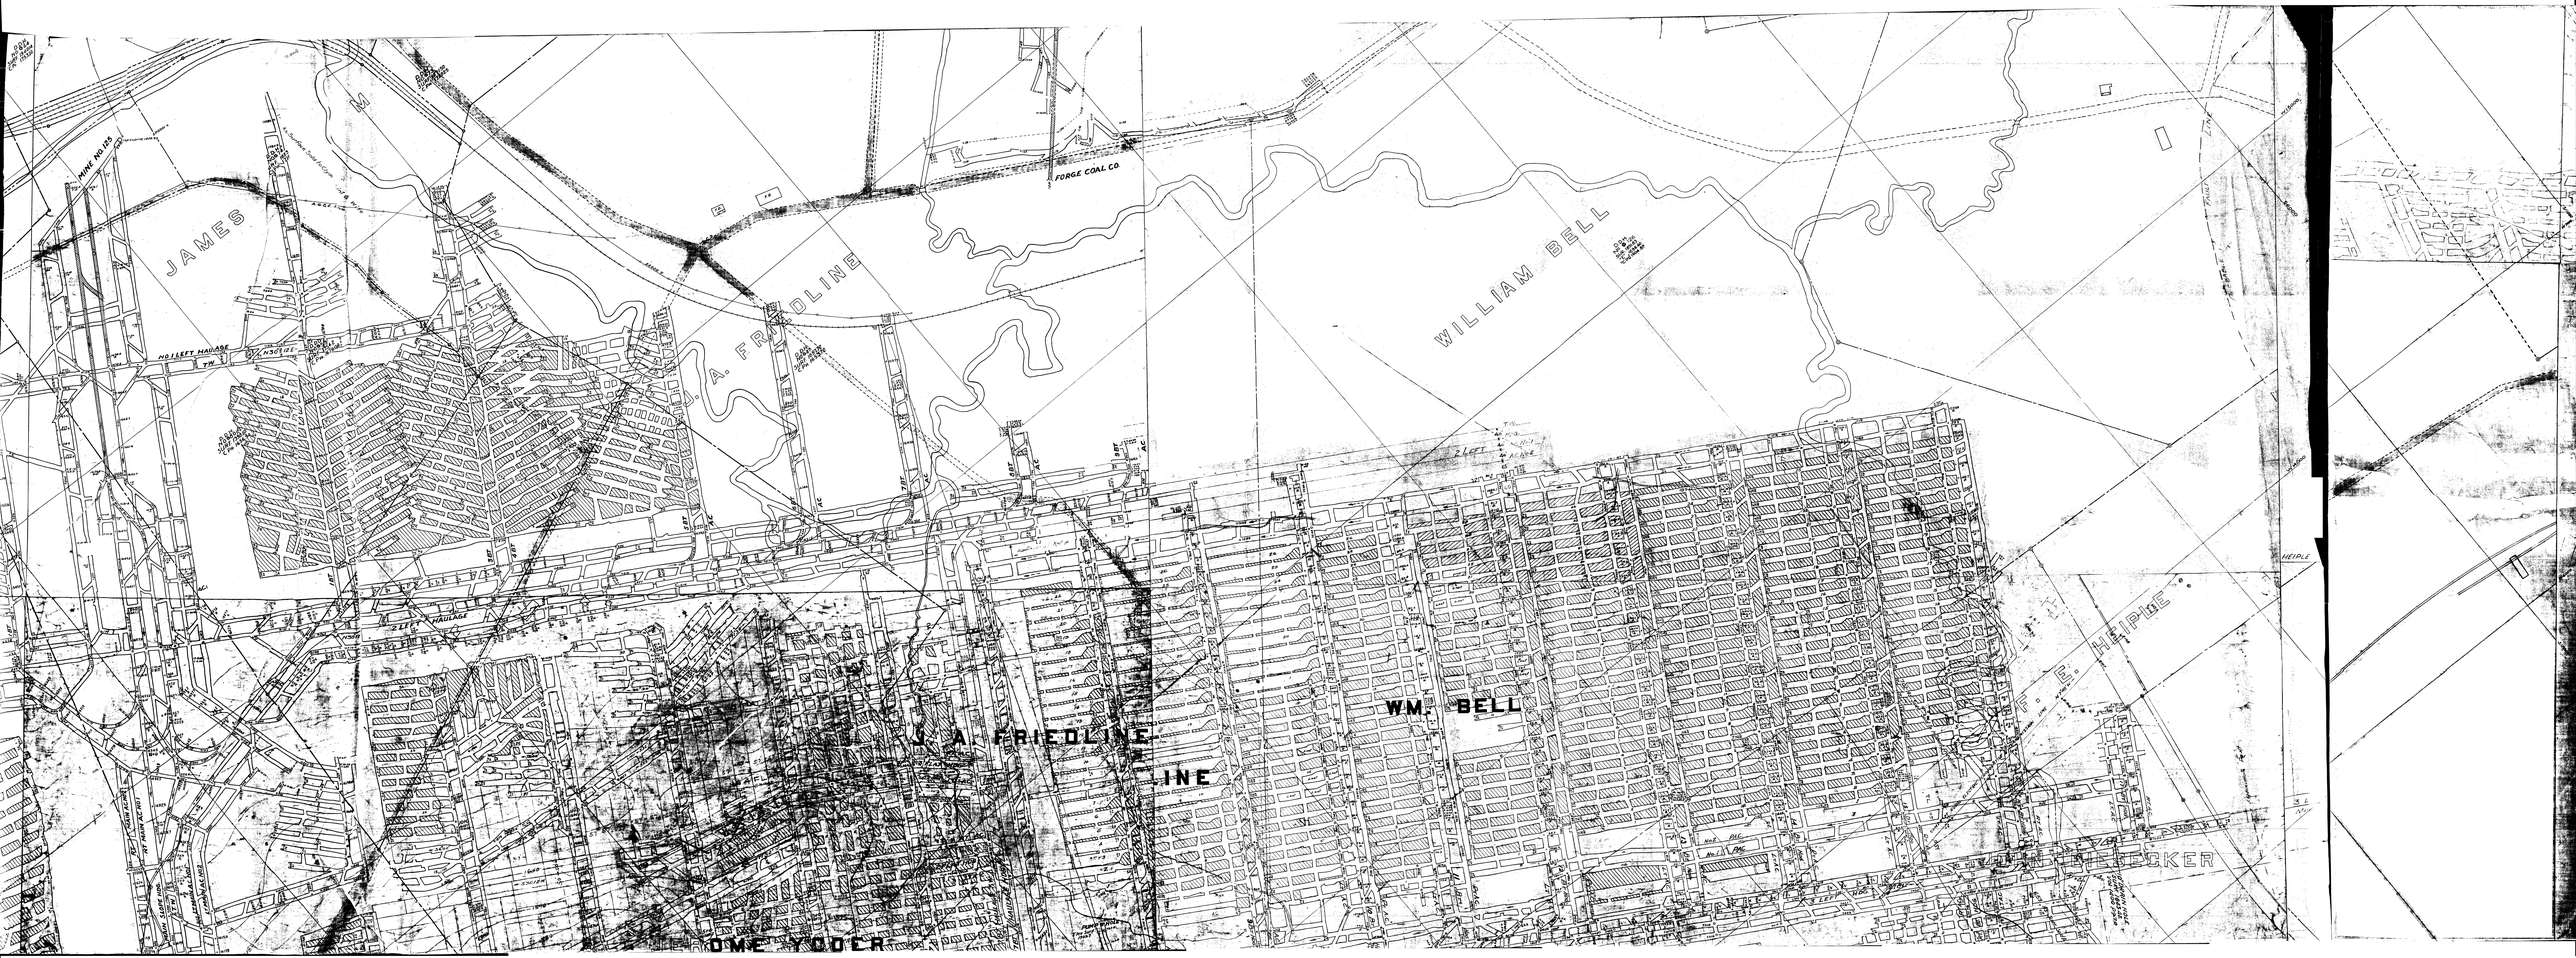

JAMES
A. FRIEDLINE
WILLIAM BELL
FORGE COAL CO
MINE NO 125
NO 1 LEFT HAULAGE
2 LEFT HAULAGE
WM. BELL
J. A. FRIEDLINE
INE
OME TOOER
F. E. HIPPLE
HEIPLE
BOKER