


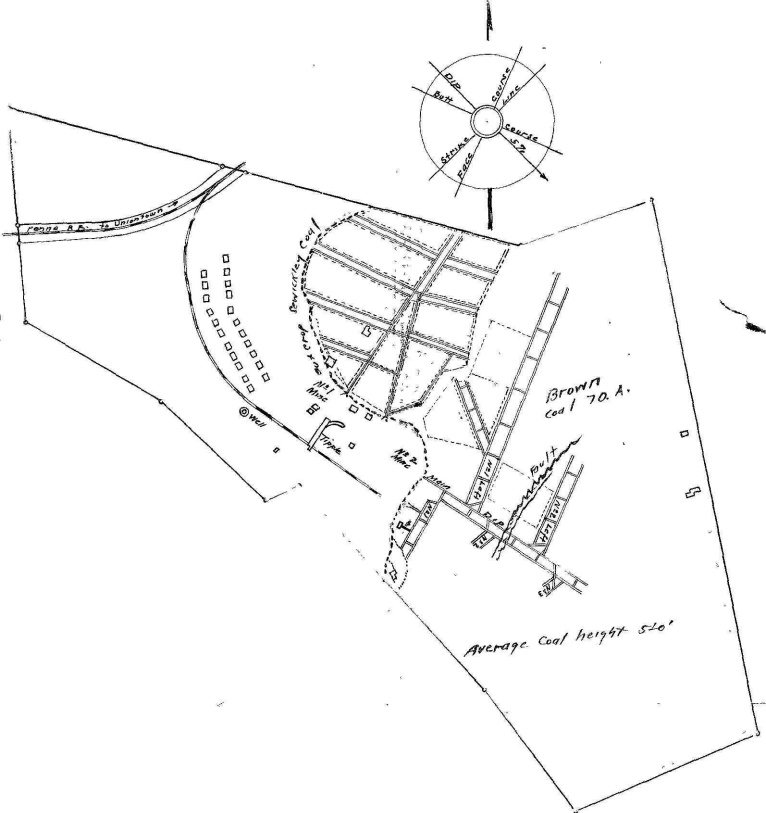

Sewickley Coal 55. A. Coal,

Amend Coal Co Surface, 100. A. Surf

Playford Mine
of the

Amend Coal Company

South Union Township Fayette County Pa.

Engineering Dept

Greensburg Pa.

Scale 1" = 400'

A. Remondy Eng

March 9th 1920.