


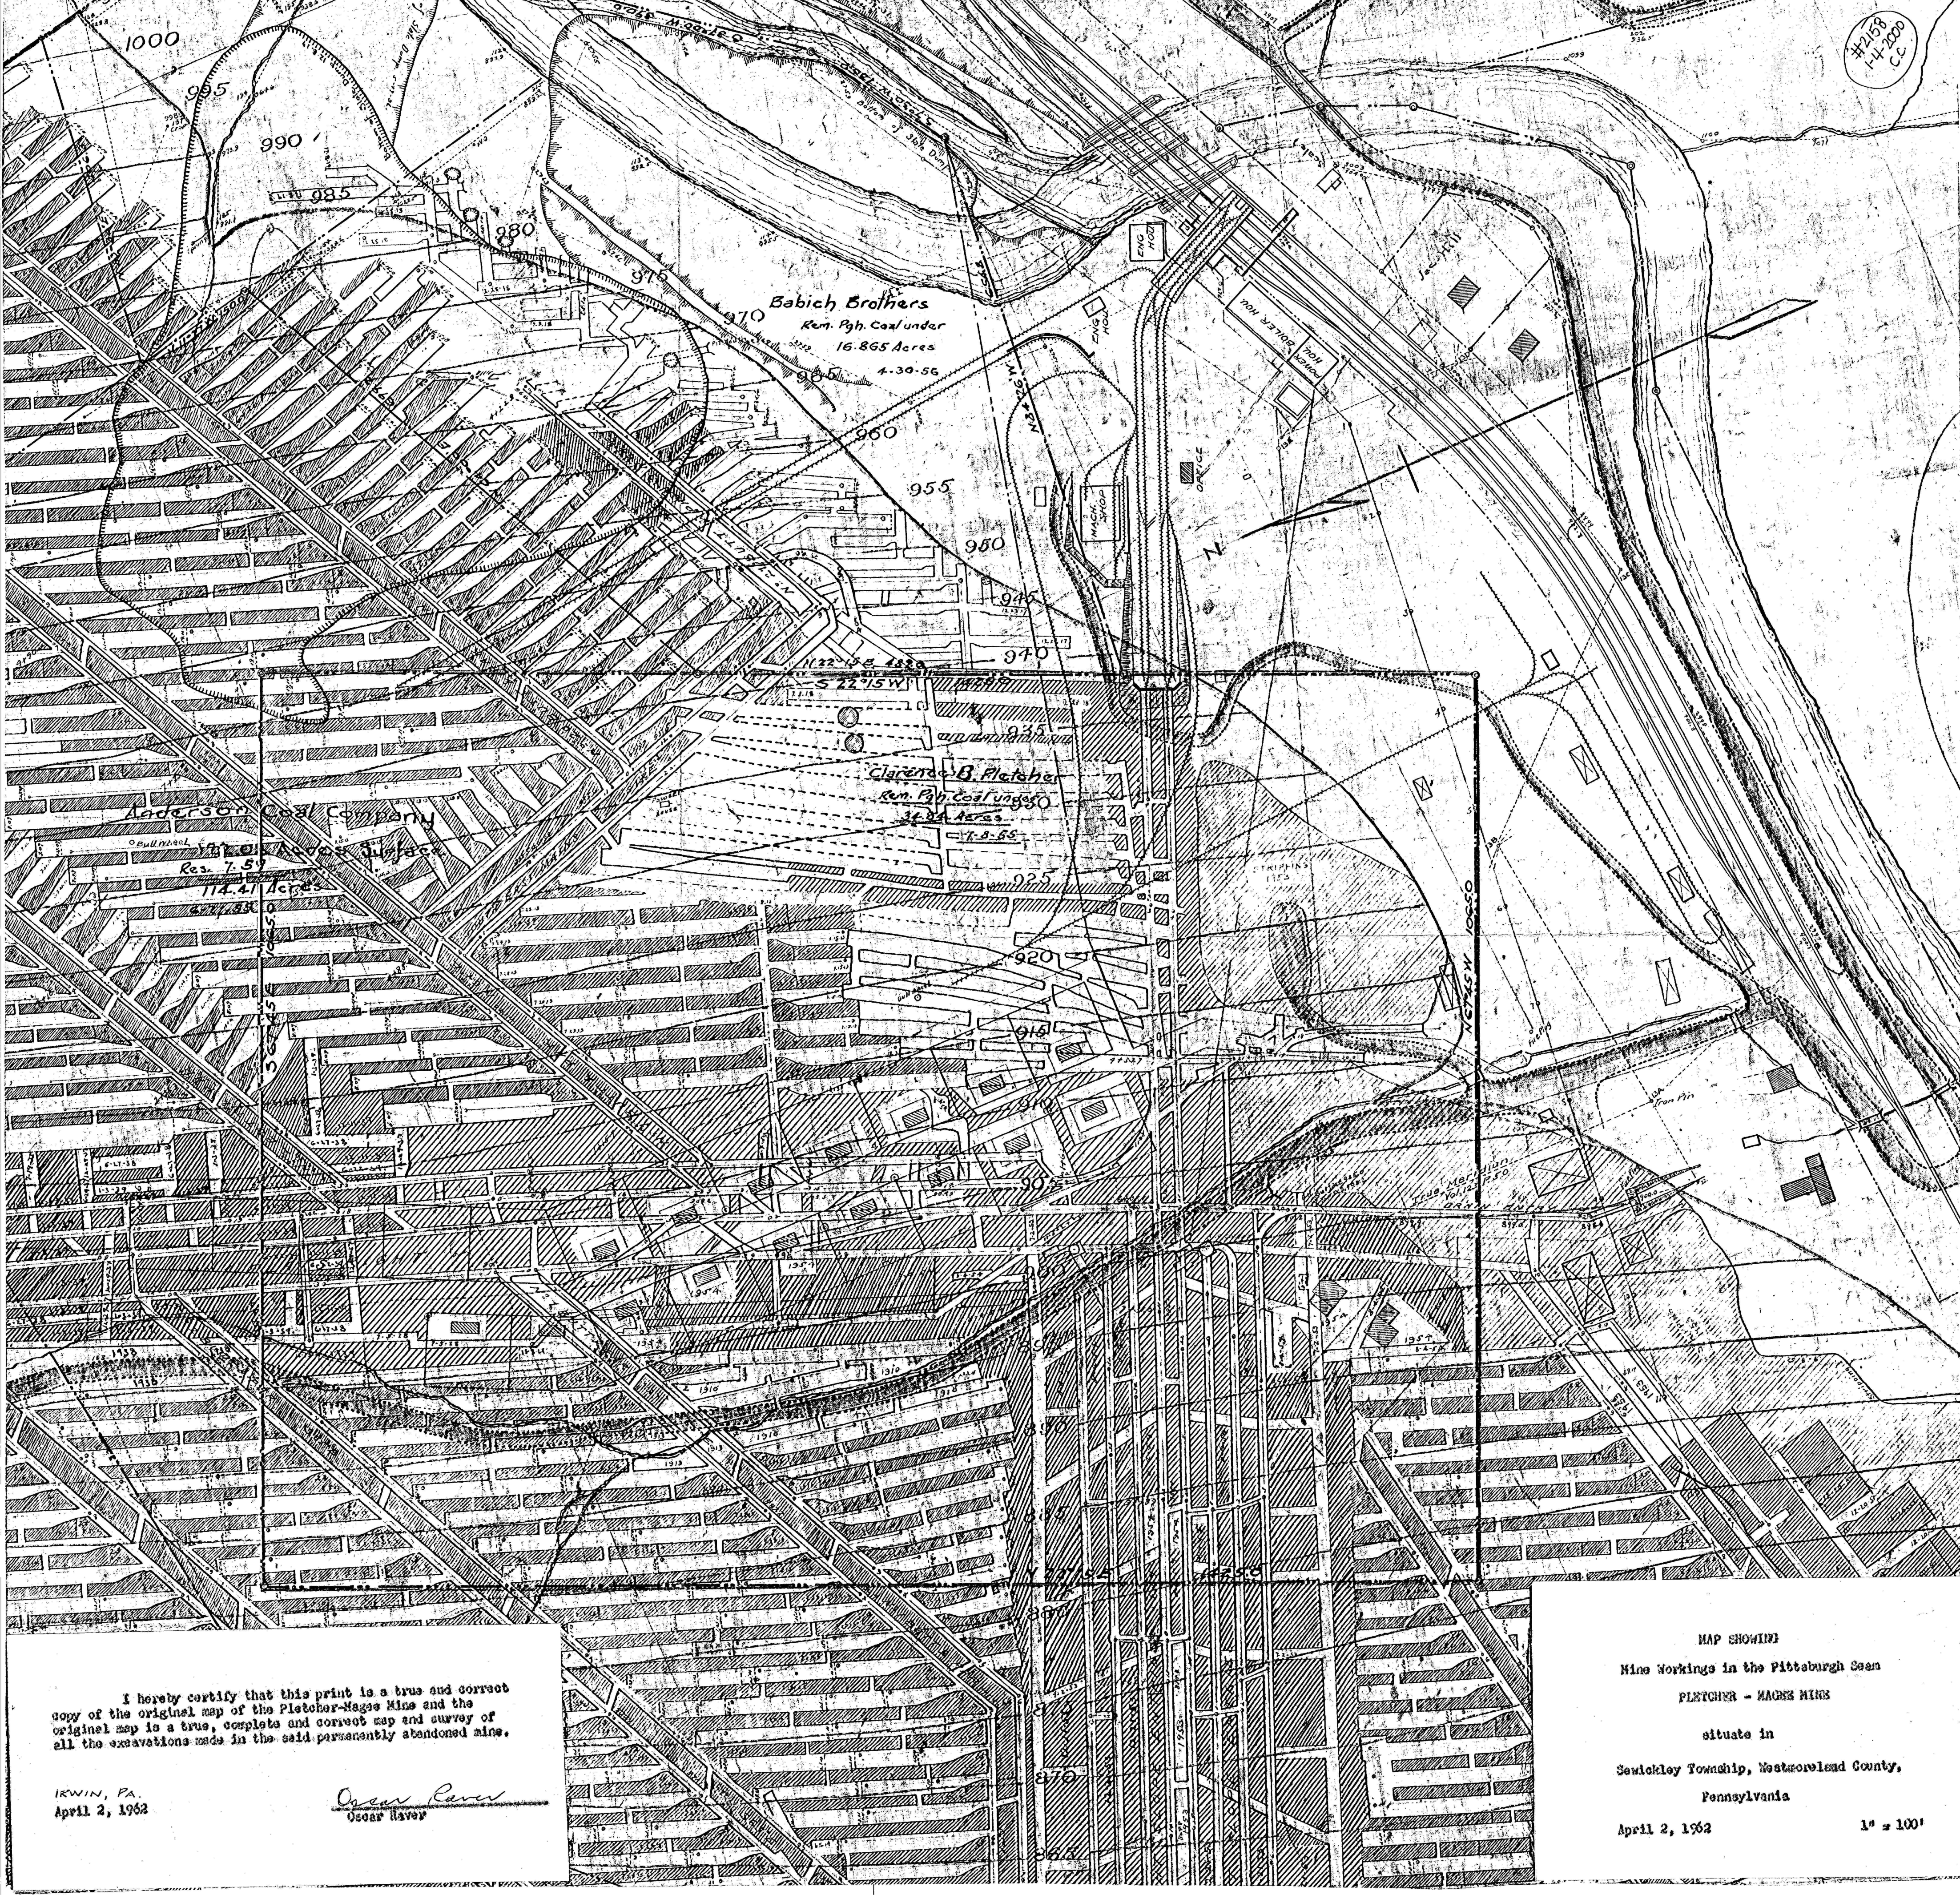

#2158
1-4-2000
CC

I hereby certify that this print is a true and correct copy of the original map of the Pletcher-Magee Mine and the original map is a true, complete and correct map and survey of all the excavations made in the said permanently abandoned mine.

IRWIN, PA.
April 2, 1962

Oscar Raver
Oscar Raver

MAP SHOWING
Mine Workings in the Pittsburgh Seam
PLETCHER - MAGEE MINE
situate in
Senickley Township, Westmoreland County,
Pennsylvania
April 2, 1962 1" = 100'