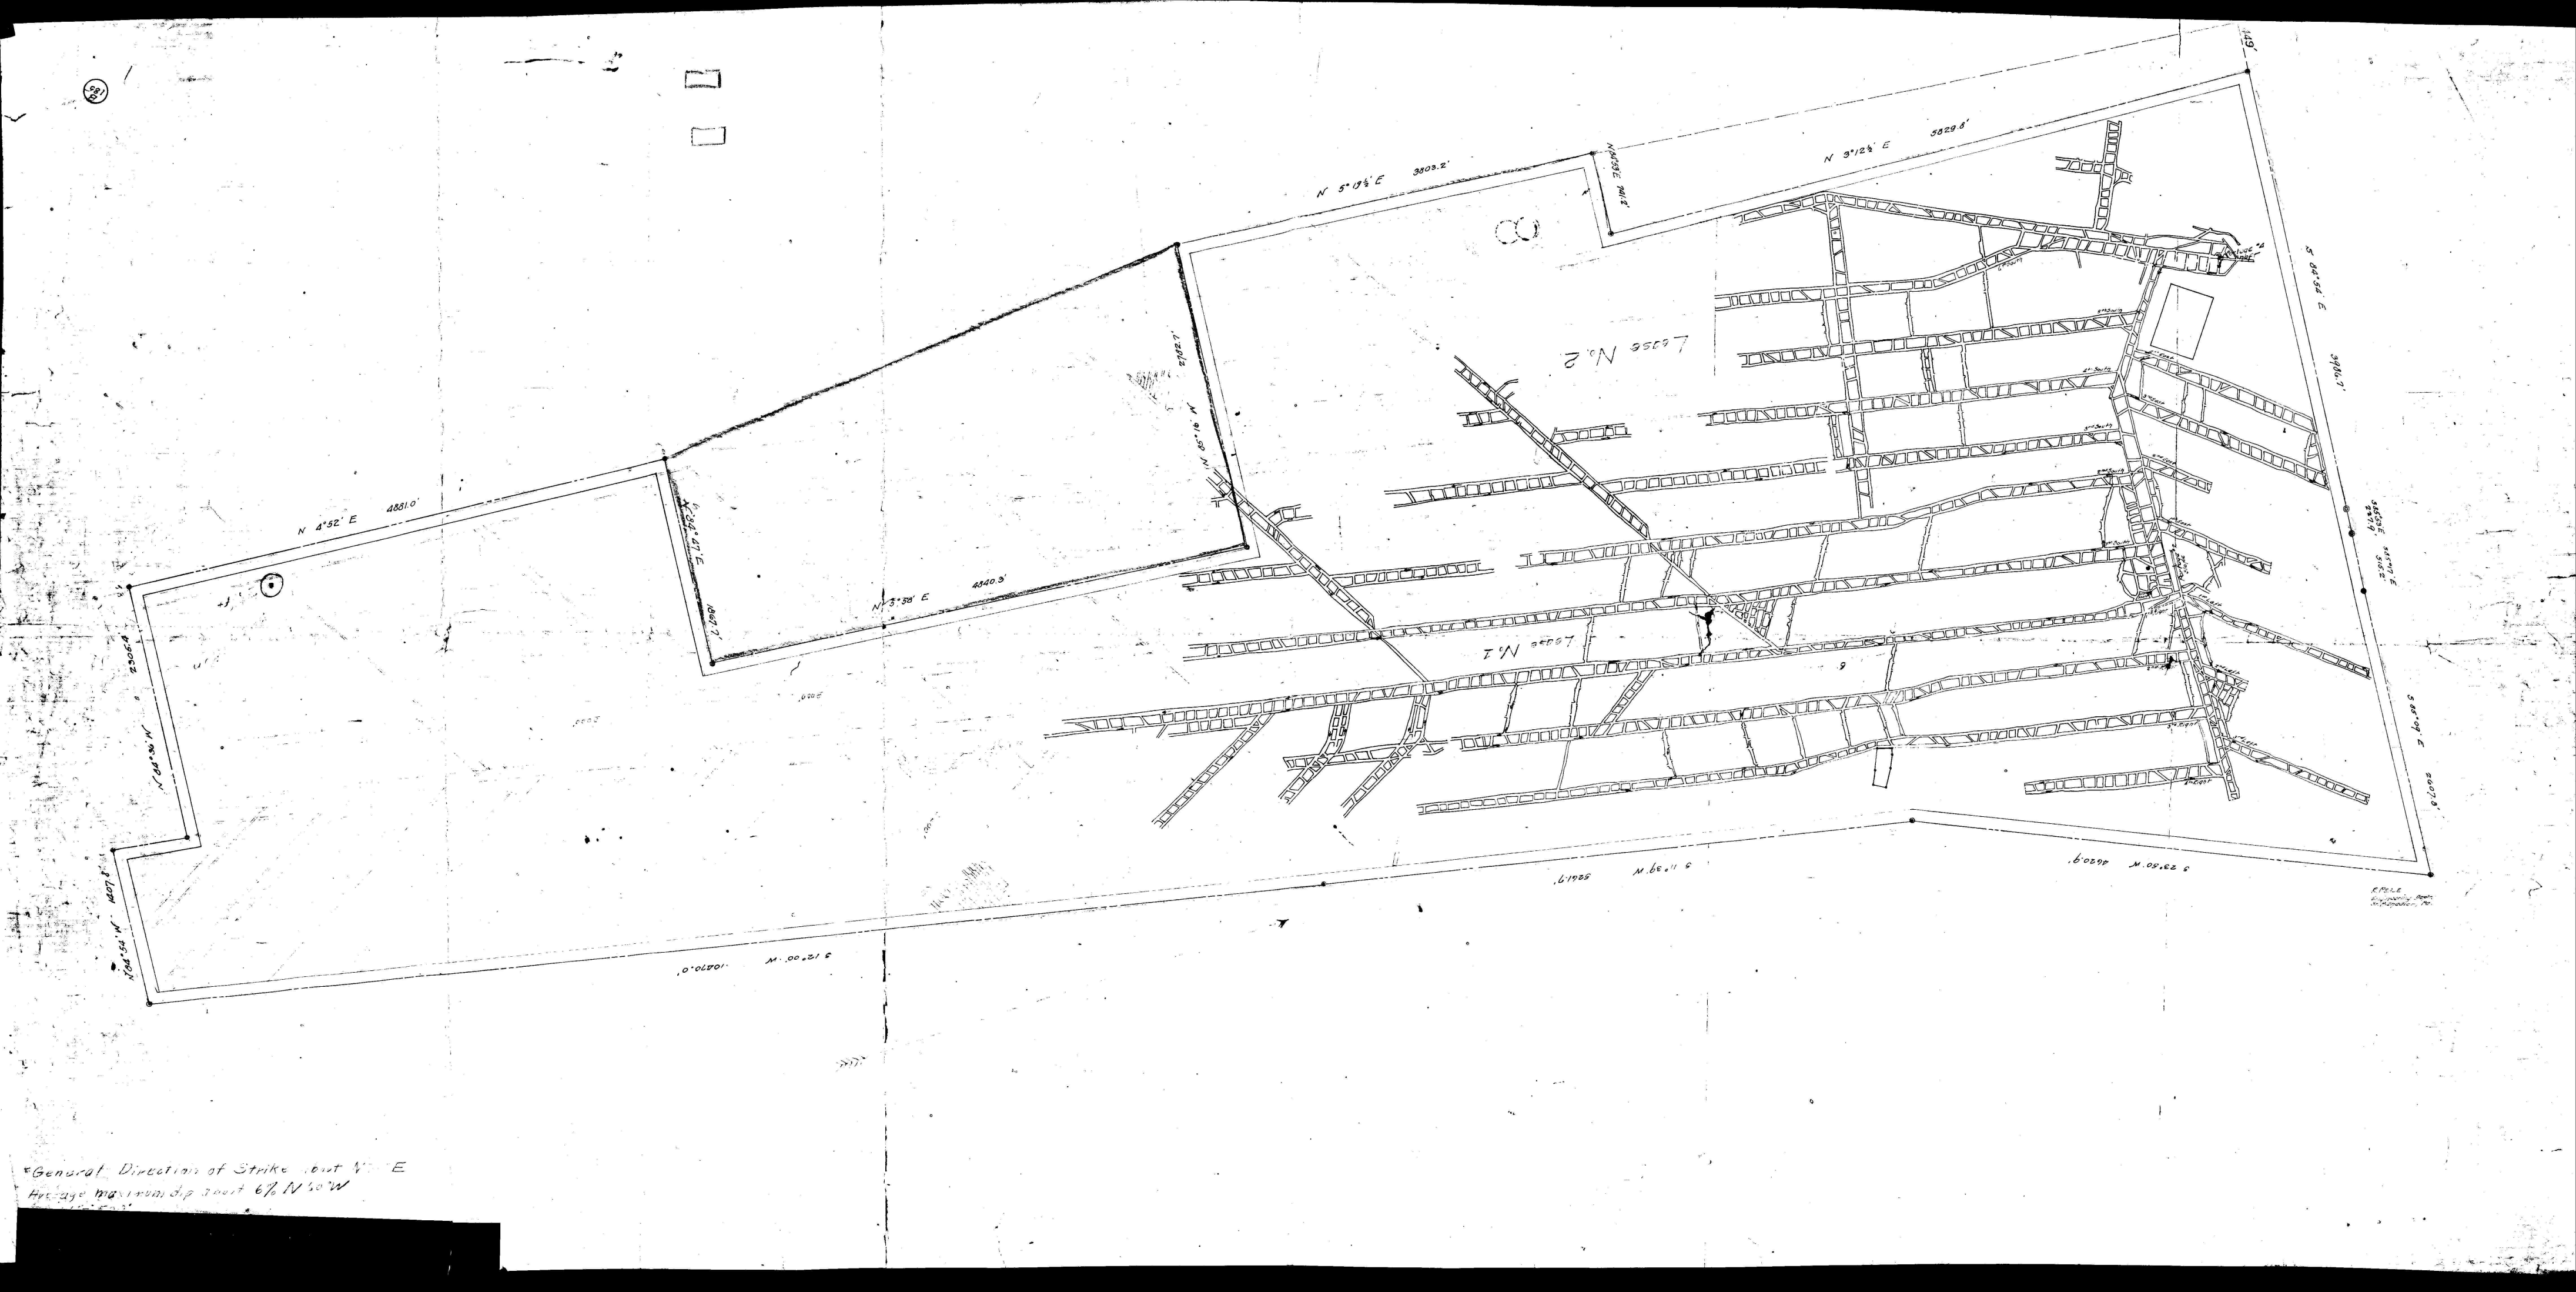
Lease No. 2
Lease No. 1
N 4°52' E 4881.0'
N 3°38' E 4840.3'
N 5°19½' E 3803.2'
N 3°12½' E 3029.8'
S 66°52' E
N 66°11' E
