

GRAZIER COAL MINING CO.

GRAZIER C.M. CO.

WILMORE COAL CO.


JOSEPH CUSTER

SCHOOL PROPERTY
1-ACRE

CAMBRIA FUEL CO.

Potochar & Potochar Coal Co.
"Potochar Mine"
Operated Surveys A, B, C

DEEP MINE SAFETY 100

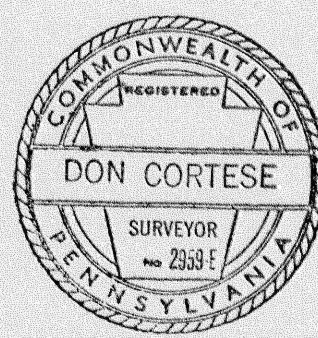

WM. NAU COAL CO.
NEW JASAHILL COAL CO.
B-SEAM MINING OPERATIONS
SITUATE IN
CONEMAUGH TWP. SOMERSET CO. PA.
SCALE 1"=100'
9-2-1955

12-20-79
C.C.