


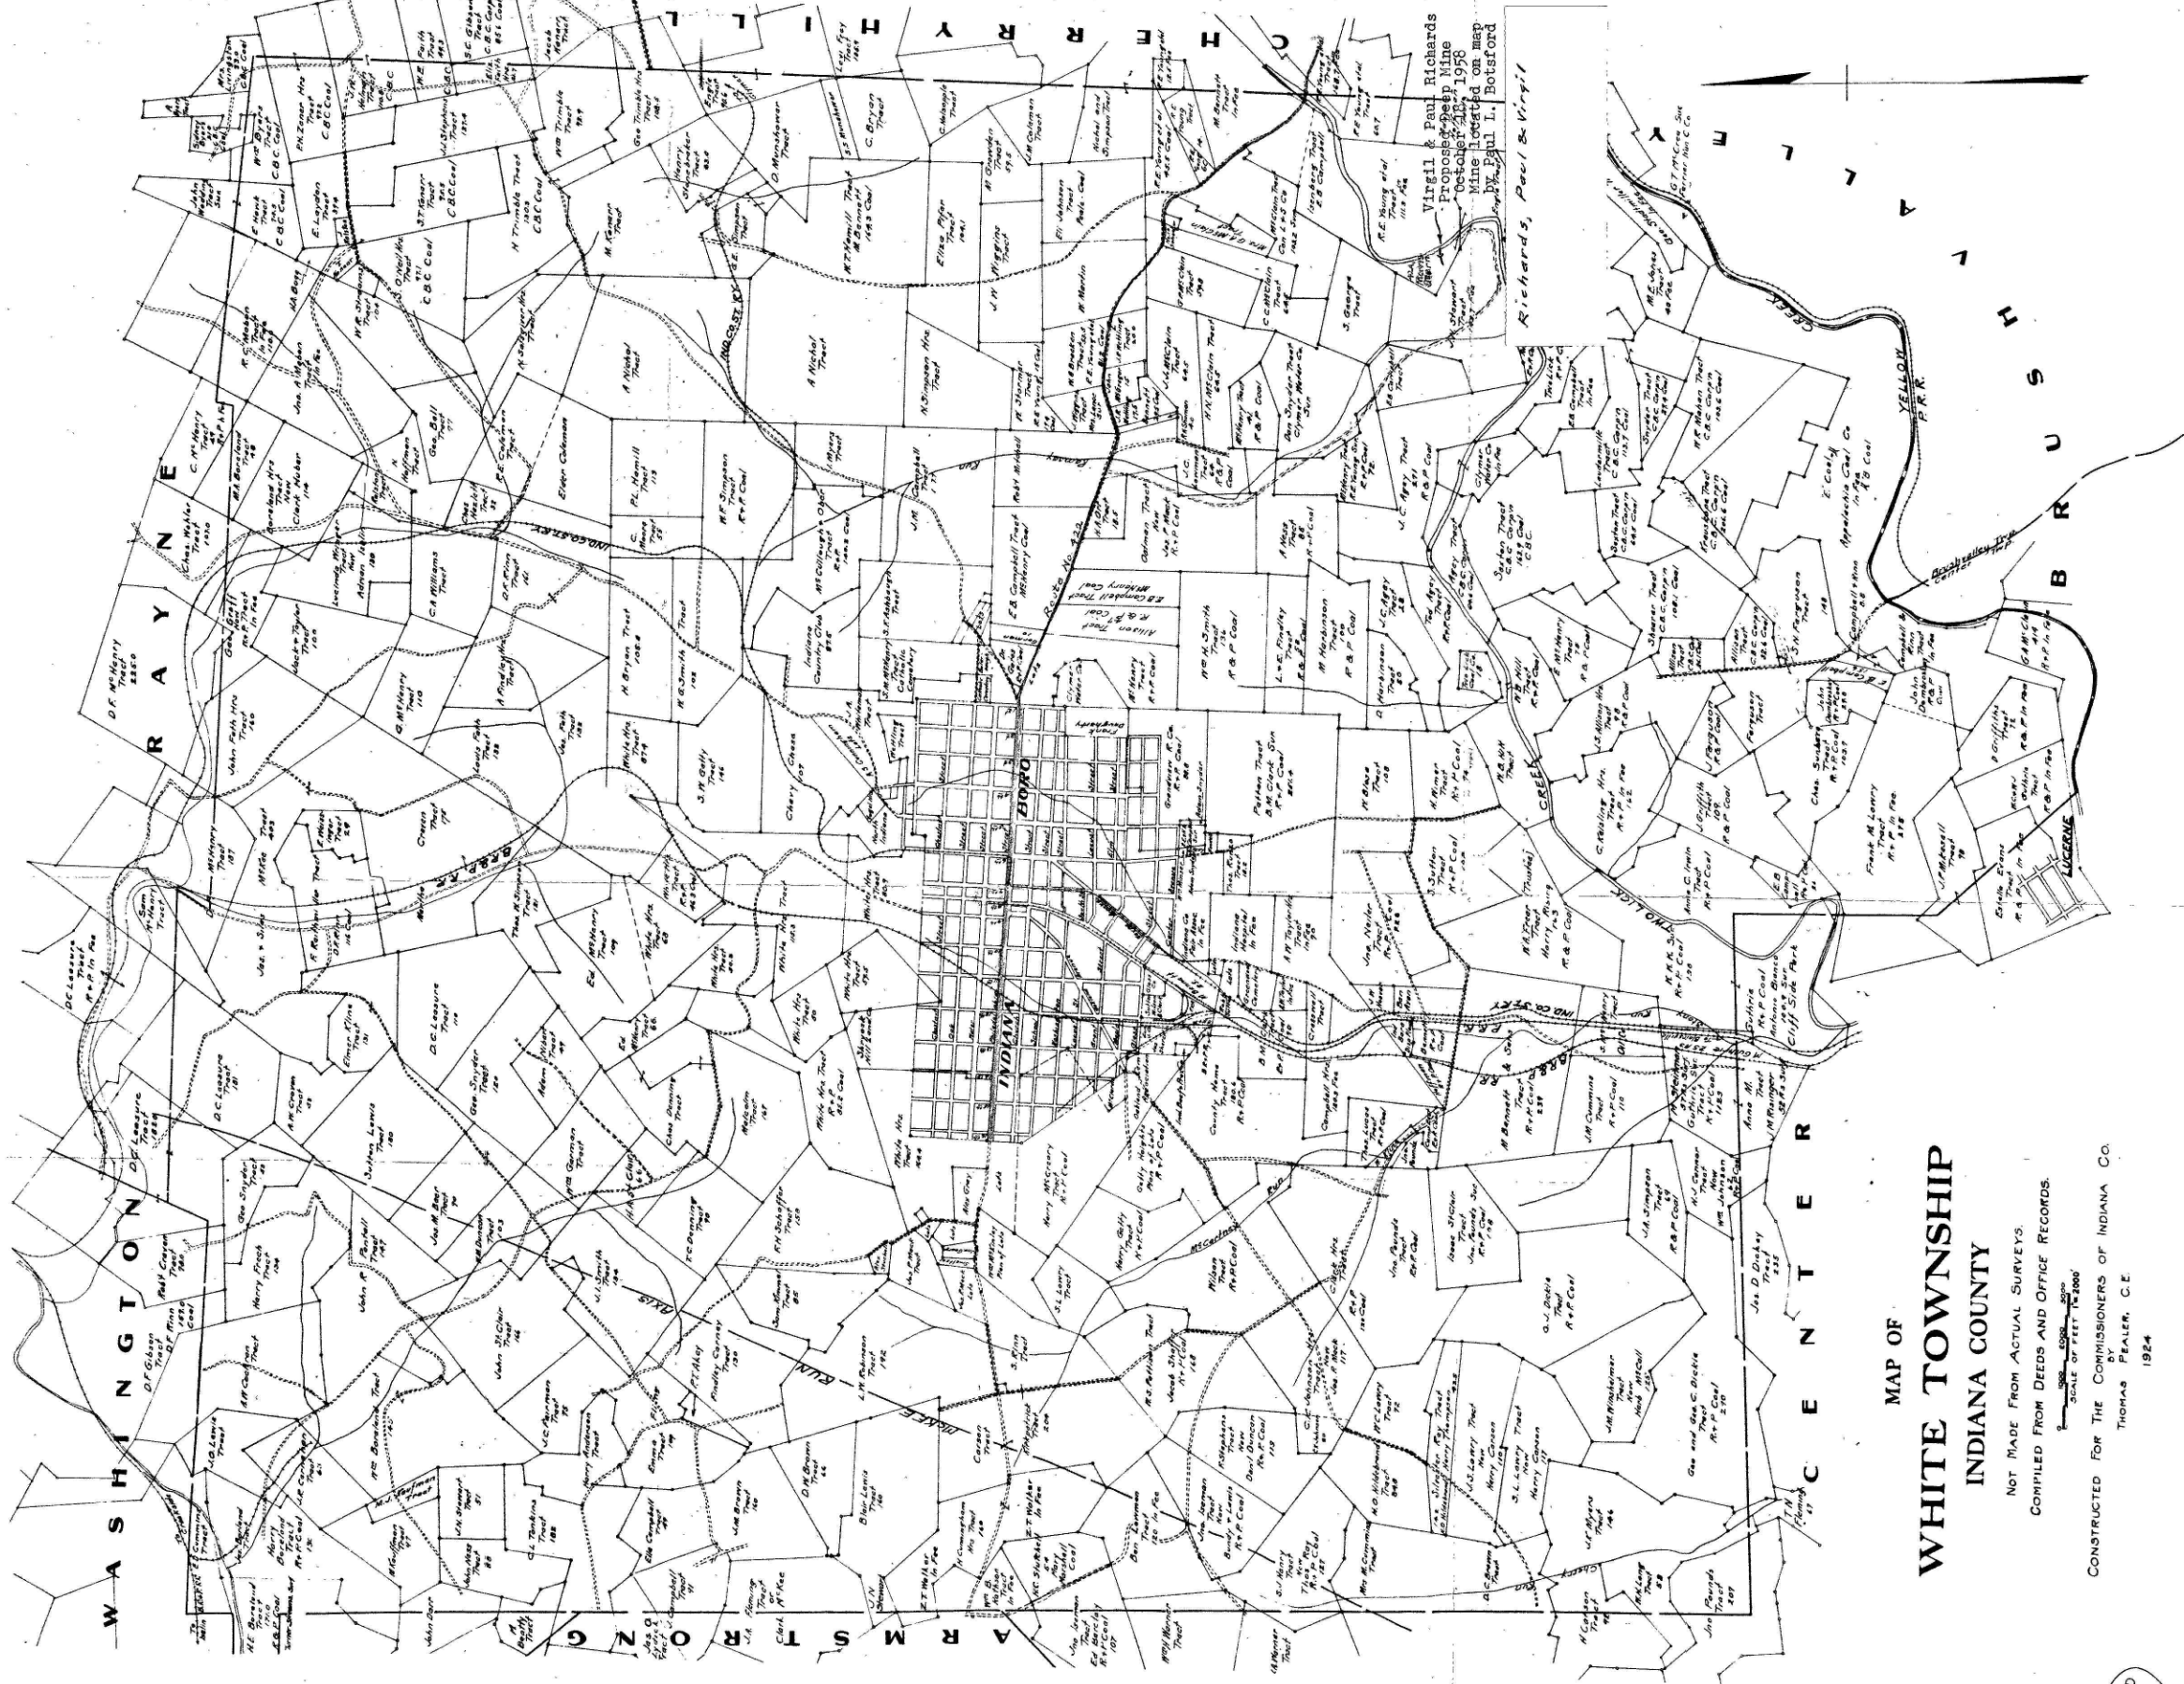

MAP OF
WHITE TOWNSHIP
INDIANA COUNTY

NOT MADE FROM ACTUAL SURVEYS.
COMPILED FROM DEEDS AND OFFICE RECORDS.

SCALE OF FEET 1"=2000'

CONSTRUCTED FOR THE COMMISSIONERS OF INDIANA CO.
THOMAS PEALER, C.E.

1924

#218
1-4-2000
CC