


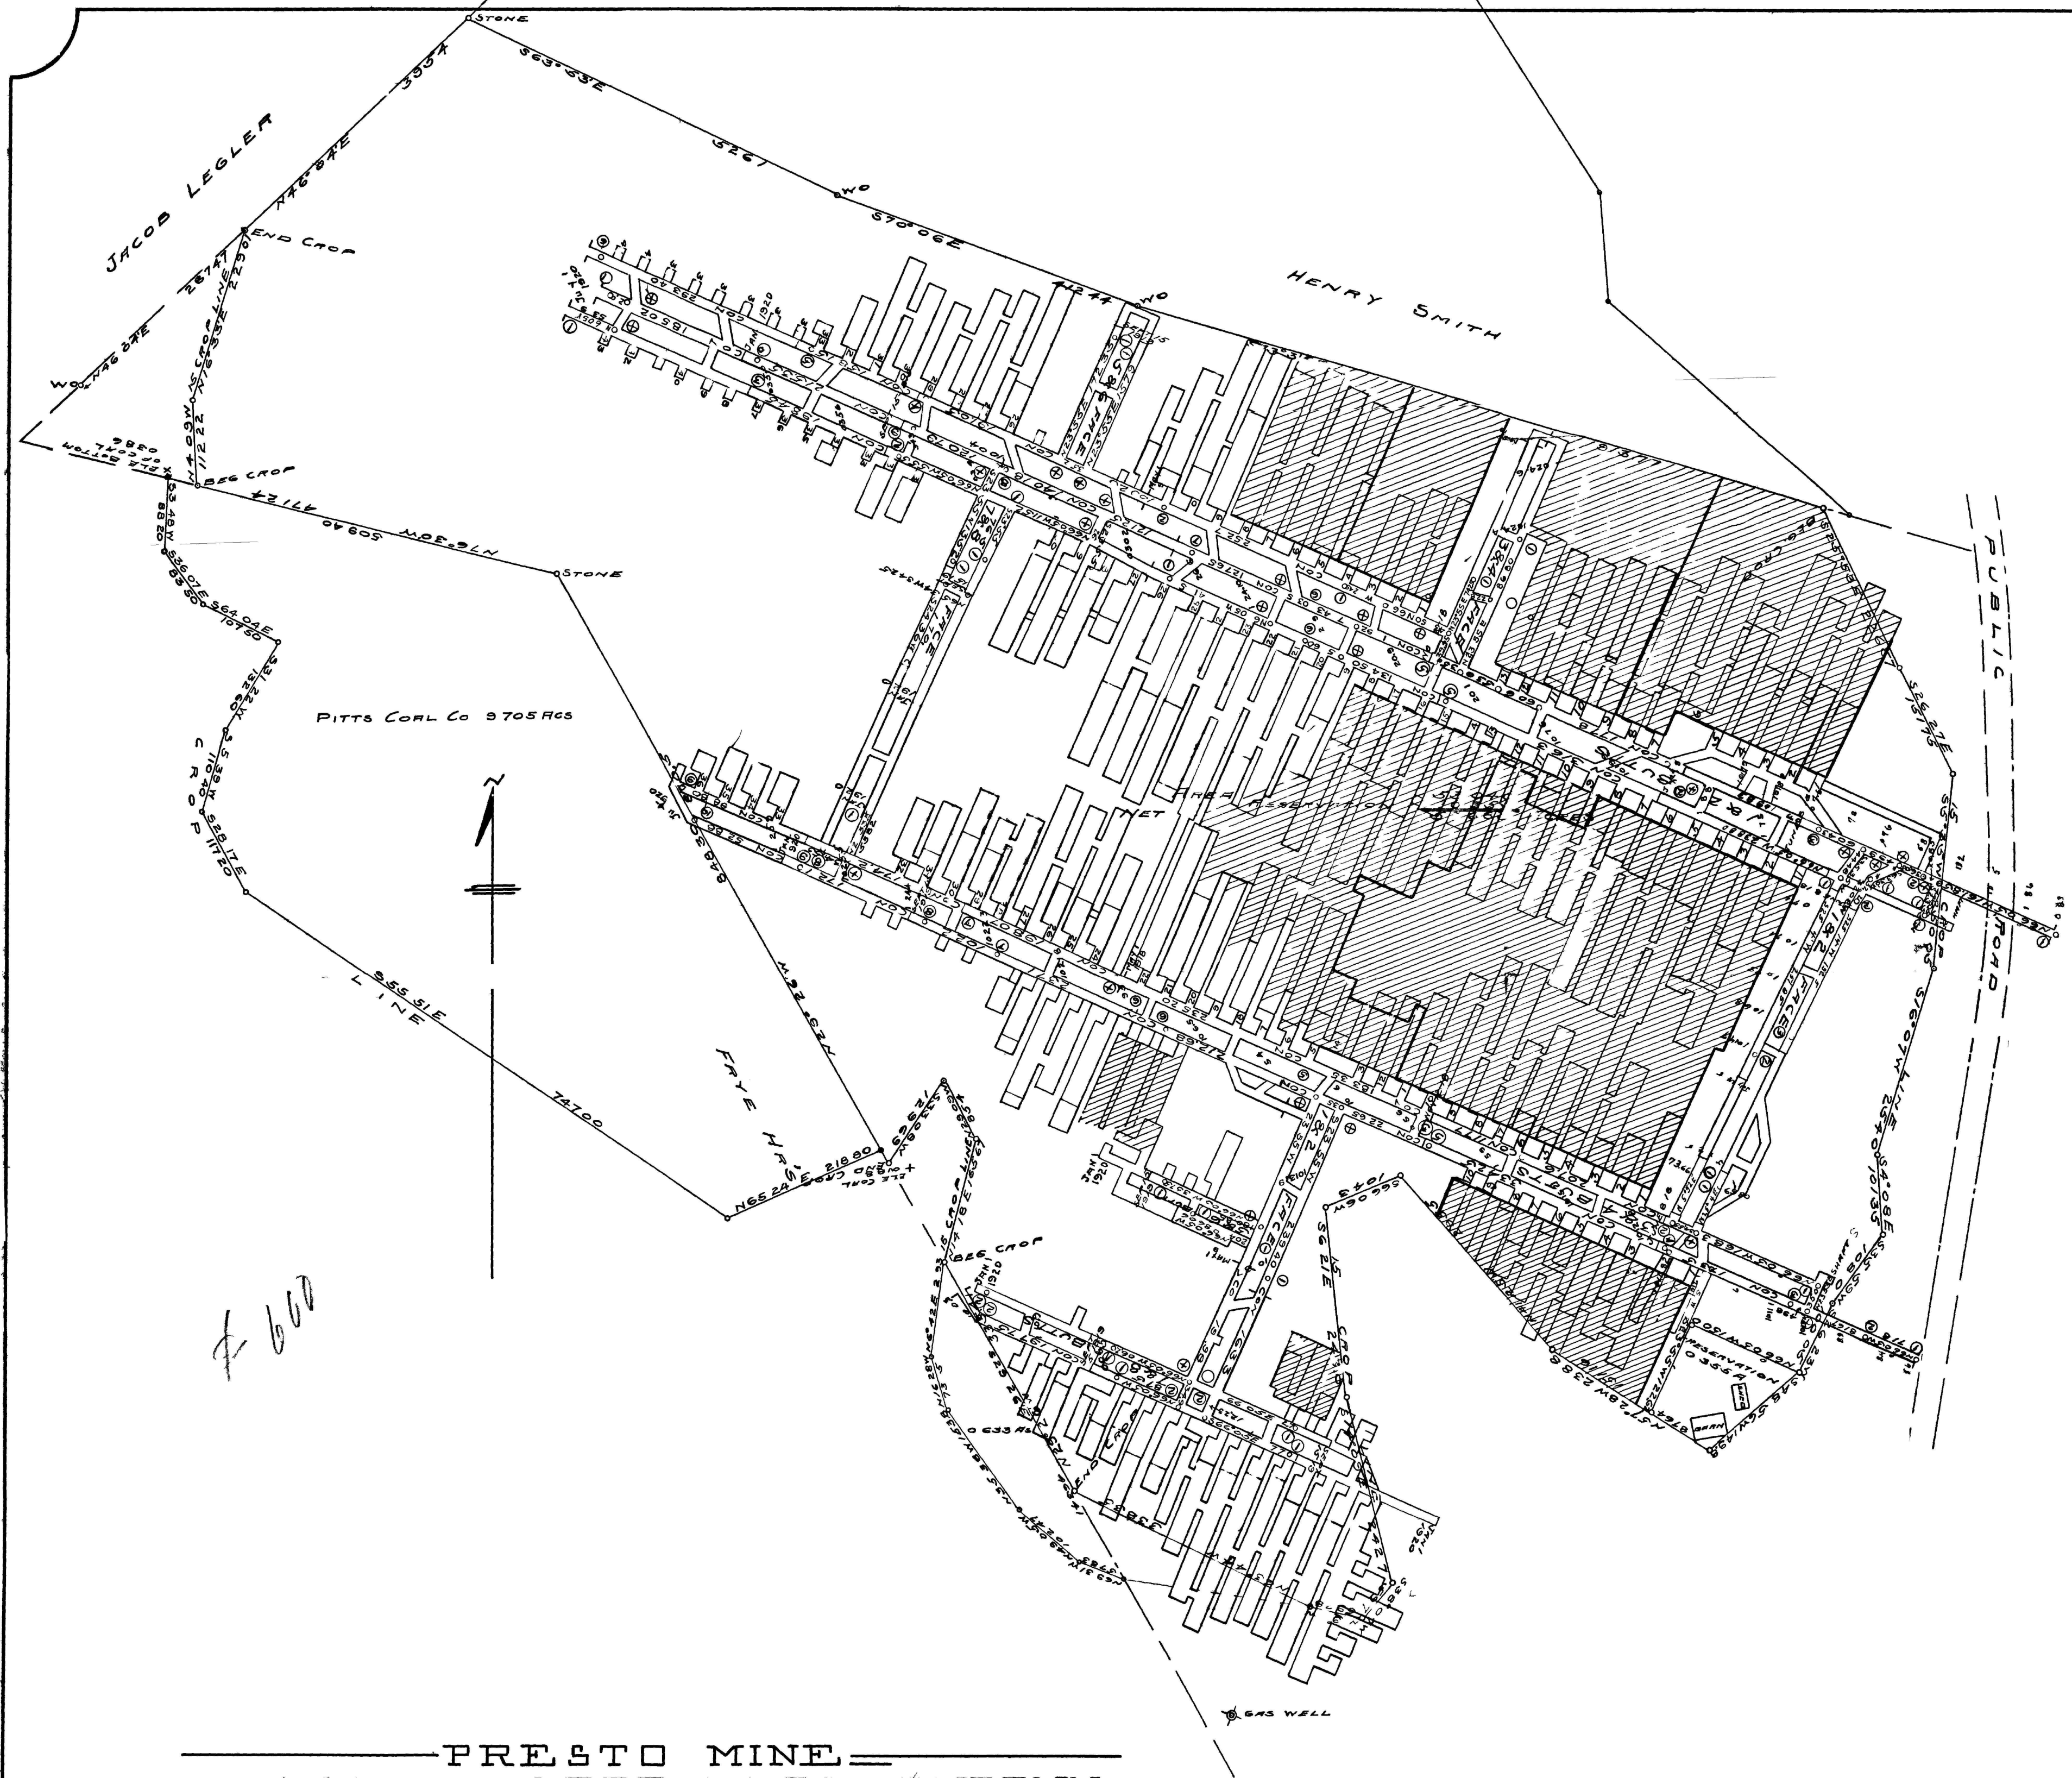

PRESTO MINE
SOUTH FAYETTE COAL COMPANY
FINLEYVILLE PA

SCALE 1"=100 JULY 1918 ANDREWS & SOUTHWARD ENGINEERS
CURRY BLDG. PITTSBURGH PA.