


Scale, feet

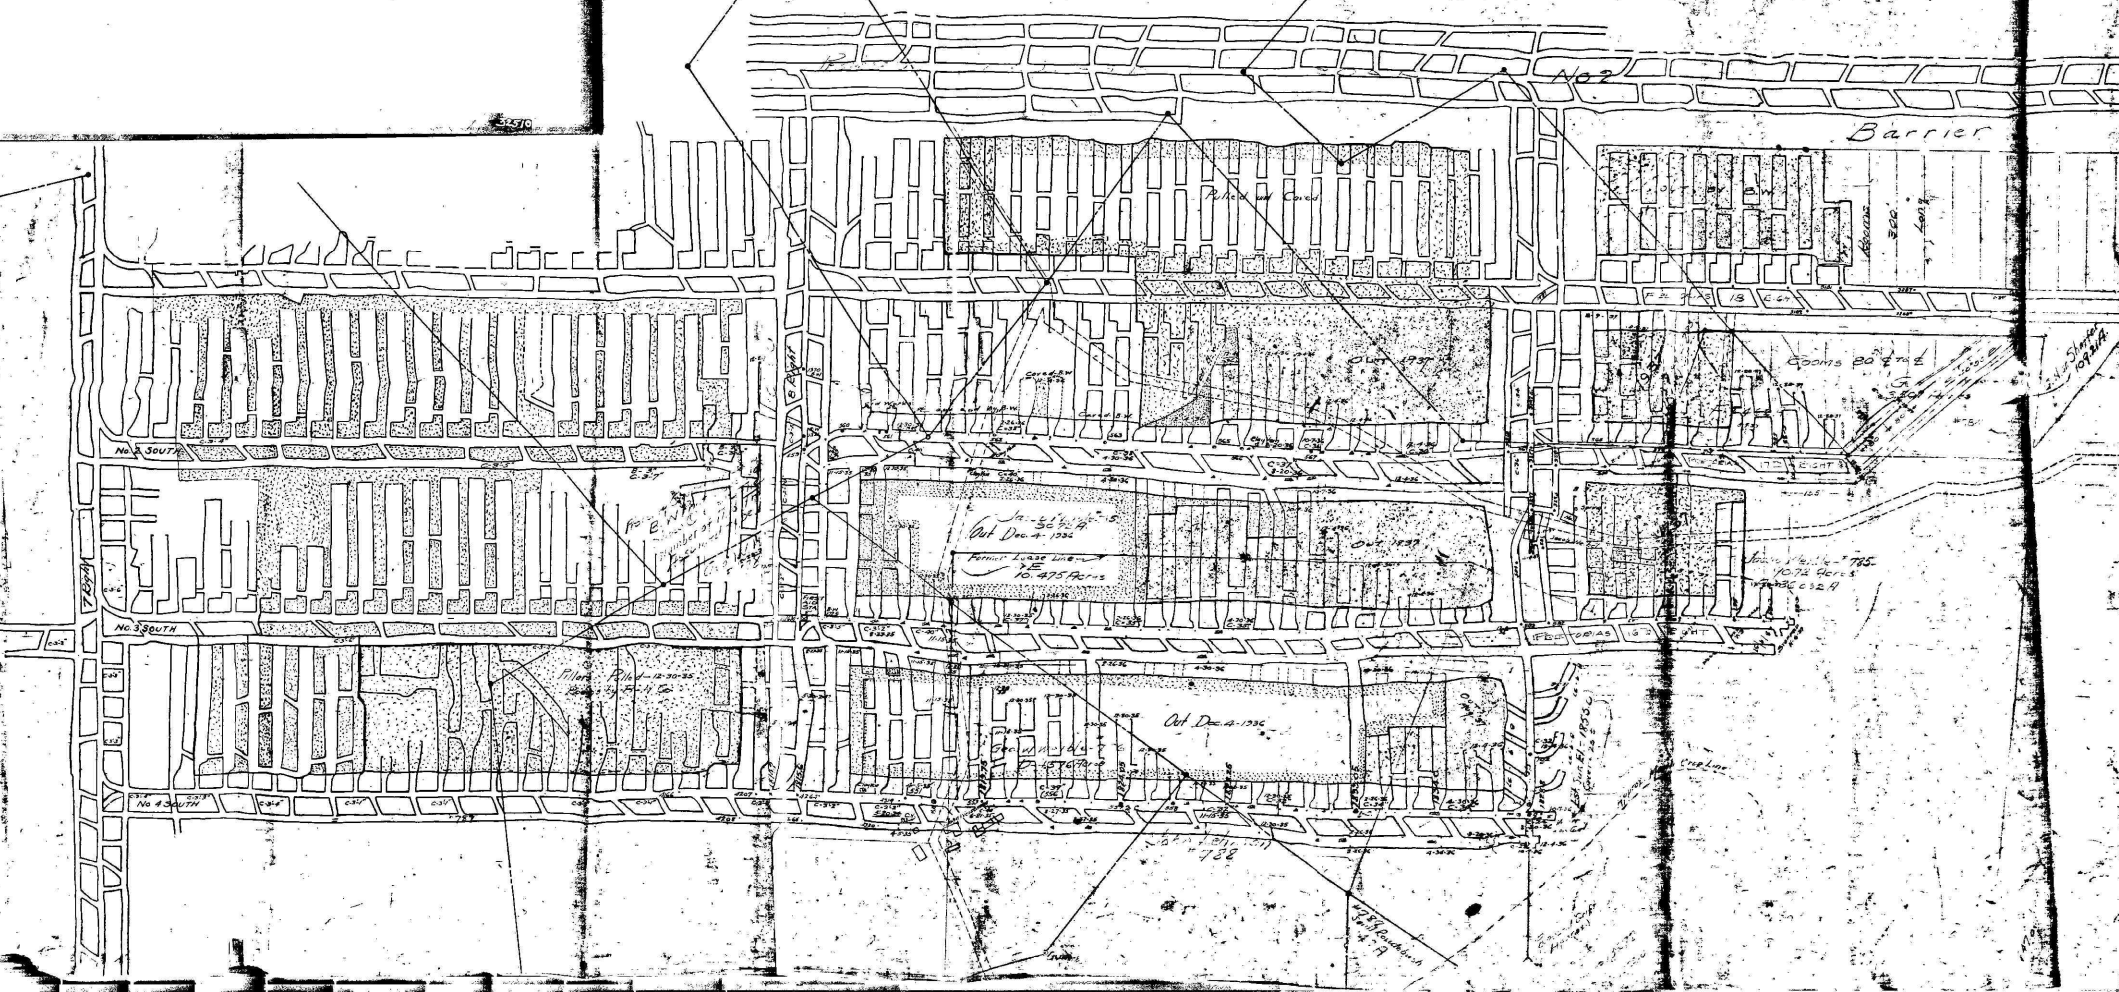

PDVMS 03070 375 31X 325101

03070

375

31X

3 2 5 1 0 1