



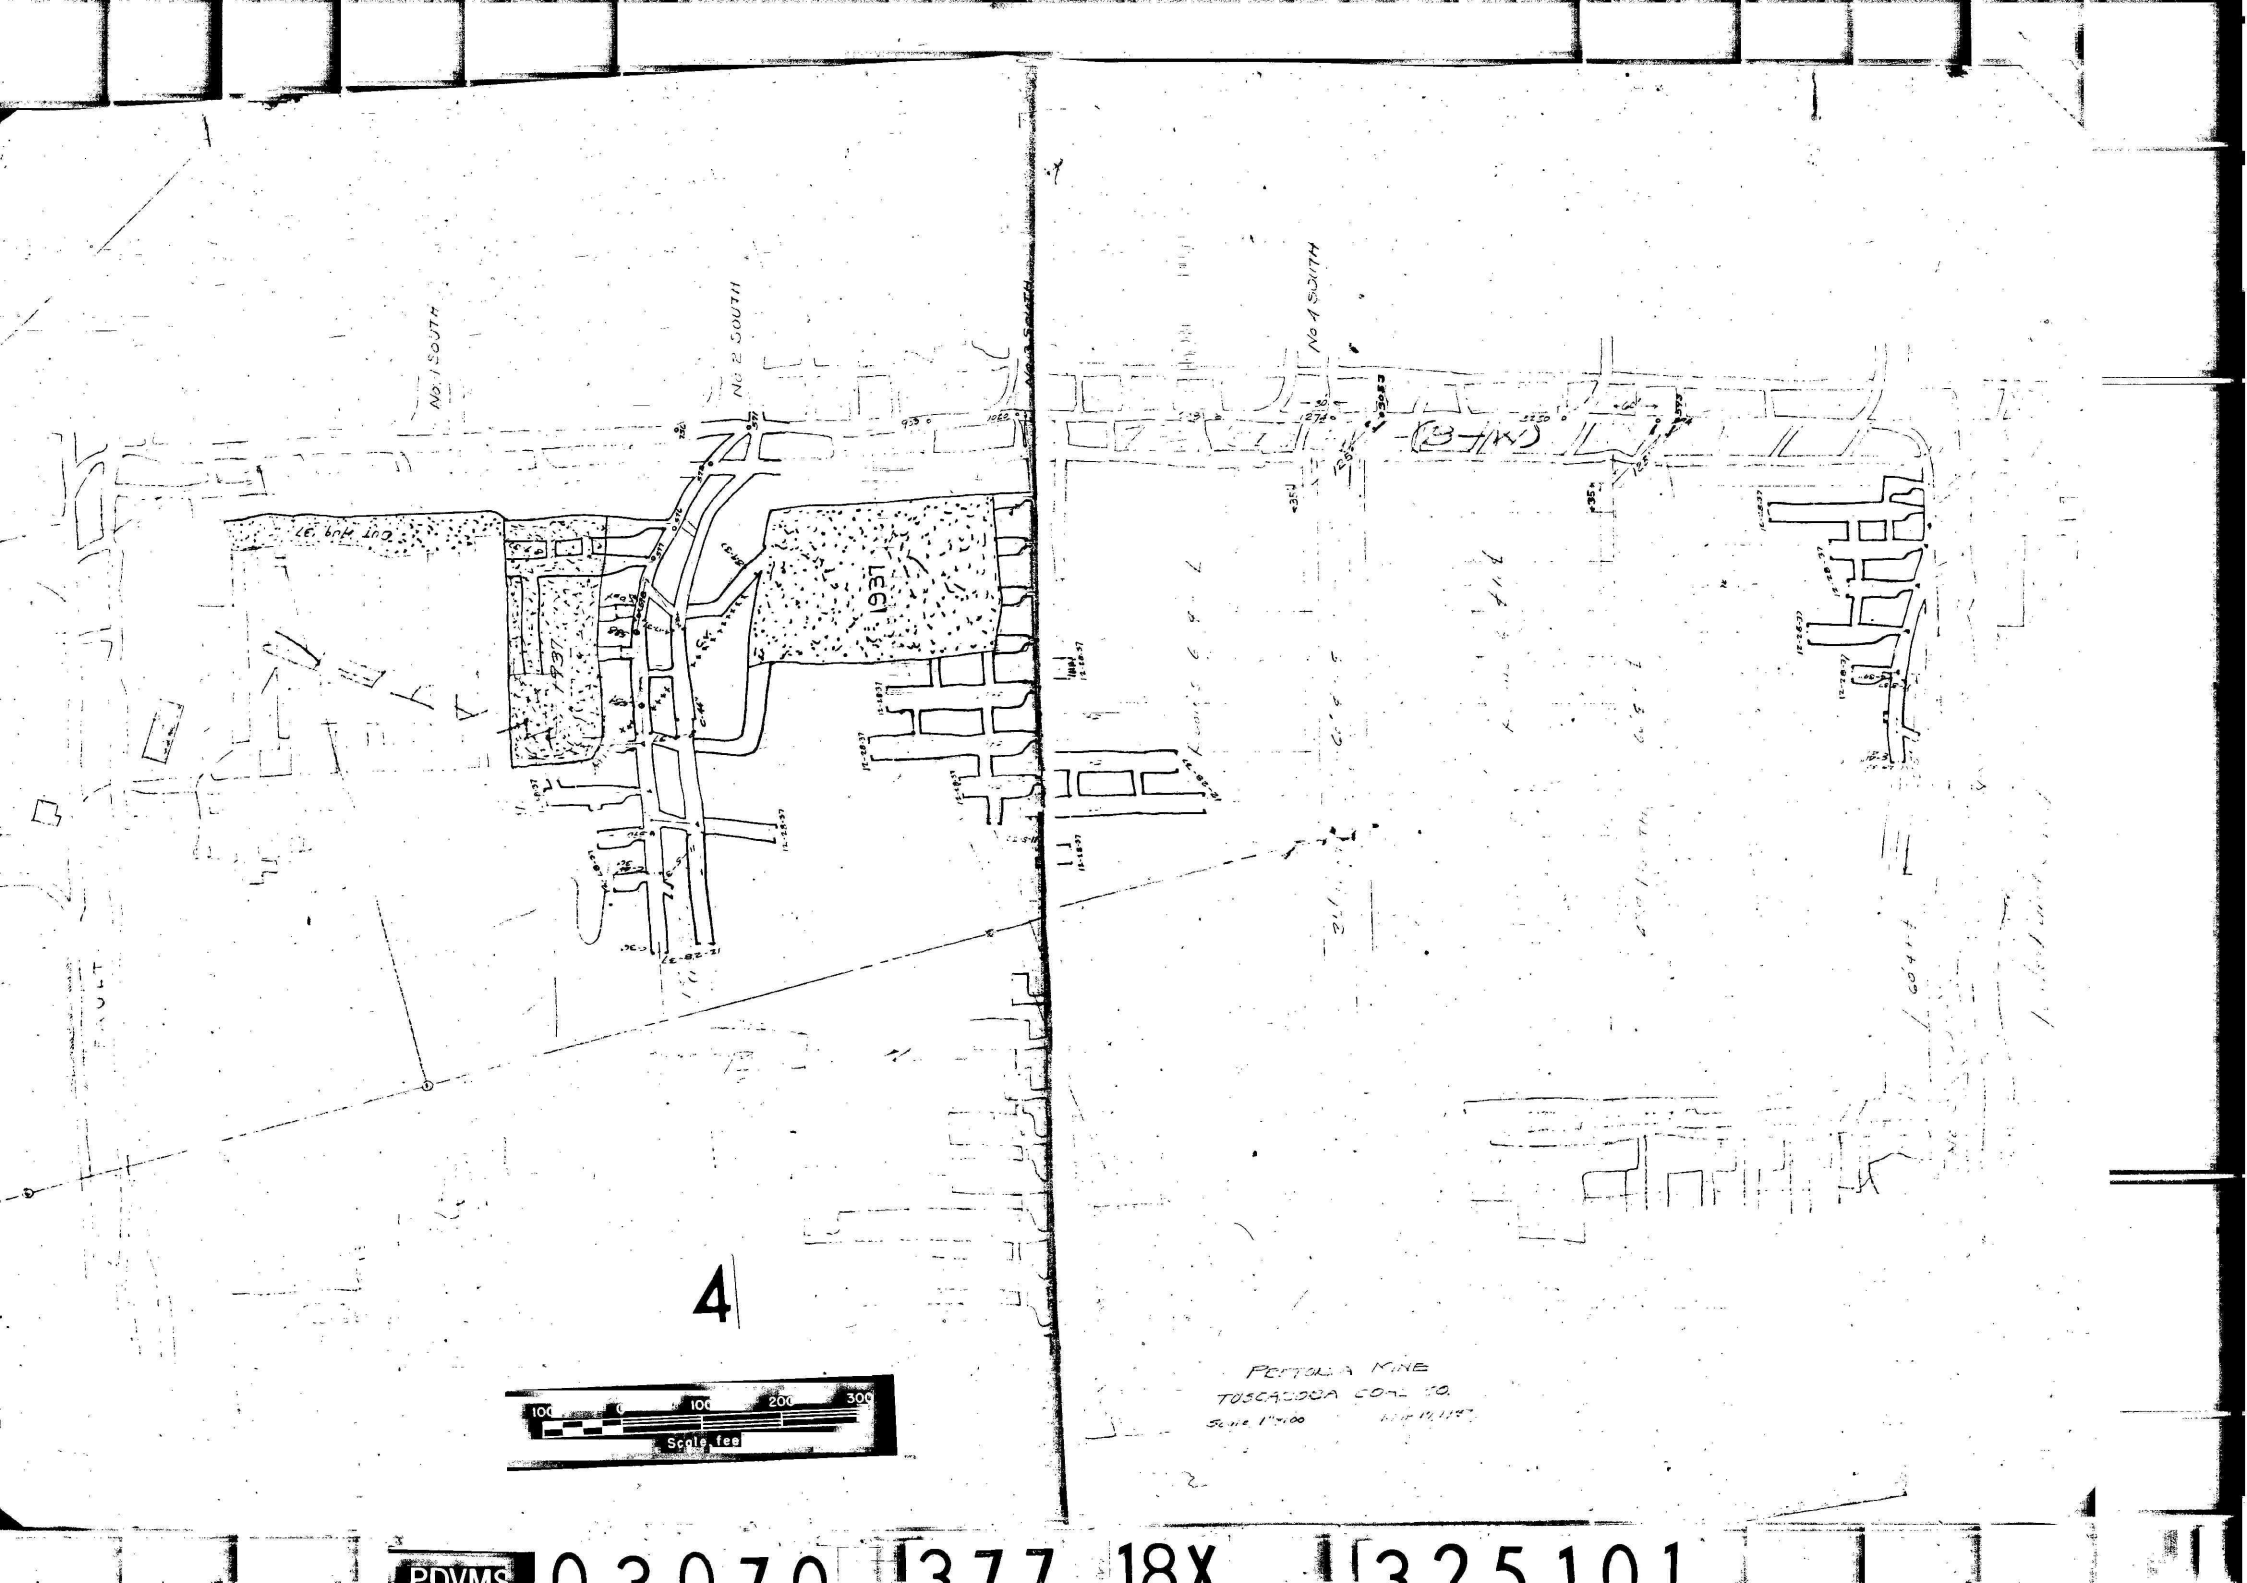

4

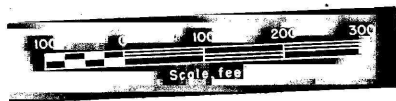

TUSCAGLOOBA COAL CO.
Scale 1"=100'

PDVMS

03070

1377

18X

1325101