


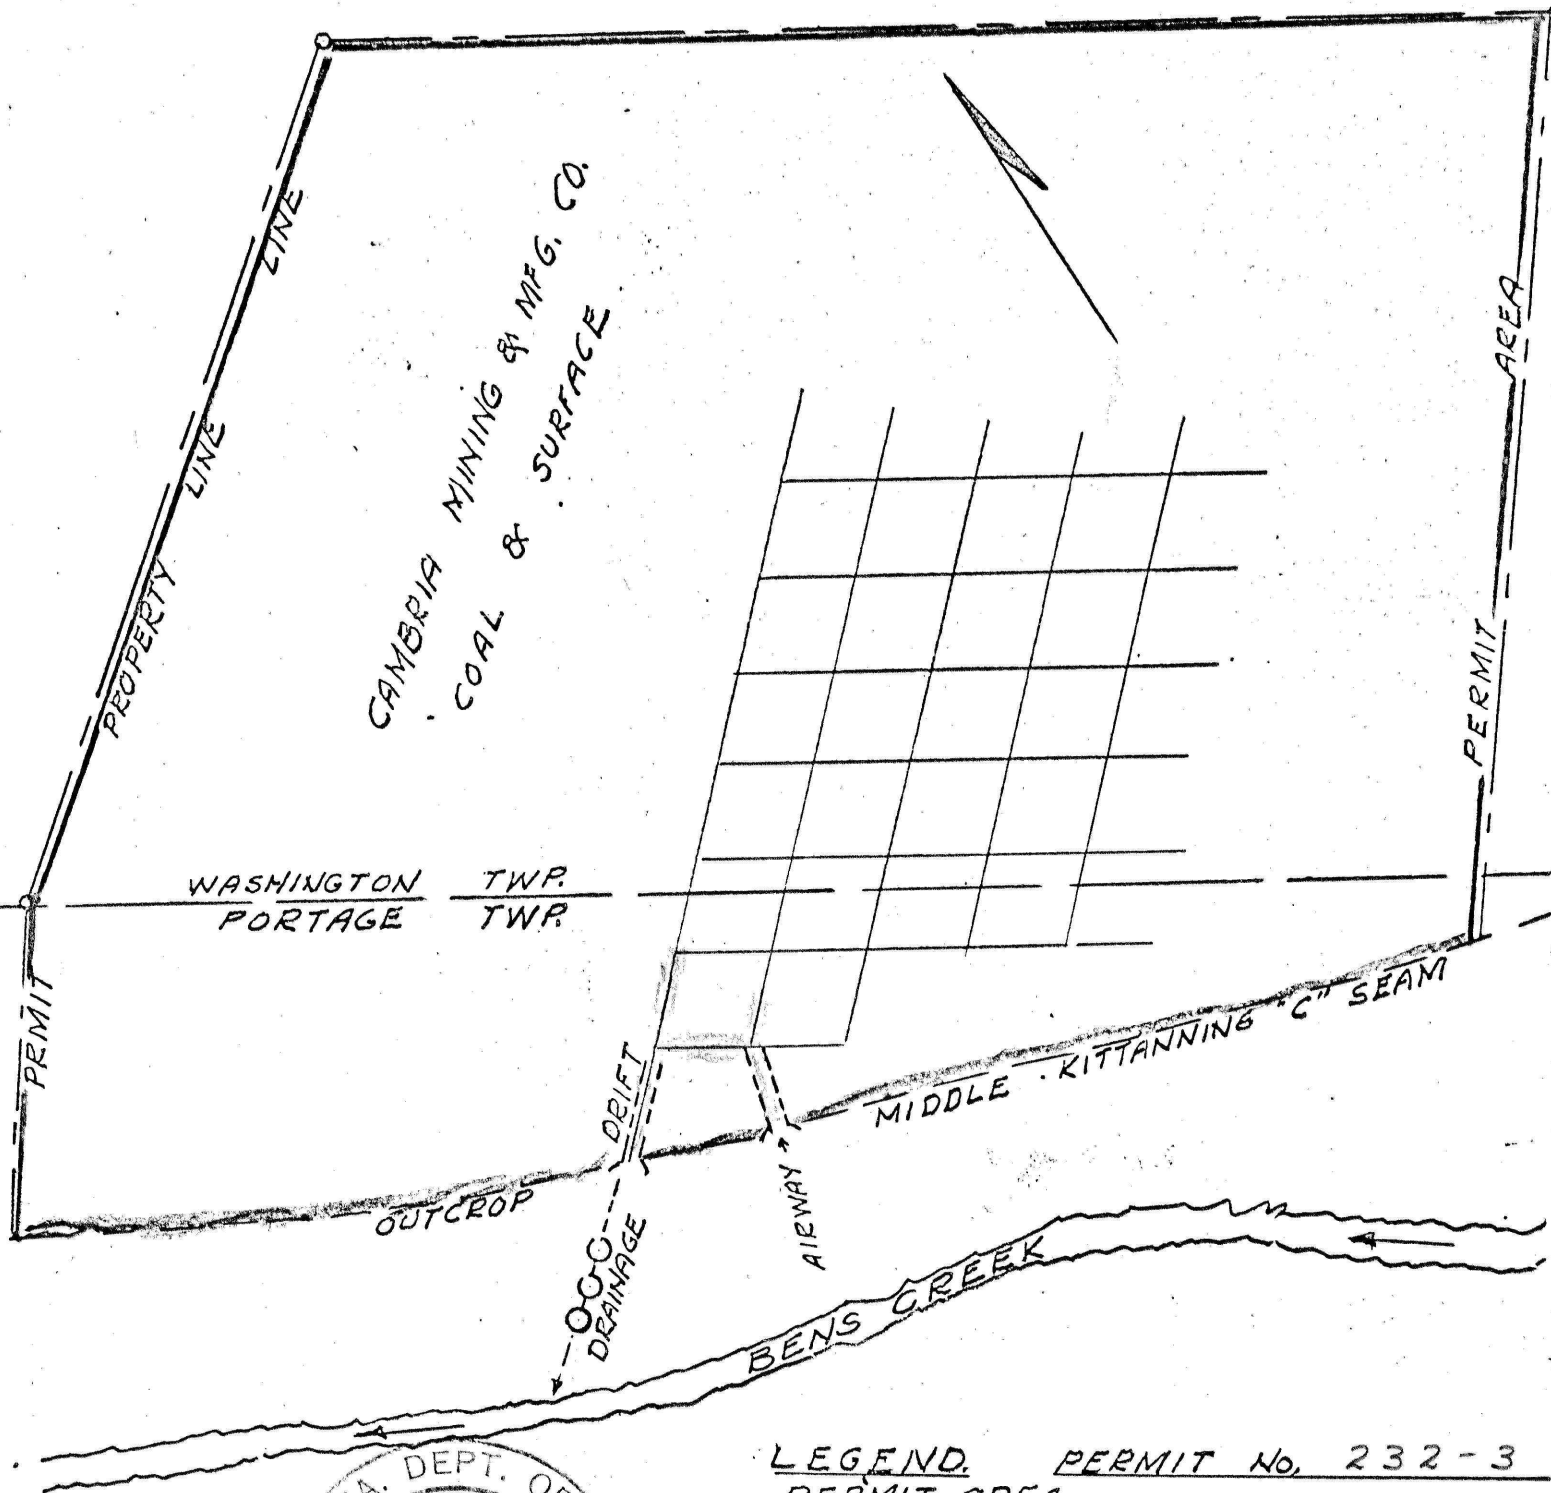


LEGEND. PERMIT No. 232-3

PERMIT AREA


MINING COMPLETED

PROPOSED WORK NEXT SIX MONTHS 1-31-72

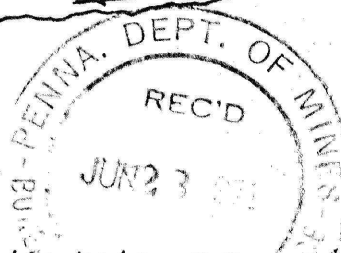

MAP SHOWING PROPOSED WORKINGS
H.W.Z. COAL COMPANY DRIFT MINE
IN MIDDLE KITTANNING "C" SEAM
PORTAGE & WASHINGTON TWP'S.
CAMBRIA COUNTY PA.

Benscreek
#3 Mine

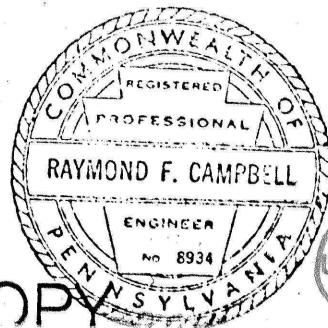

JUNE-17-1971 SCALE 1" = 100'

R. F. Campbell R.P.E.

OFFICE COPY

#219
6-8-99
C.C.