


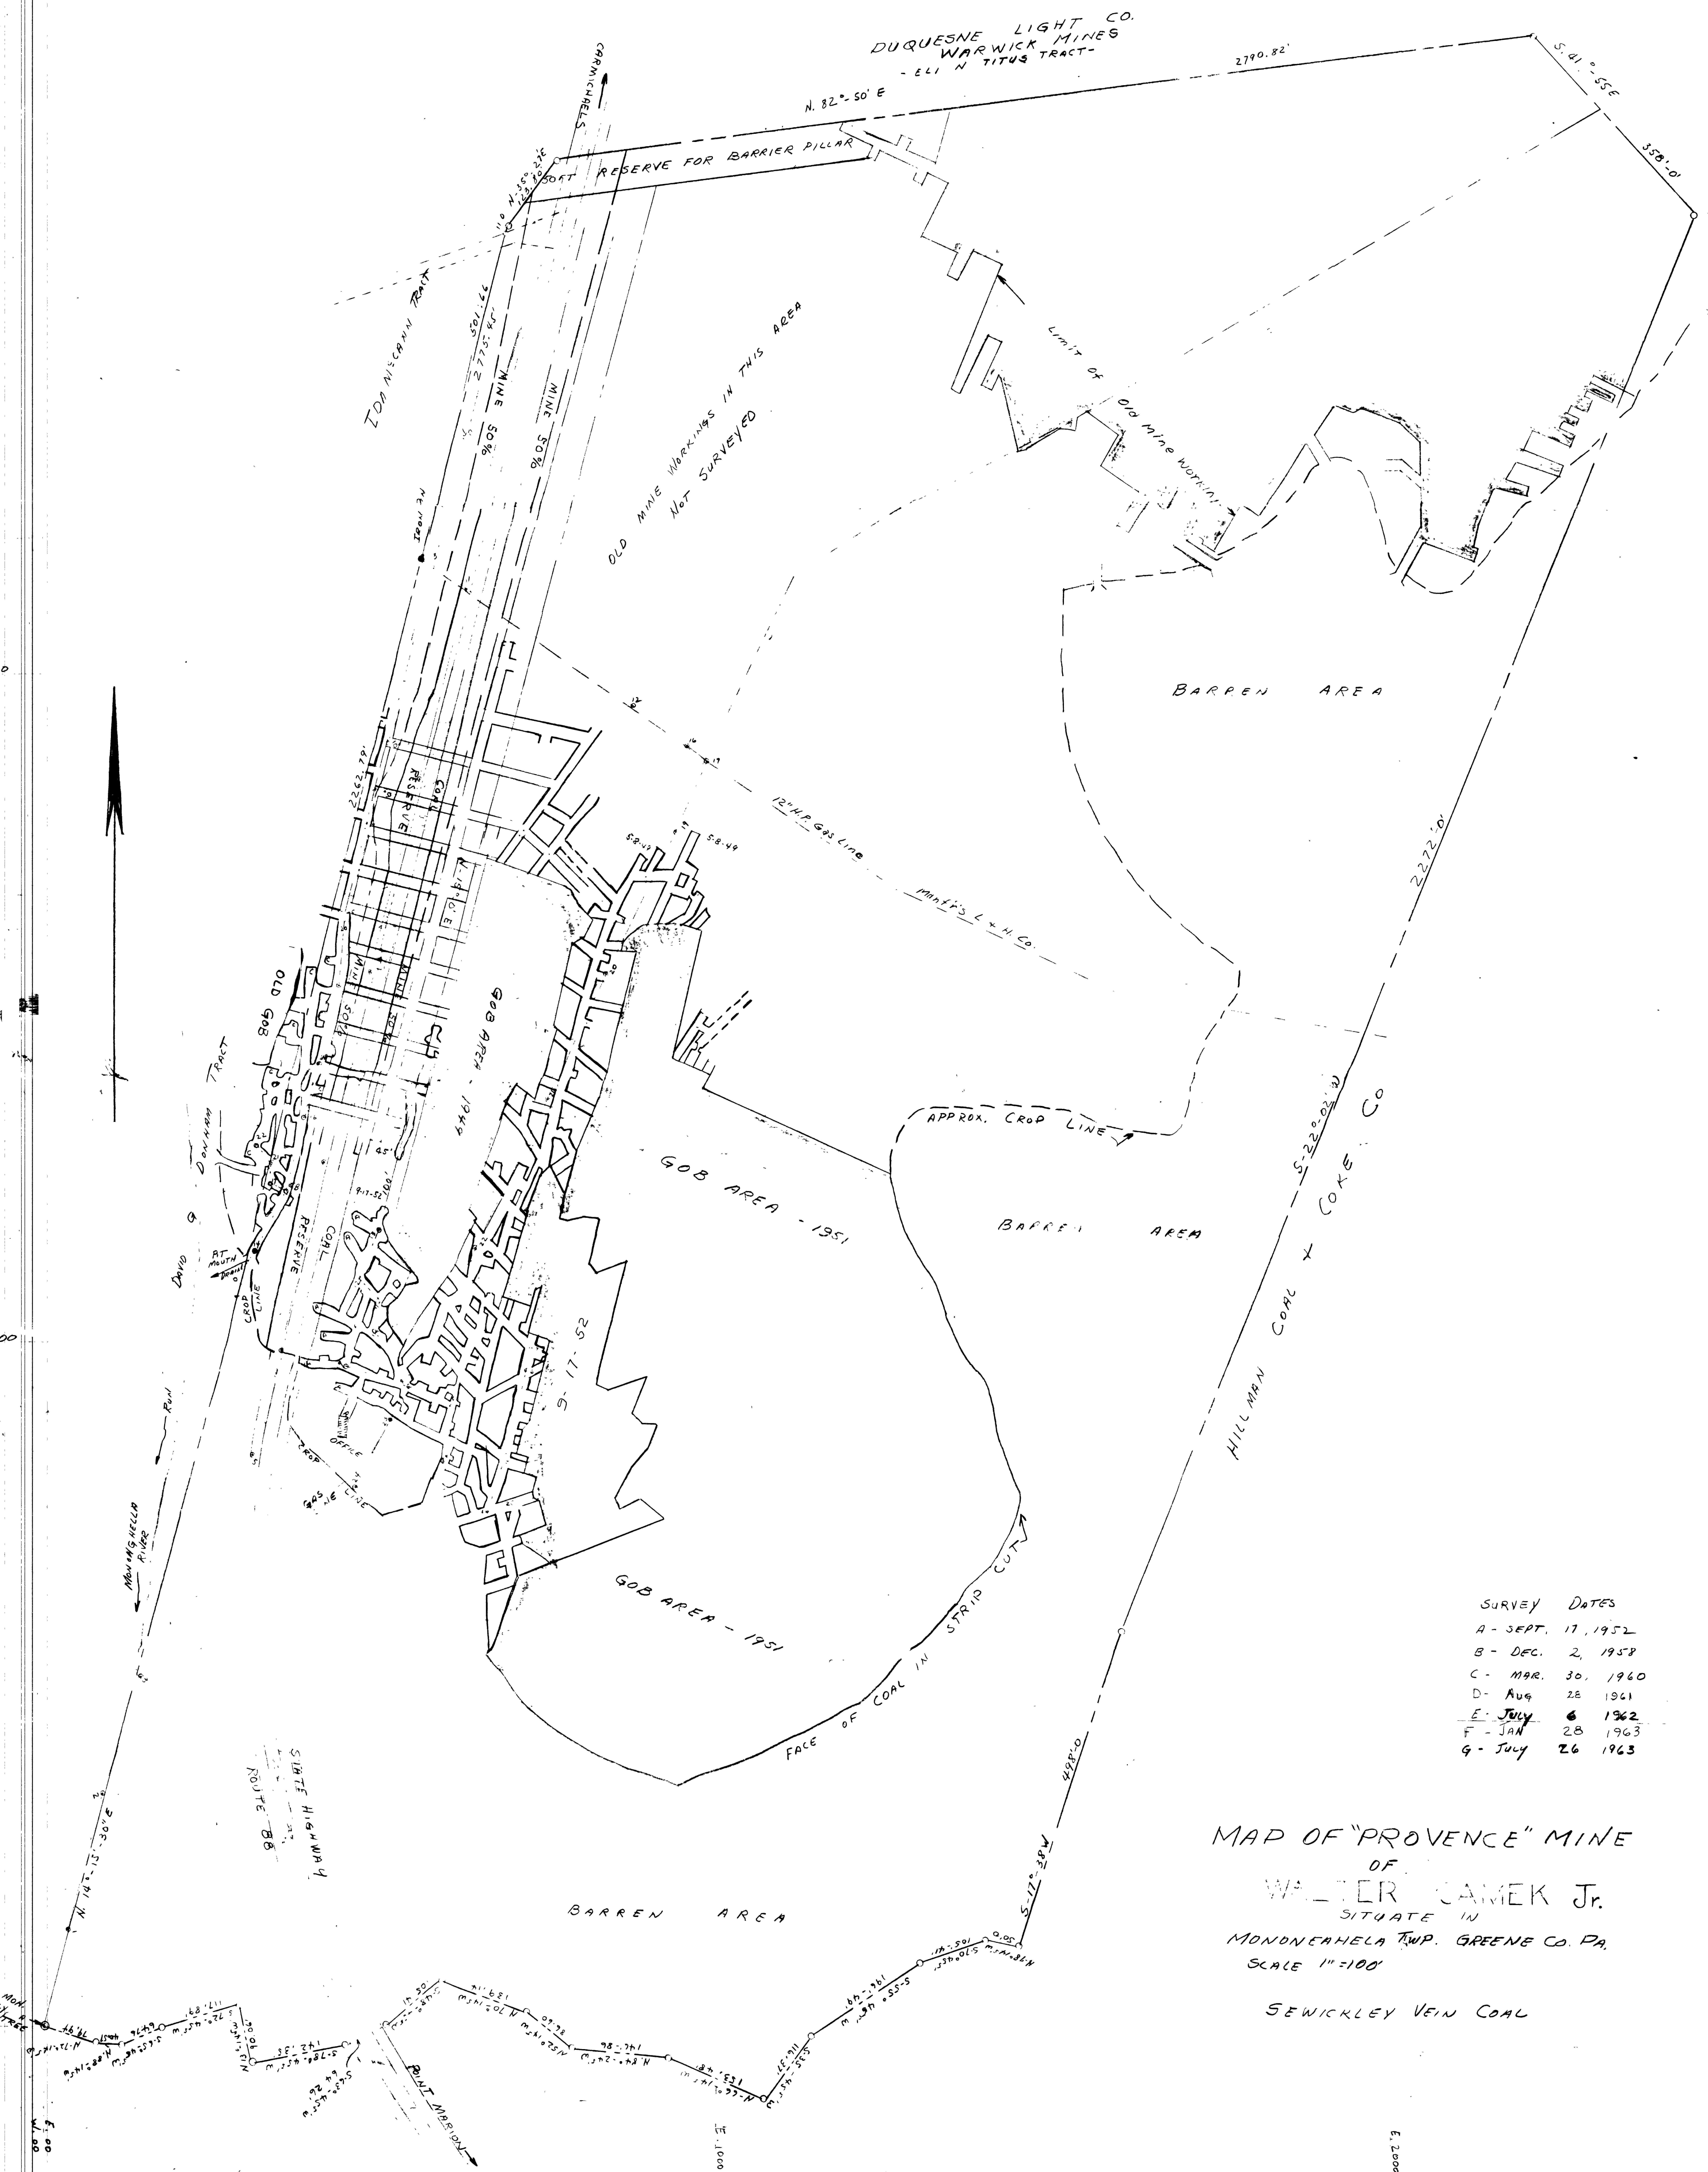

MAP OF "PROVENCE" MINE
OF
WALTER CAMEK Jr.
SITUATE IN
MONDNEAHELA TWP. GREENE CO. PA.
SCALE 1"=100'

SEWICKLEY VEIN COAL