

M. J. YASENOSKY, Owner.

Mined Out 1925.

Donald Mine, National Fuel Co.

Yes:
Mining will be splitting existing blocks,
and no rib, or fracture line, will be made.


Mining Completed.
Coal & Surface owned by
Ford & Gaskill.

No structures on surface overlying proposed mining.
Overburden is draw slate, sandstone, slate & clay.
Overburden is approx. 15' opening, to 100' at peak

DATE-OF-SURVEY		
JULY	16-1918	A
SEPTEMBER	6-1920	B
		C
FEBRUARY	2-1921	D
DECEMBER	10-1922	E
SEPTEMBER	24-1923	F
JANUARY	28-1924	G
NOVEMBER	18-1924	H
DECEMBER	15-1924	I
JAN. 15	1925	J

PROVINS MINE
PROVINS COAL CO.
NICHOLSON TWP FAYETTE CO., PA.
SCALE 1"=200'

SOUTH PENN ENGINEERING CO.
UNIONTOWN - PENNA.

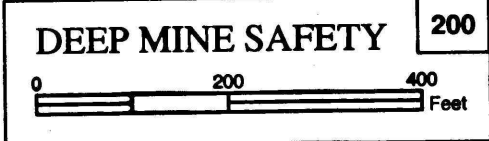

Taylor & Taylor, Engr. Assoc. Macon, Pa.
Legend.
Green indicates lease lines.
Red indicates E.M. protection.

2277
#2277
12-21-94
C.C.