


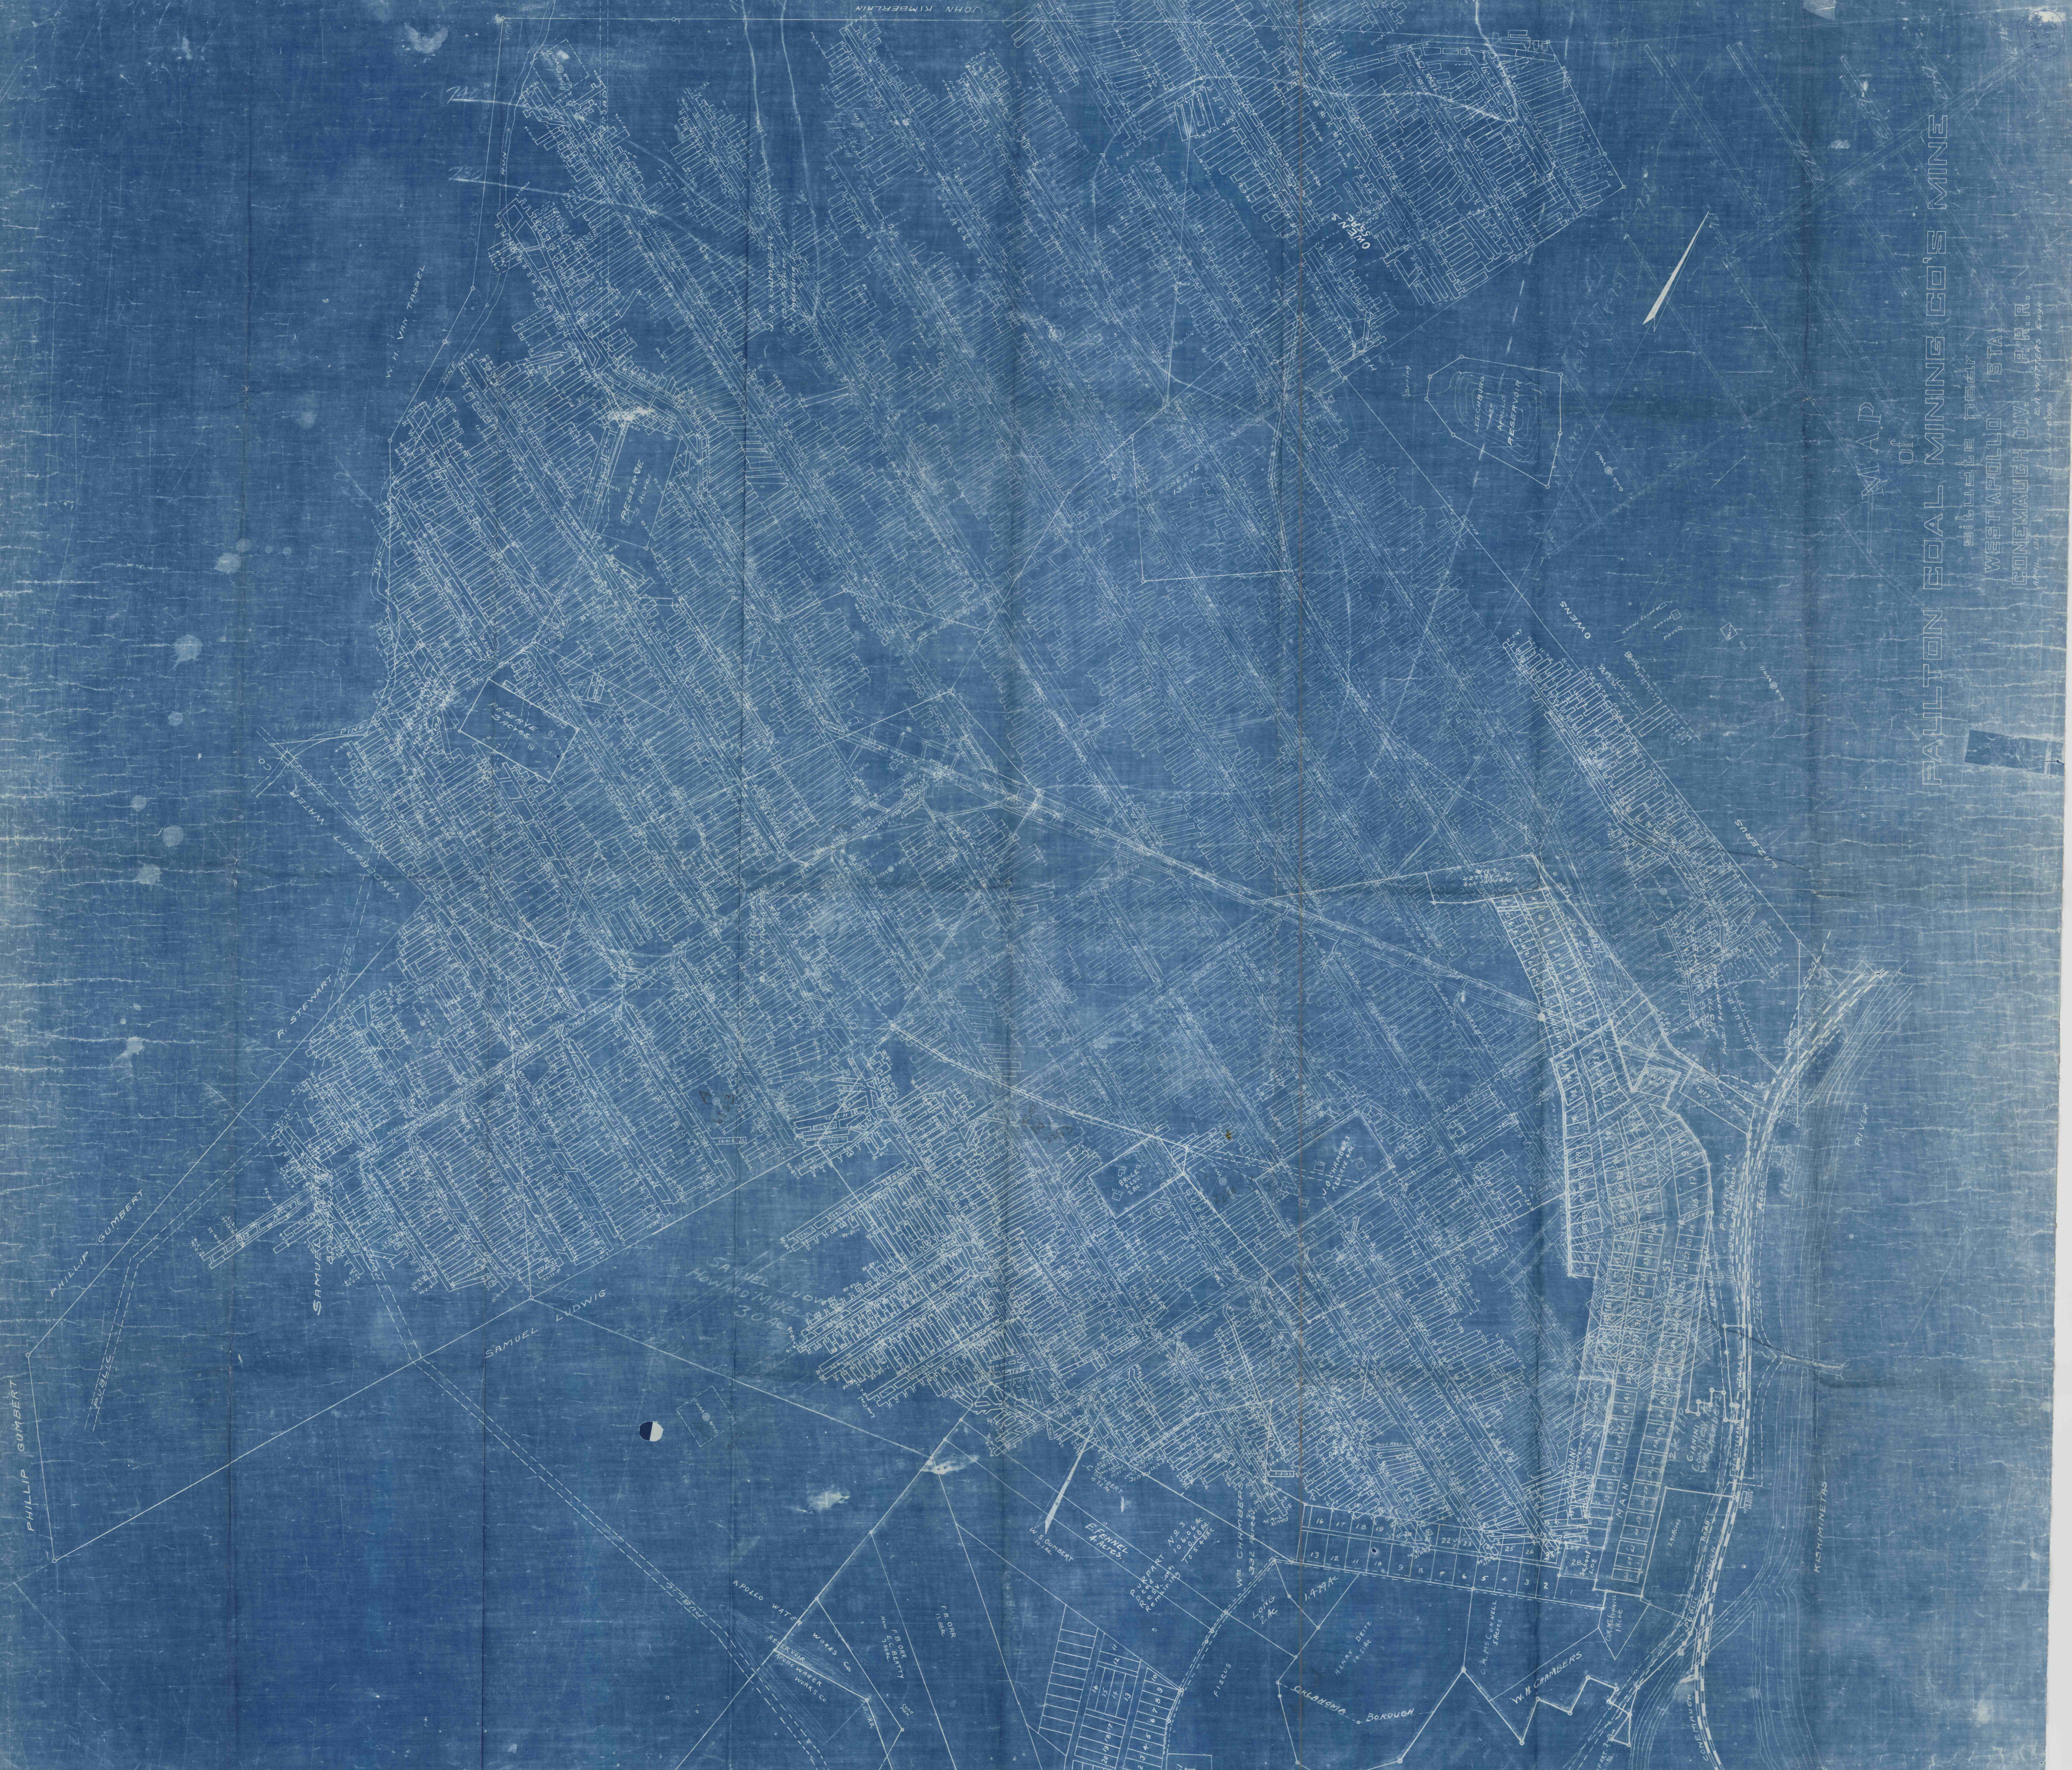

FULTON COAL MINING CO.'S MINE

MAP of

SITUATED NEAR
WESTAPOLLO STA.
E.A. WITTE'S COPY

