
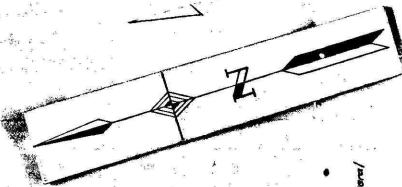


2015 21637932
2015 21637932
2015 21637932

Nick Barndt

C Outcrop

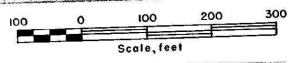

S.C. Berkebile Surface
Coleman & Gudelberger Mine

Old Hopkins
Caved - abandoned

2.00 Ac. Reservation

C Outcrop

INDEX TO SURVEYS

SURVEY	DATE
B	7-15-59
C	6-1-65
D	3-15-67

BERKEBILE BROS. COAL CO.
FORMERLY THE B. QUALITY COAL CO.
C PRIME MINE
SHADE TWP., SUMMERSET CO., PA.
SCALE 1"=100' - REVISED BY S. HICKY & CO. - SEPT. 27, 1950
CIVIL AND MINING ENGINEERS
JOHNSTOWN, PA.

Note: Survey "D" from information furnished - T.L.L.

Note: Survey "C" from information furnished - T.L.L.

84A-181
F.B. 325 P4.47