


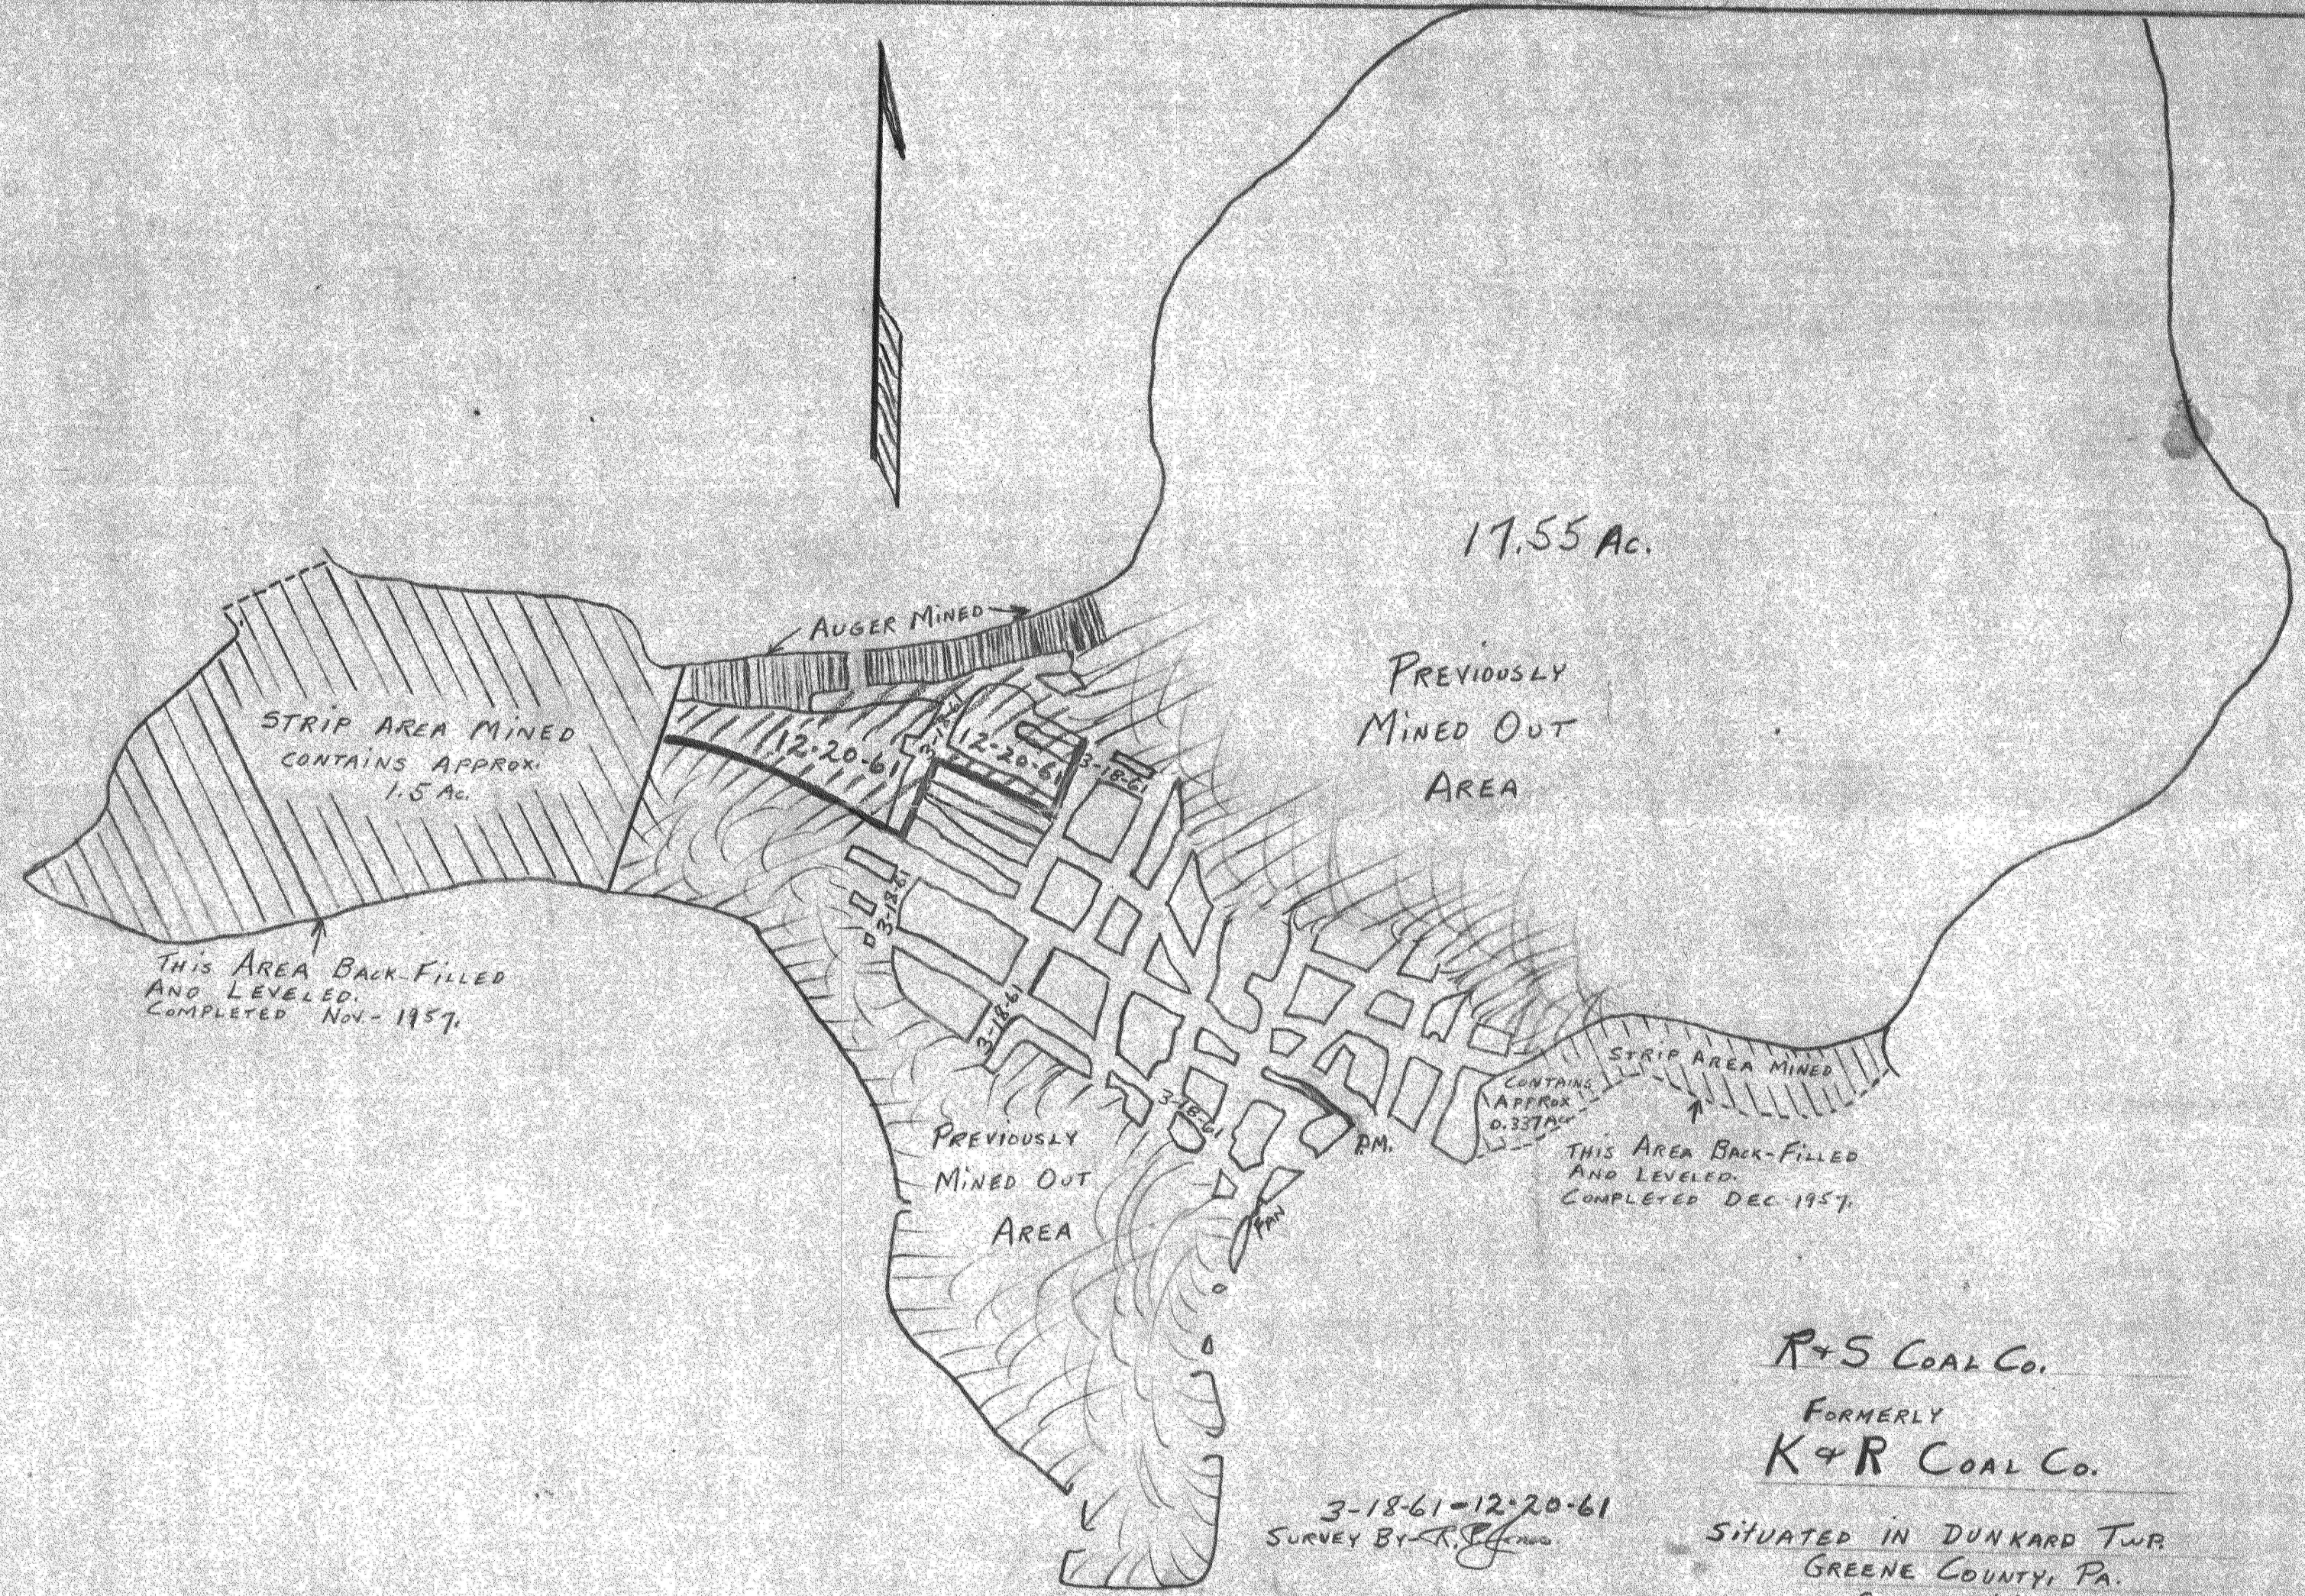

3-18-61-12-20-61
SURVEY BY R. J. [signature]

R+S COAL CO.
FORMERLY
K+R COAL CO.

SITUATED IN DUNKARD TWP.
GREENE COUNTY, PA.
SCALE - 1"=100'