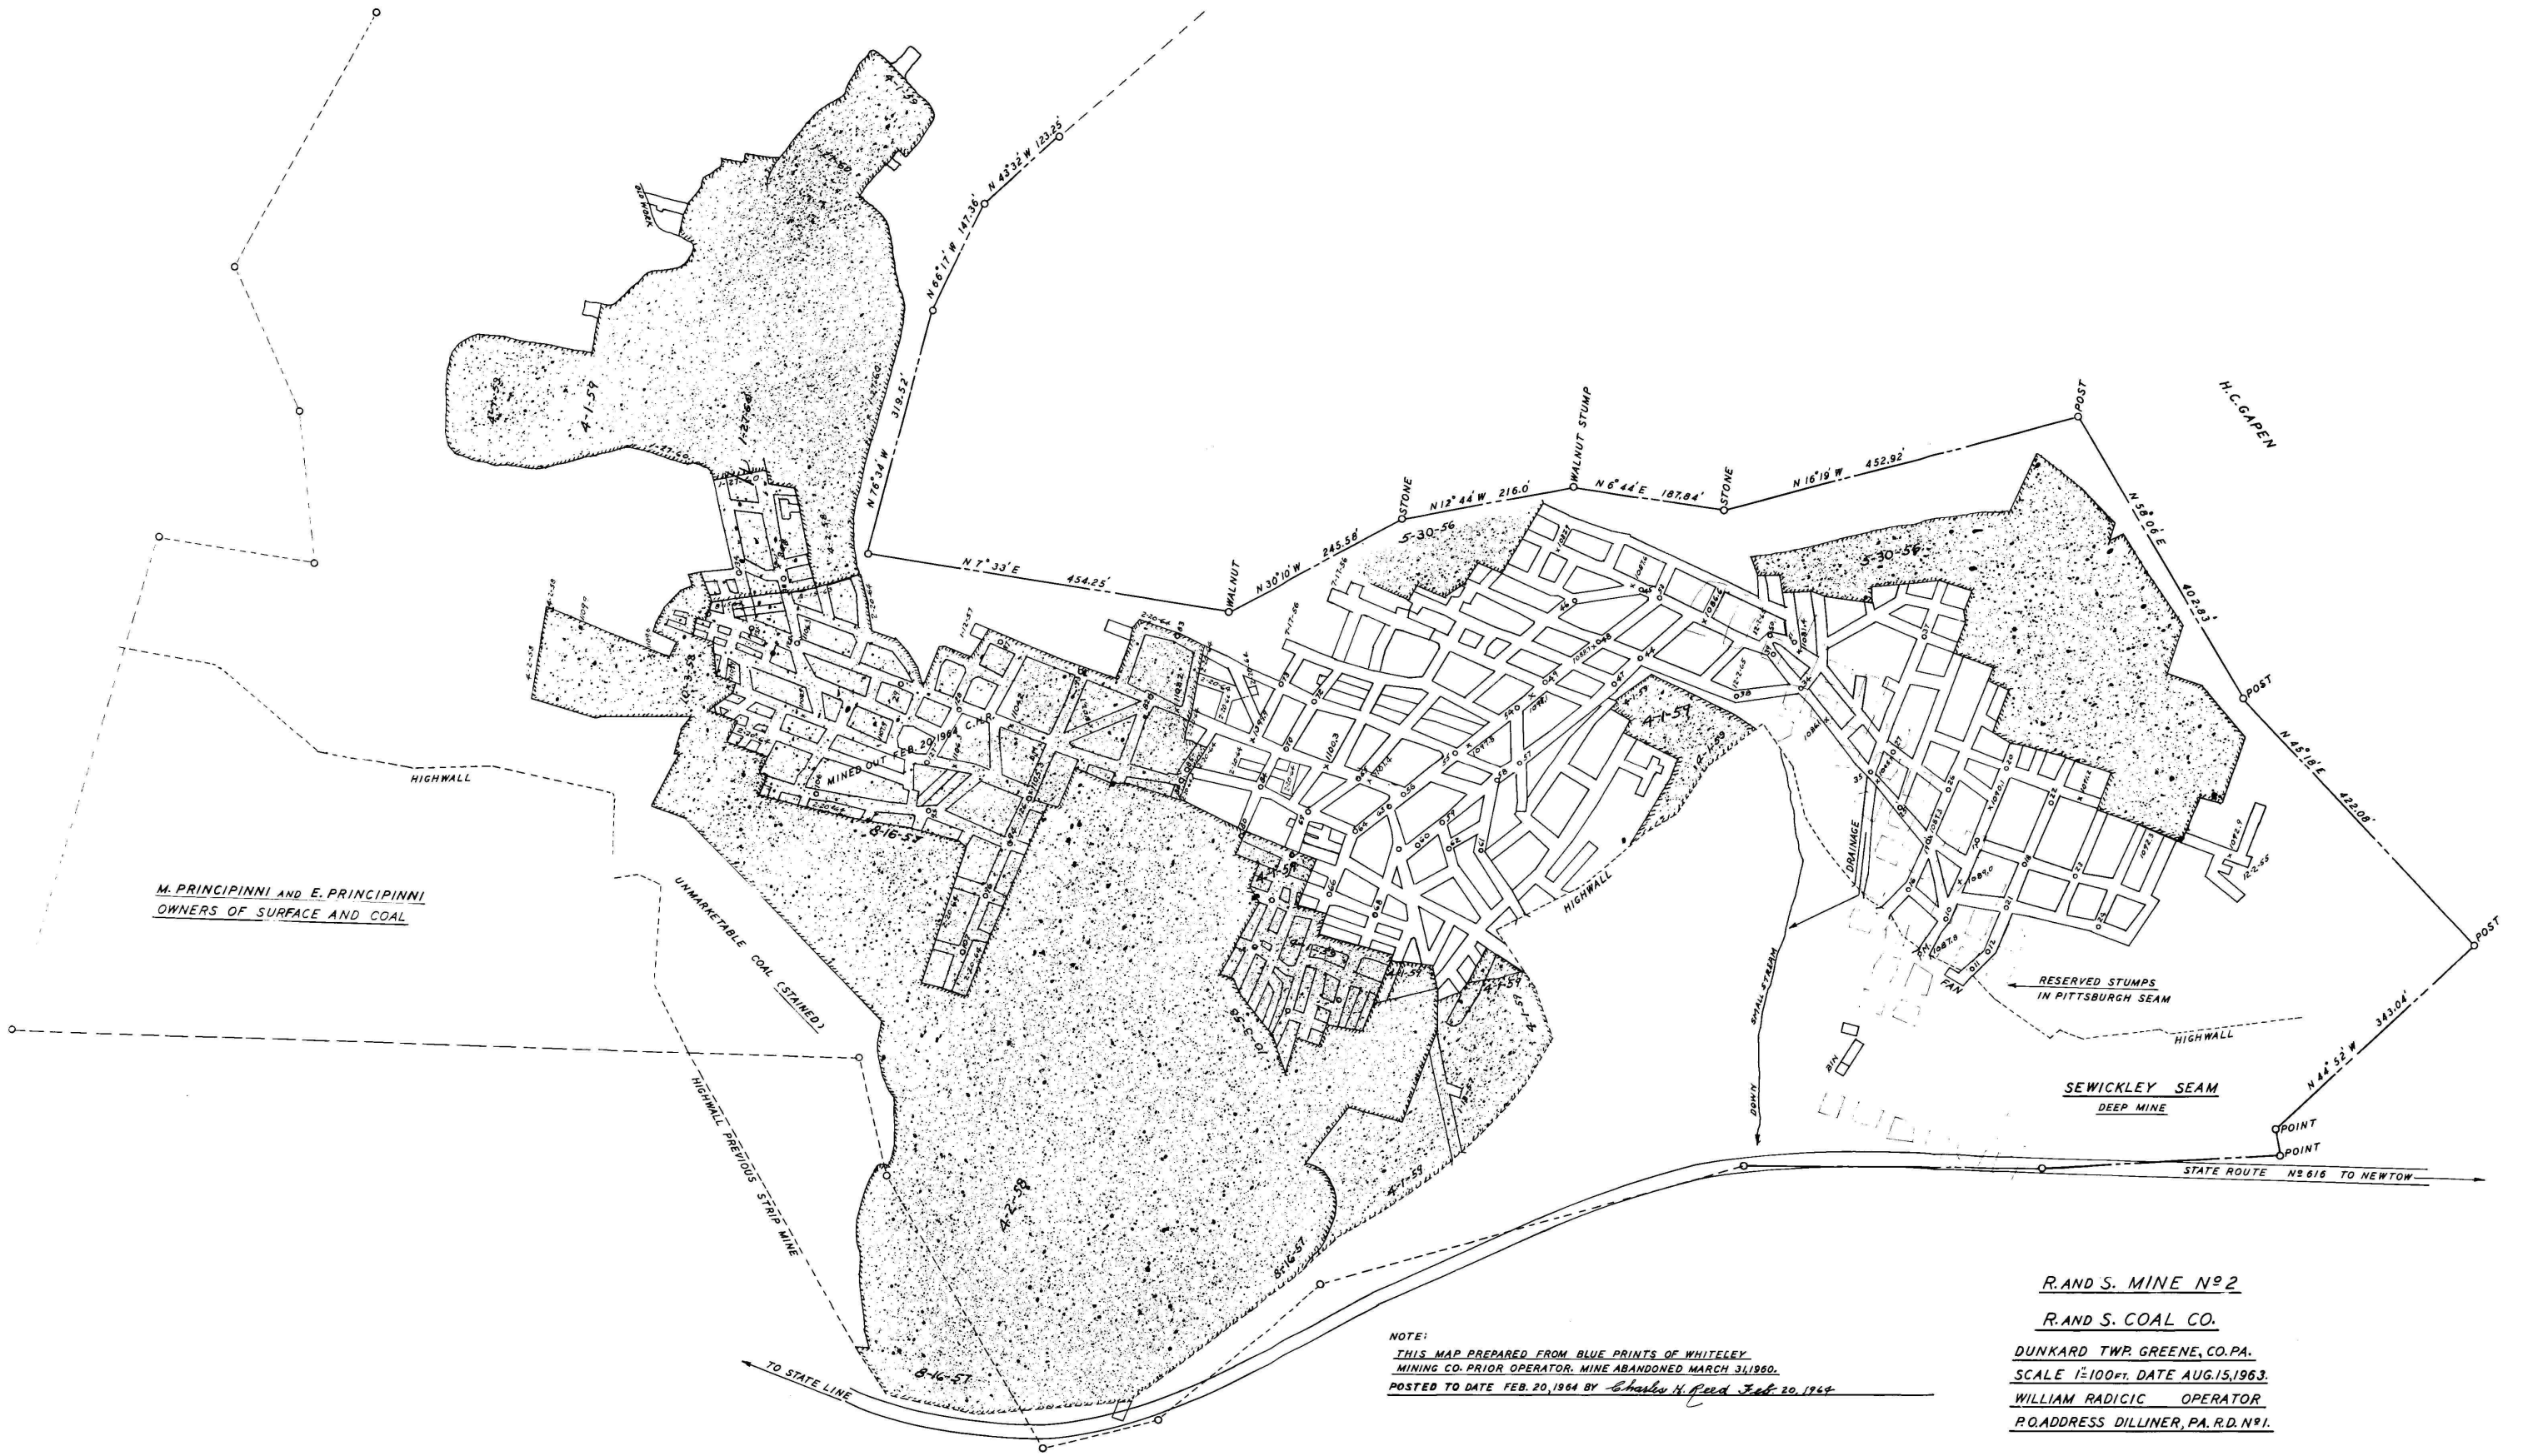

NOTE:
THIS MAP PREPARED FROM BLUE PRINTS OF WHITELEY MINING CO. PRIOR OPERATOR. MINE ABANDONED MARCH 31, 1960.
POSTED TO DATE FEB. 20, 1964 BY Charles H. Reed Feb 20, 1964

R. AND S. MINE No 2
R. AND S. COAL CO.
DUNKARD TWP. GREENE, CO. PA.
SCALE 1" = 100 FT. DATE AUG. 15, 1963.
WILLIAM RADICIC OPERATOR
P.O. ADDRESS DILLINER, PA. R.D. No 1.

THIS MAP PREPARED BY Charles H Reed BOBTOWN, PA. aug 15 1963