


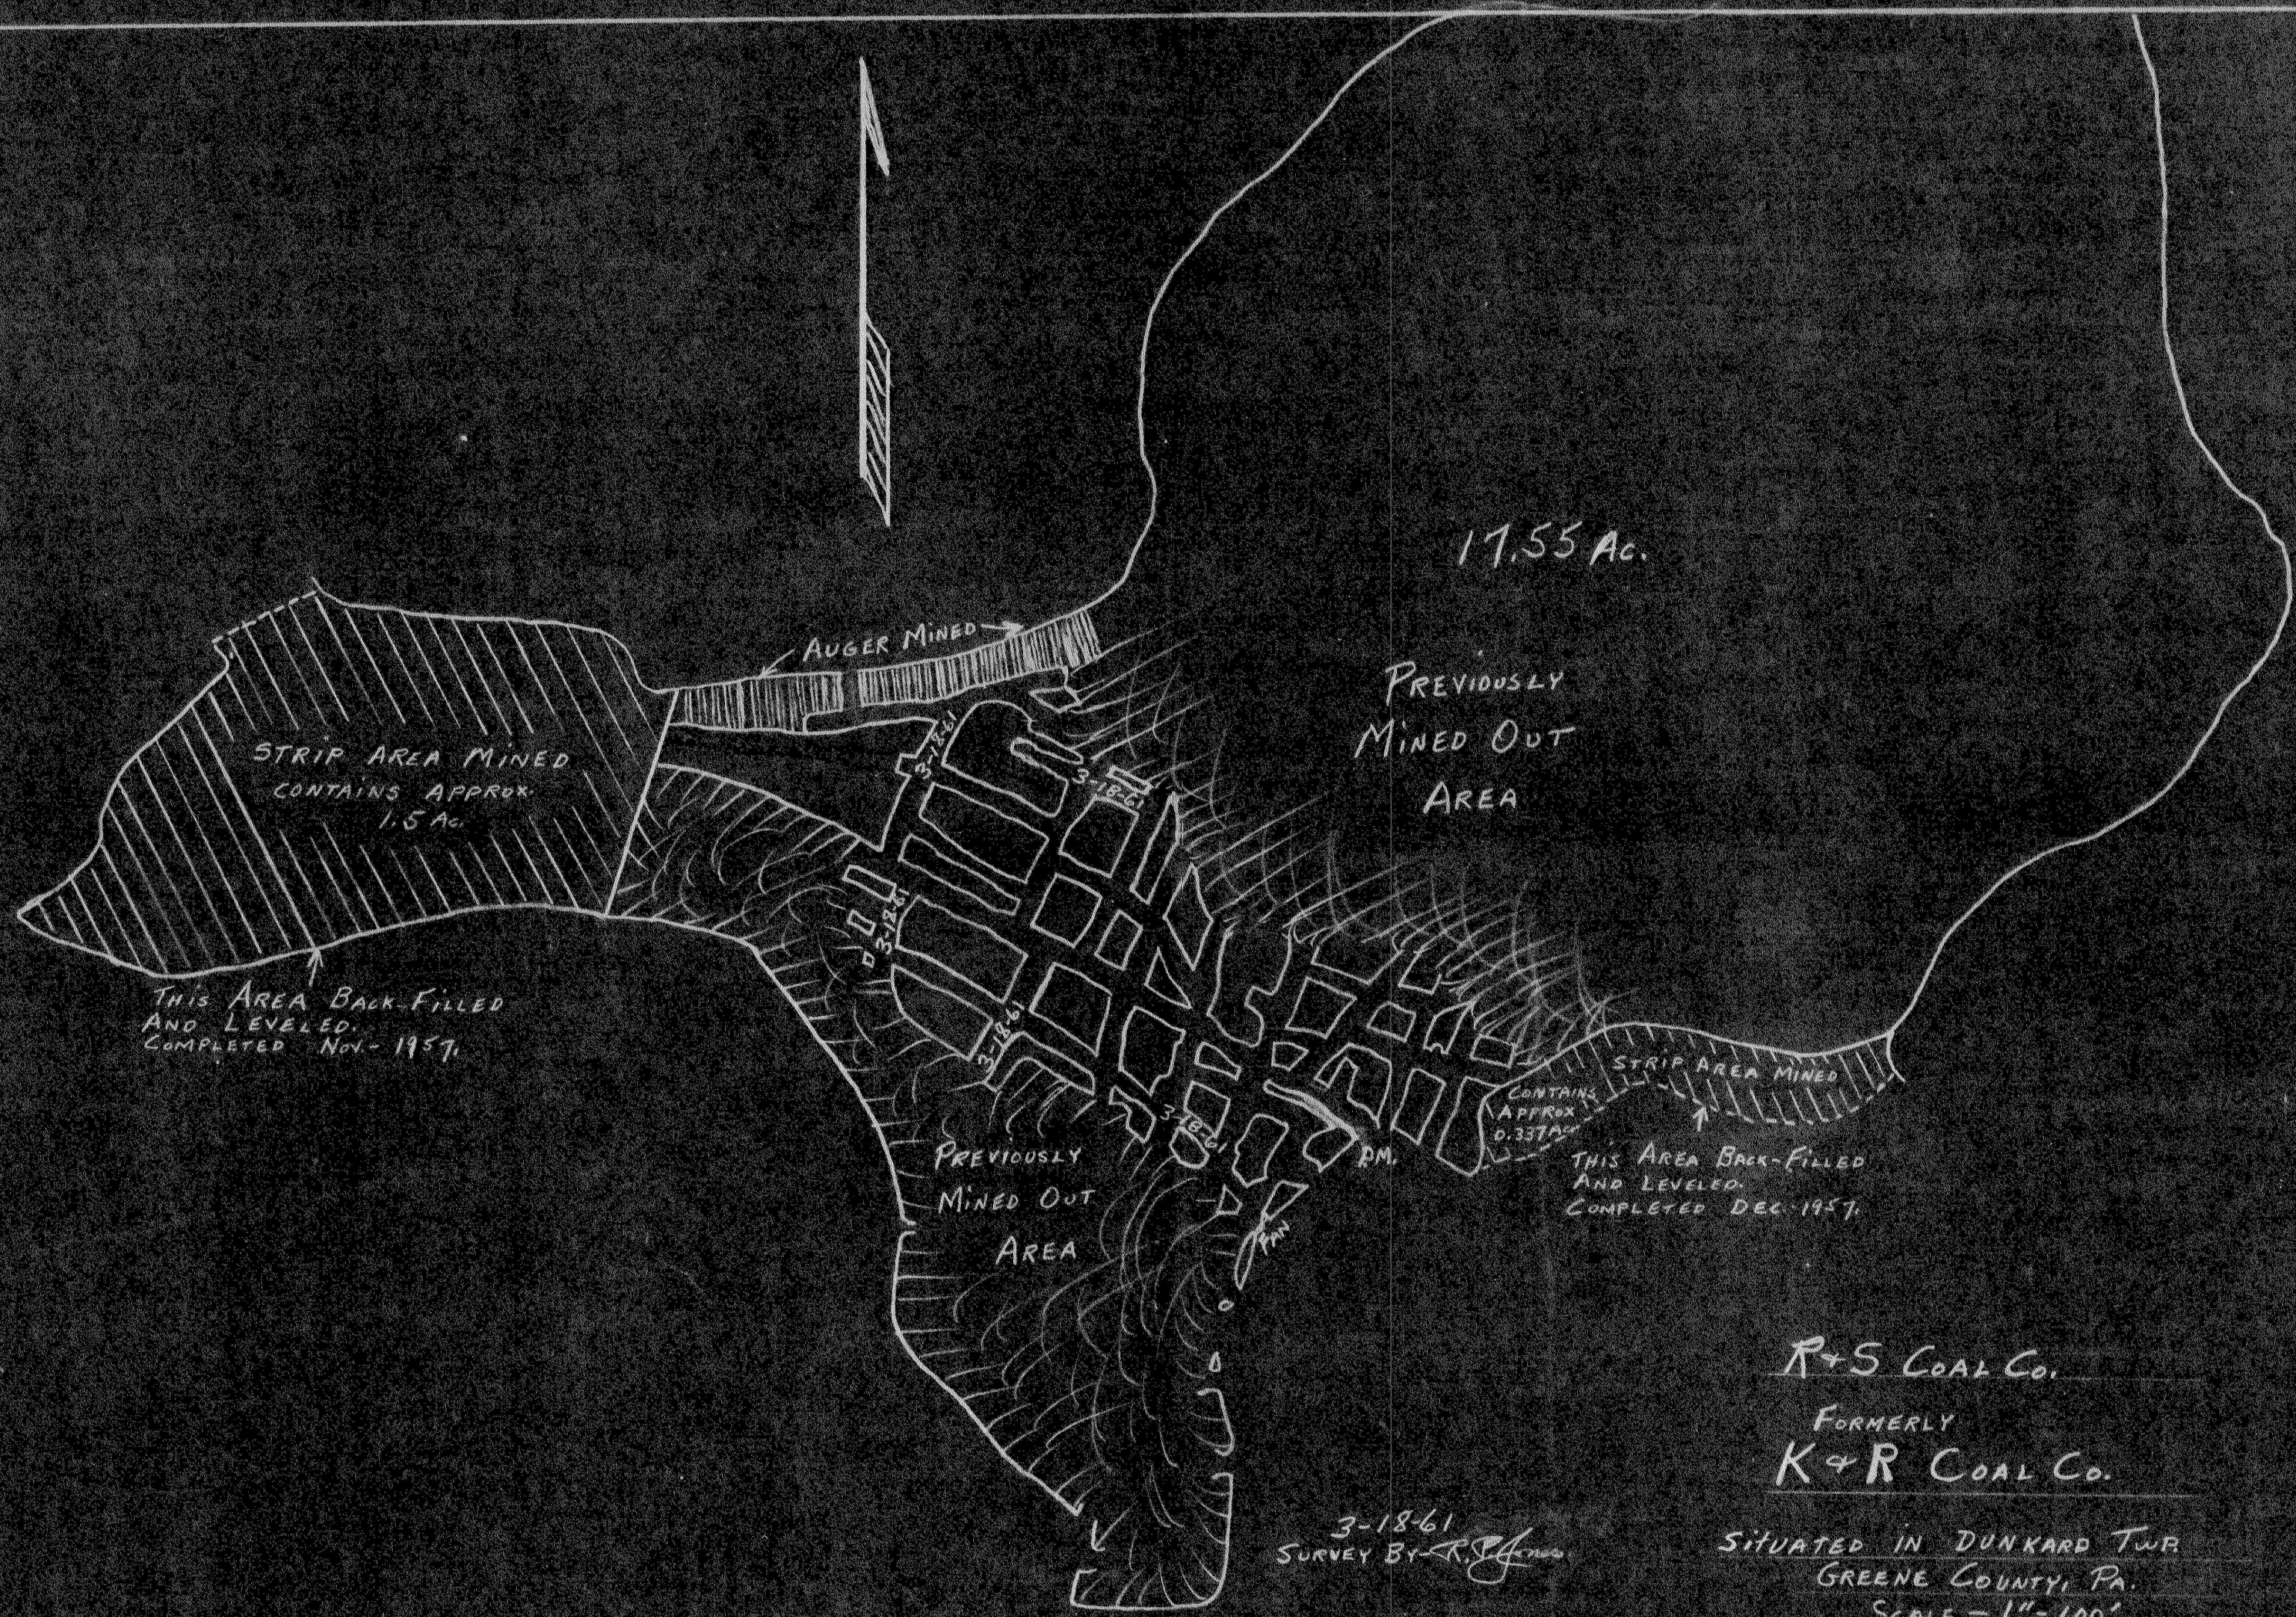

3-18-61
SURVEY BY R. J. [Signature]

R+S COAL CO.
FORMERLY
K&R COAL CO.
SITUATED IN DUNKARD TWP.
GREENE COUNTY, PA.
SCALE - 1"=100'