


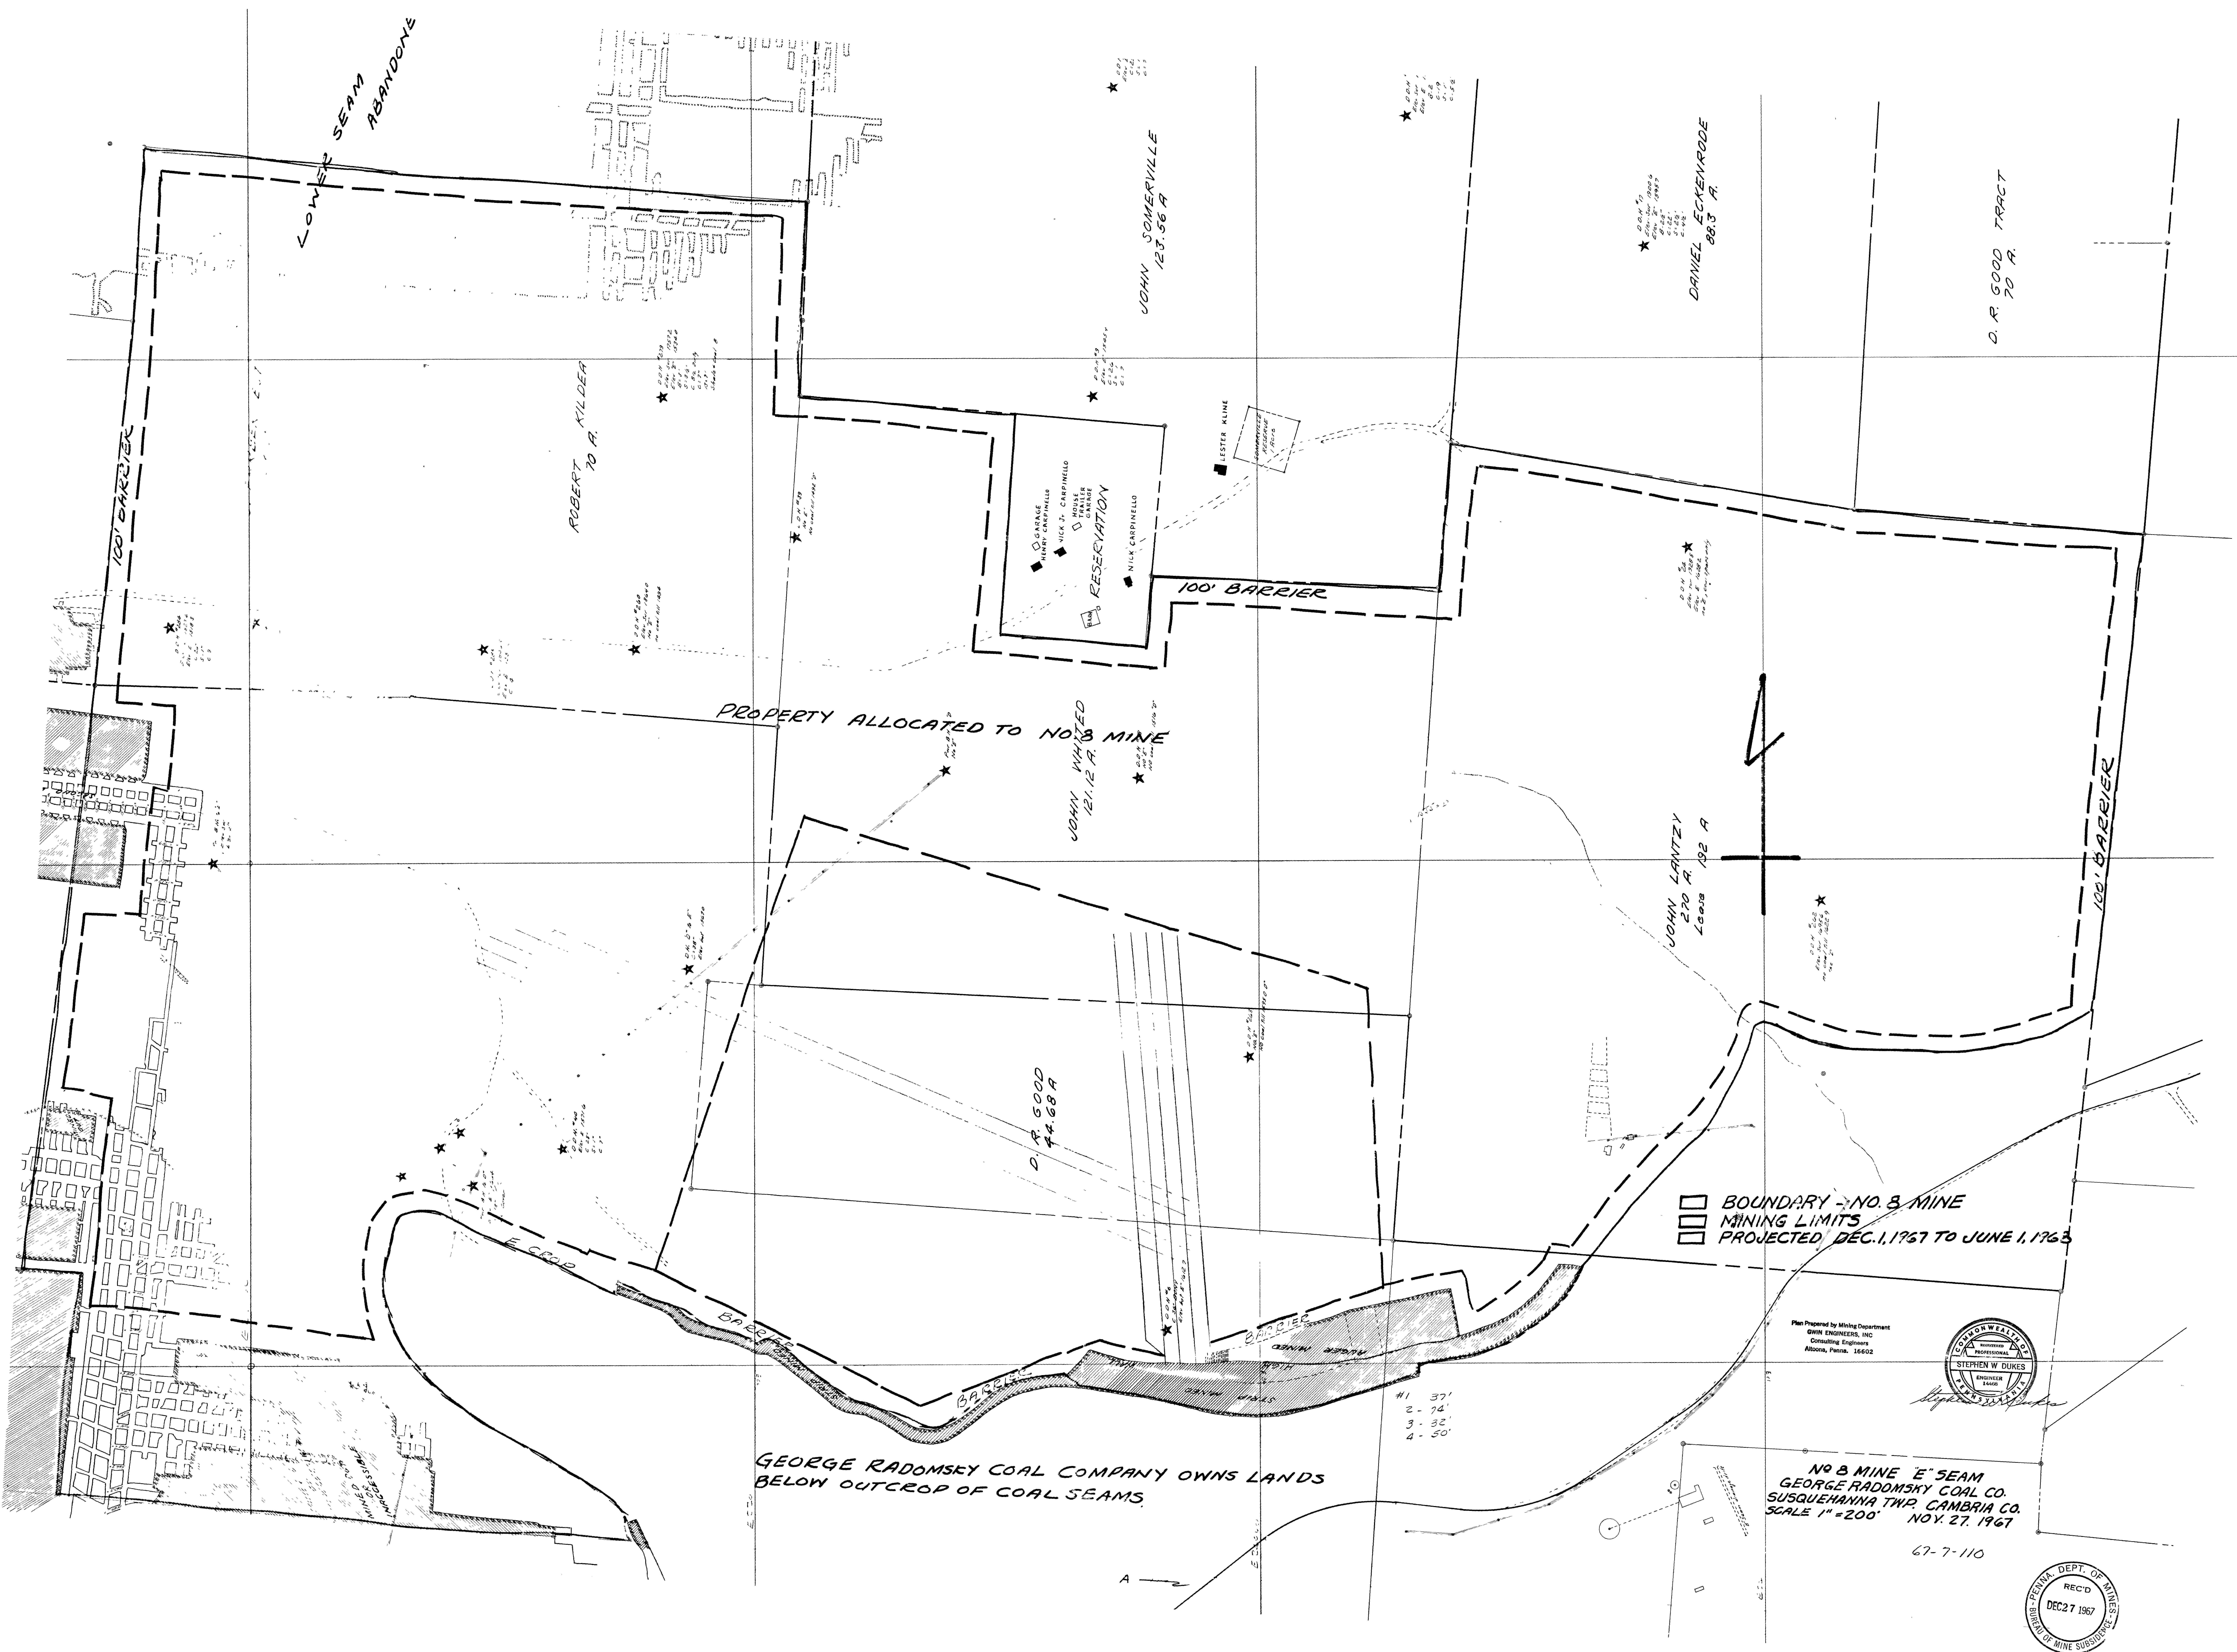

LOWER SEAM
ABANDONED

ROBERT KILDEA
70 A.

JOHN SOMERVILLE
123.56 A.

DANIEL ECKENRODE
88.3 A.

D. R. GOOD TRACT
70 A.

RESERVATION
HENRY CARPINELLO
NICK J. CARPINELLO
HOUSE
GARAGE
NICK CARPINELLO

PROPERTY ALLOCATED TO NO. 8 MINE

121.12 A.


JOHN LANTZY
220 A.

D. R. GOOD
44.68 A.

BOUNDARY - NO. 8 MINE
MINING LIMITS
PROJECTED DEC. 1, 1967 TO JUNE 1, 1968

GEORGE RADOMSKY COAL COMPANY OWNS LANDS
BELOW OUTCROP OF COAL SEAMS

Plan Prepared by Mining Department
GWN ENGINEERS, INC.
Consulting Engineers

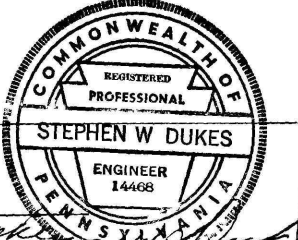

NO. 8 MINE "E" SEAM
GEORGE RADOMSKY COAL CO.
SUSQUEHANNA TWP. CAMBRIA CO.
SCALE 1" = 200' NOV. 27, 1967

67-7-110

