


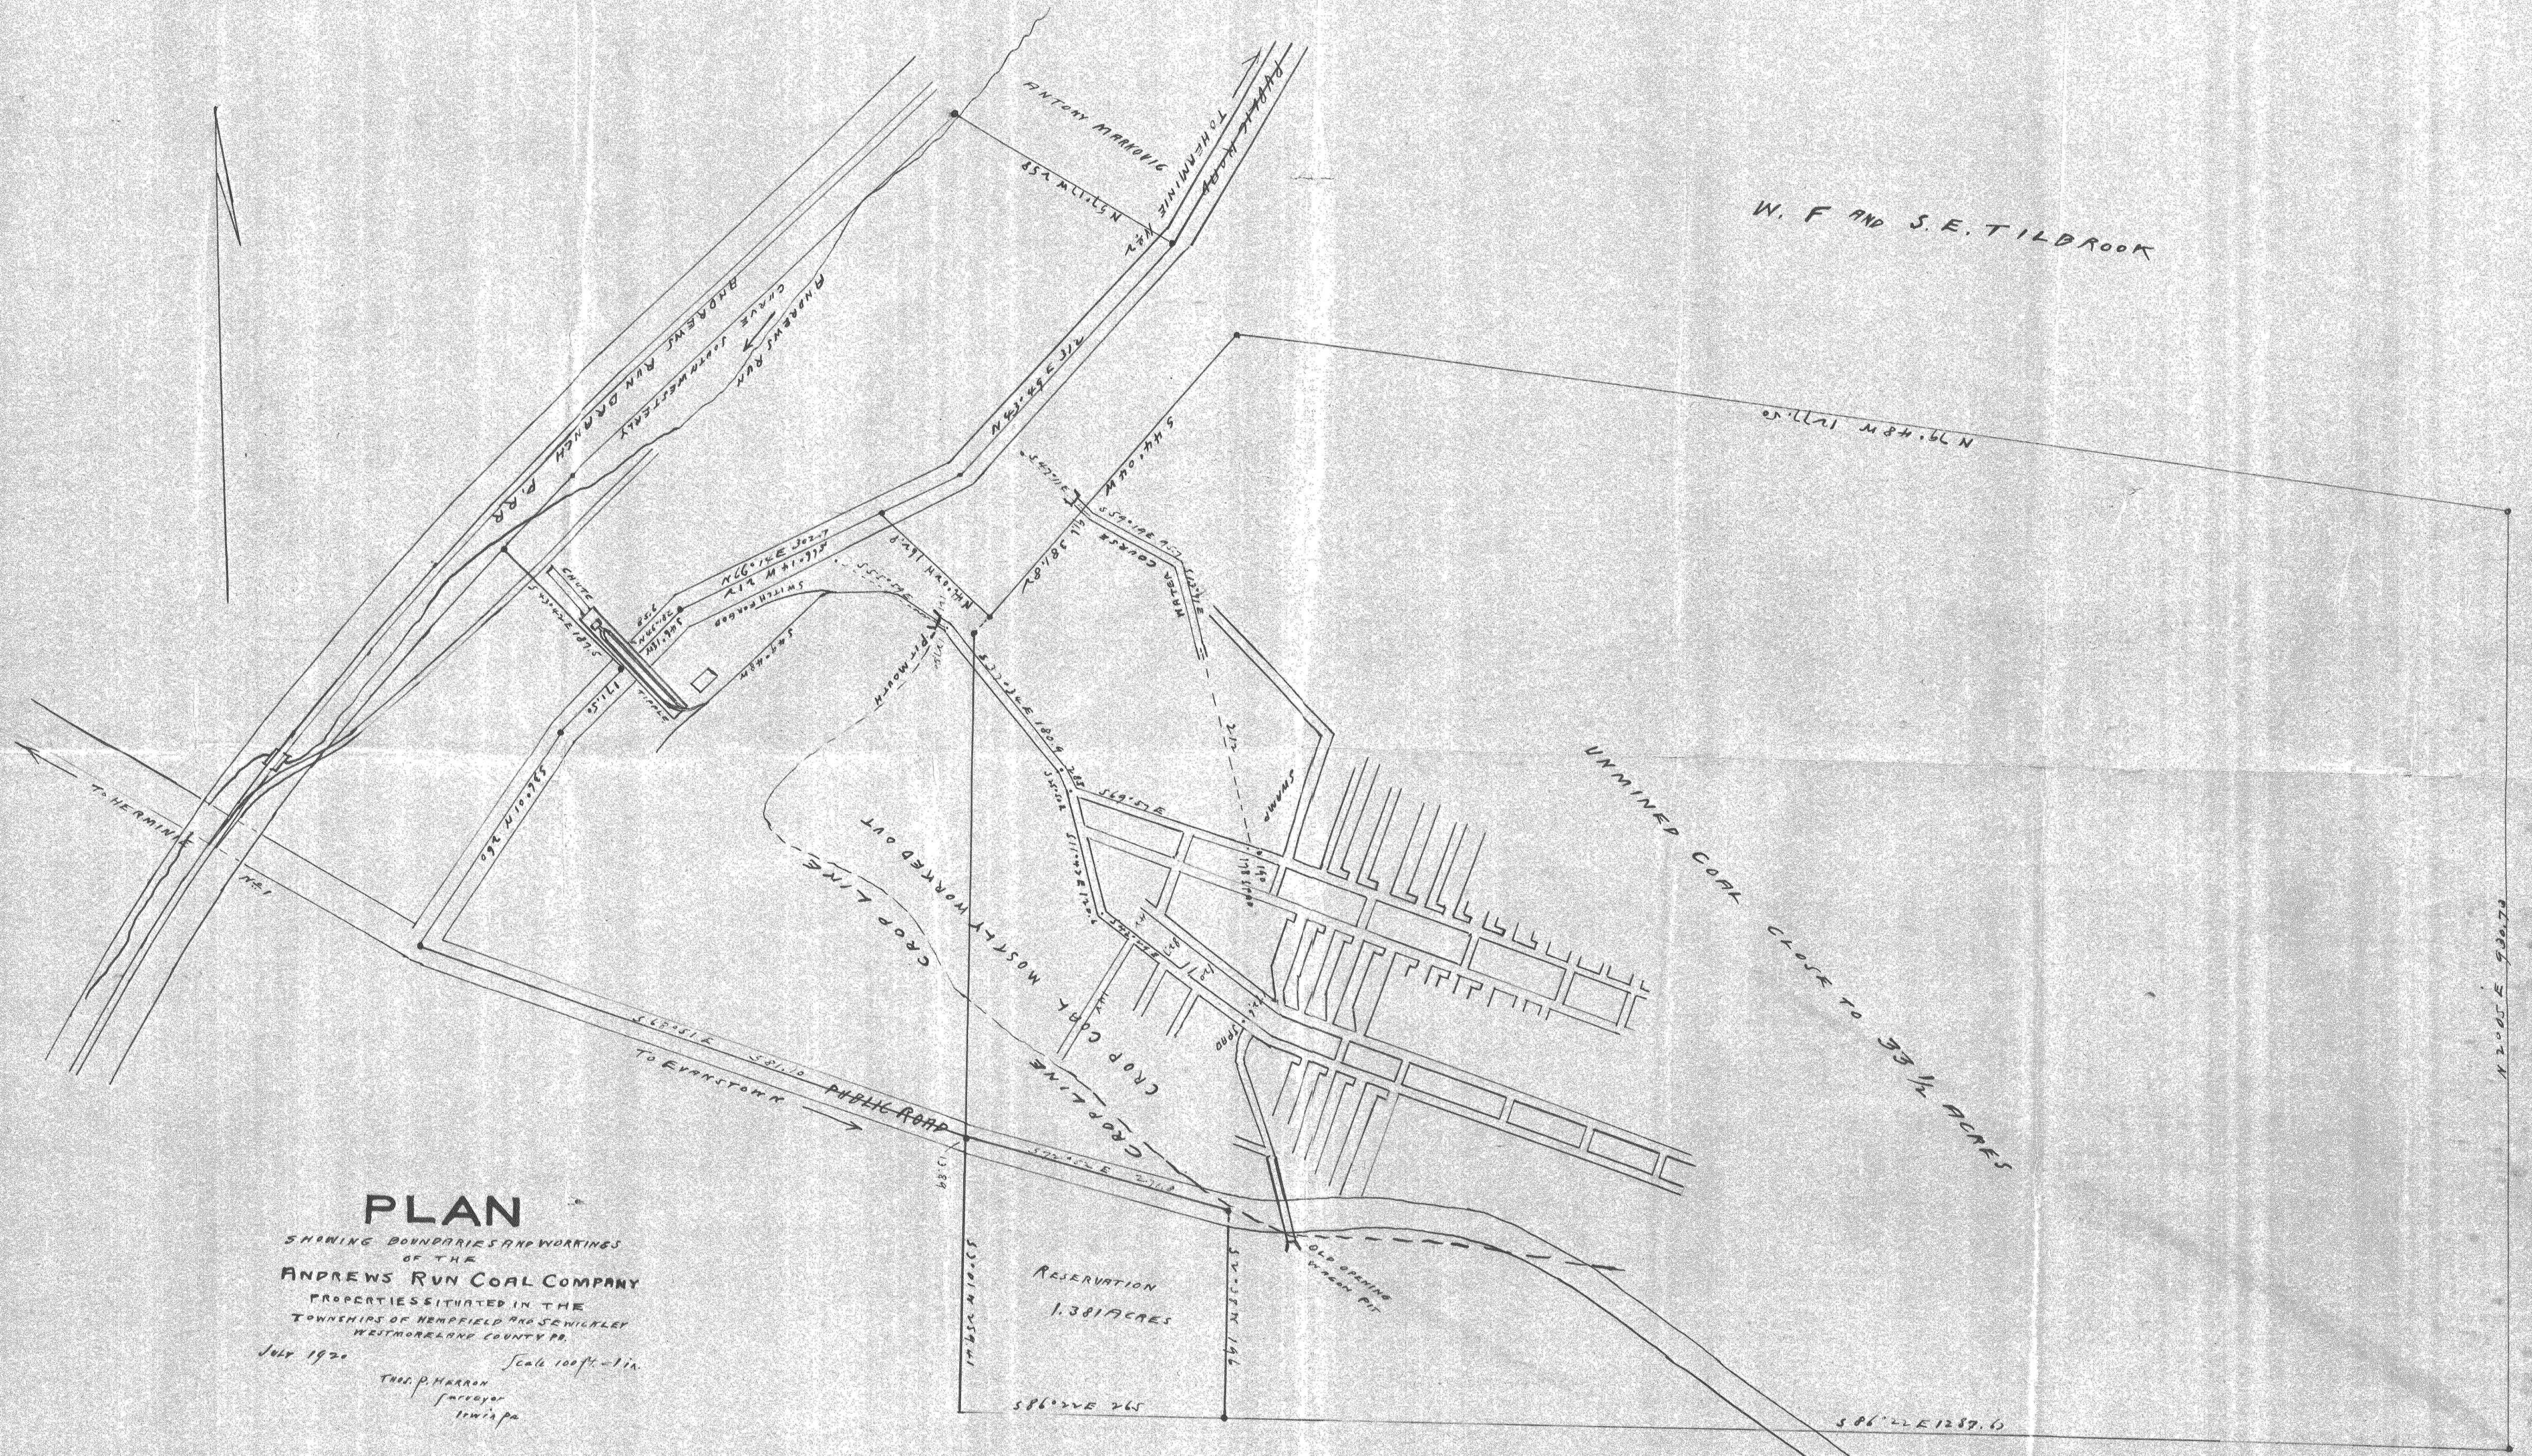

W. F AND S. E. TILBROOK


PLAN
SHOWING BOUNDARIES AND WORKINGS
OF THE
ANDREWS RUN COAL COMPANY
PROPERTY SITUATED IN THE
TOWNSHIPS OF HEMPFIELD AND SEWICKLEY
WESTMORELAND COUNTY PA.
JULY 1920
Scale 100 ft. = 1 in.
THOS. P. HARRON
SURVEYOR

