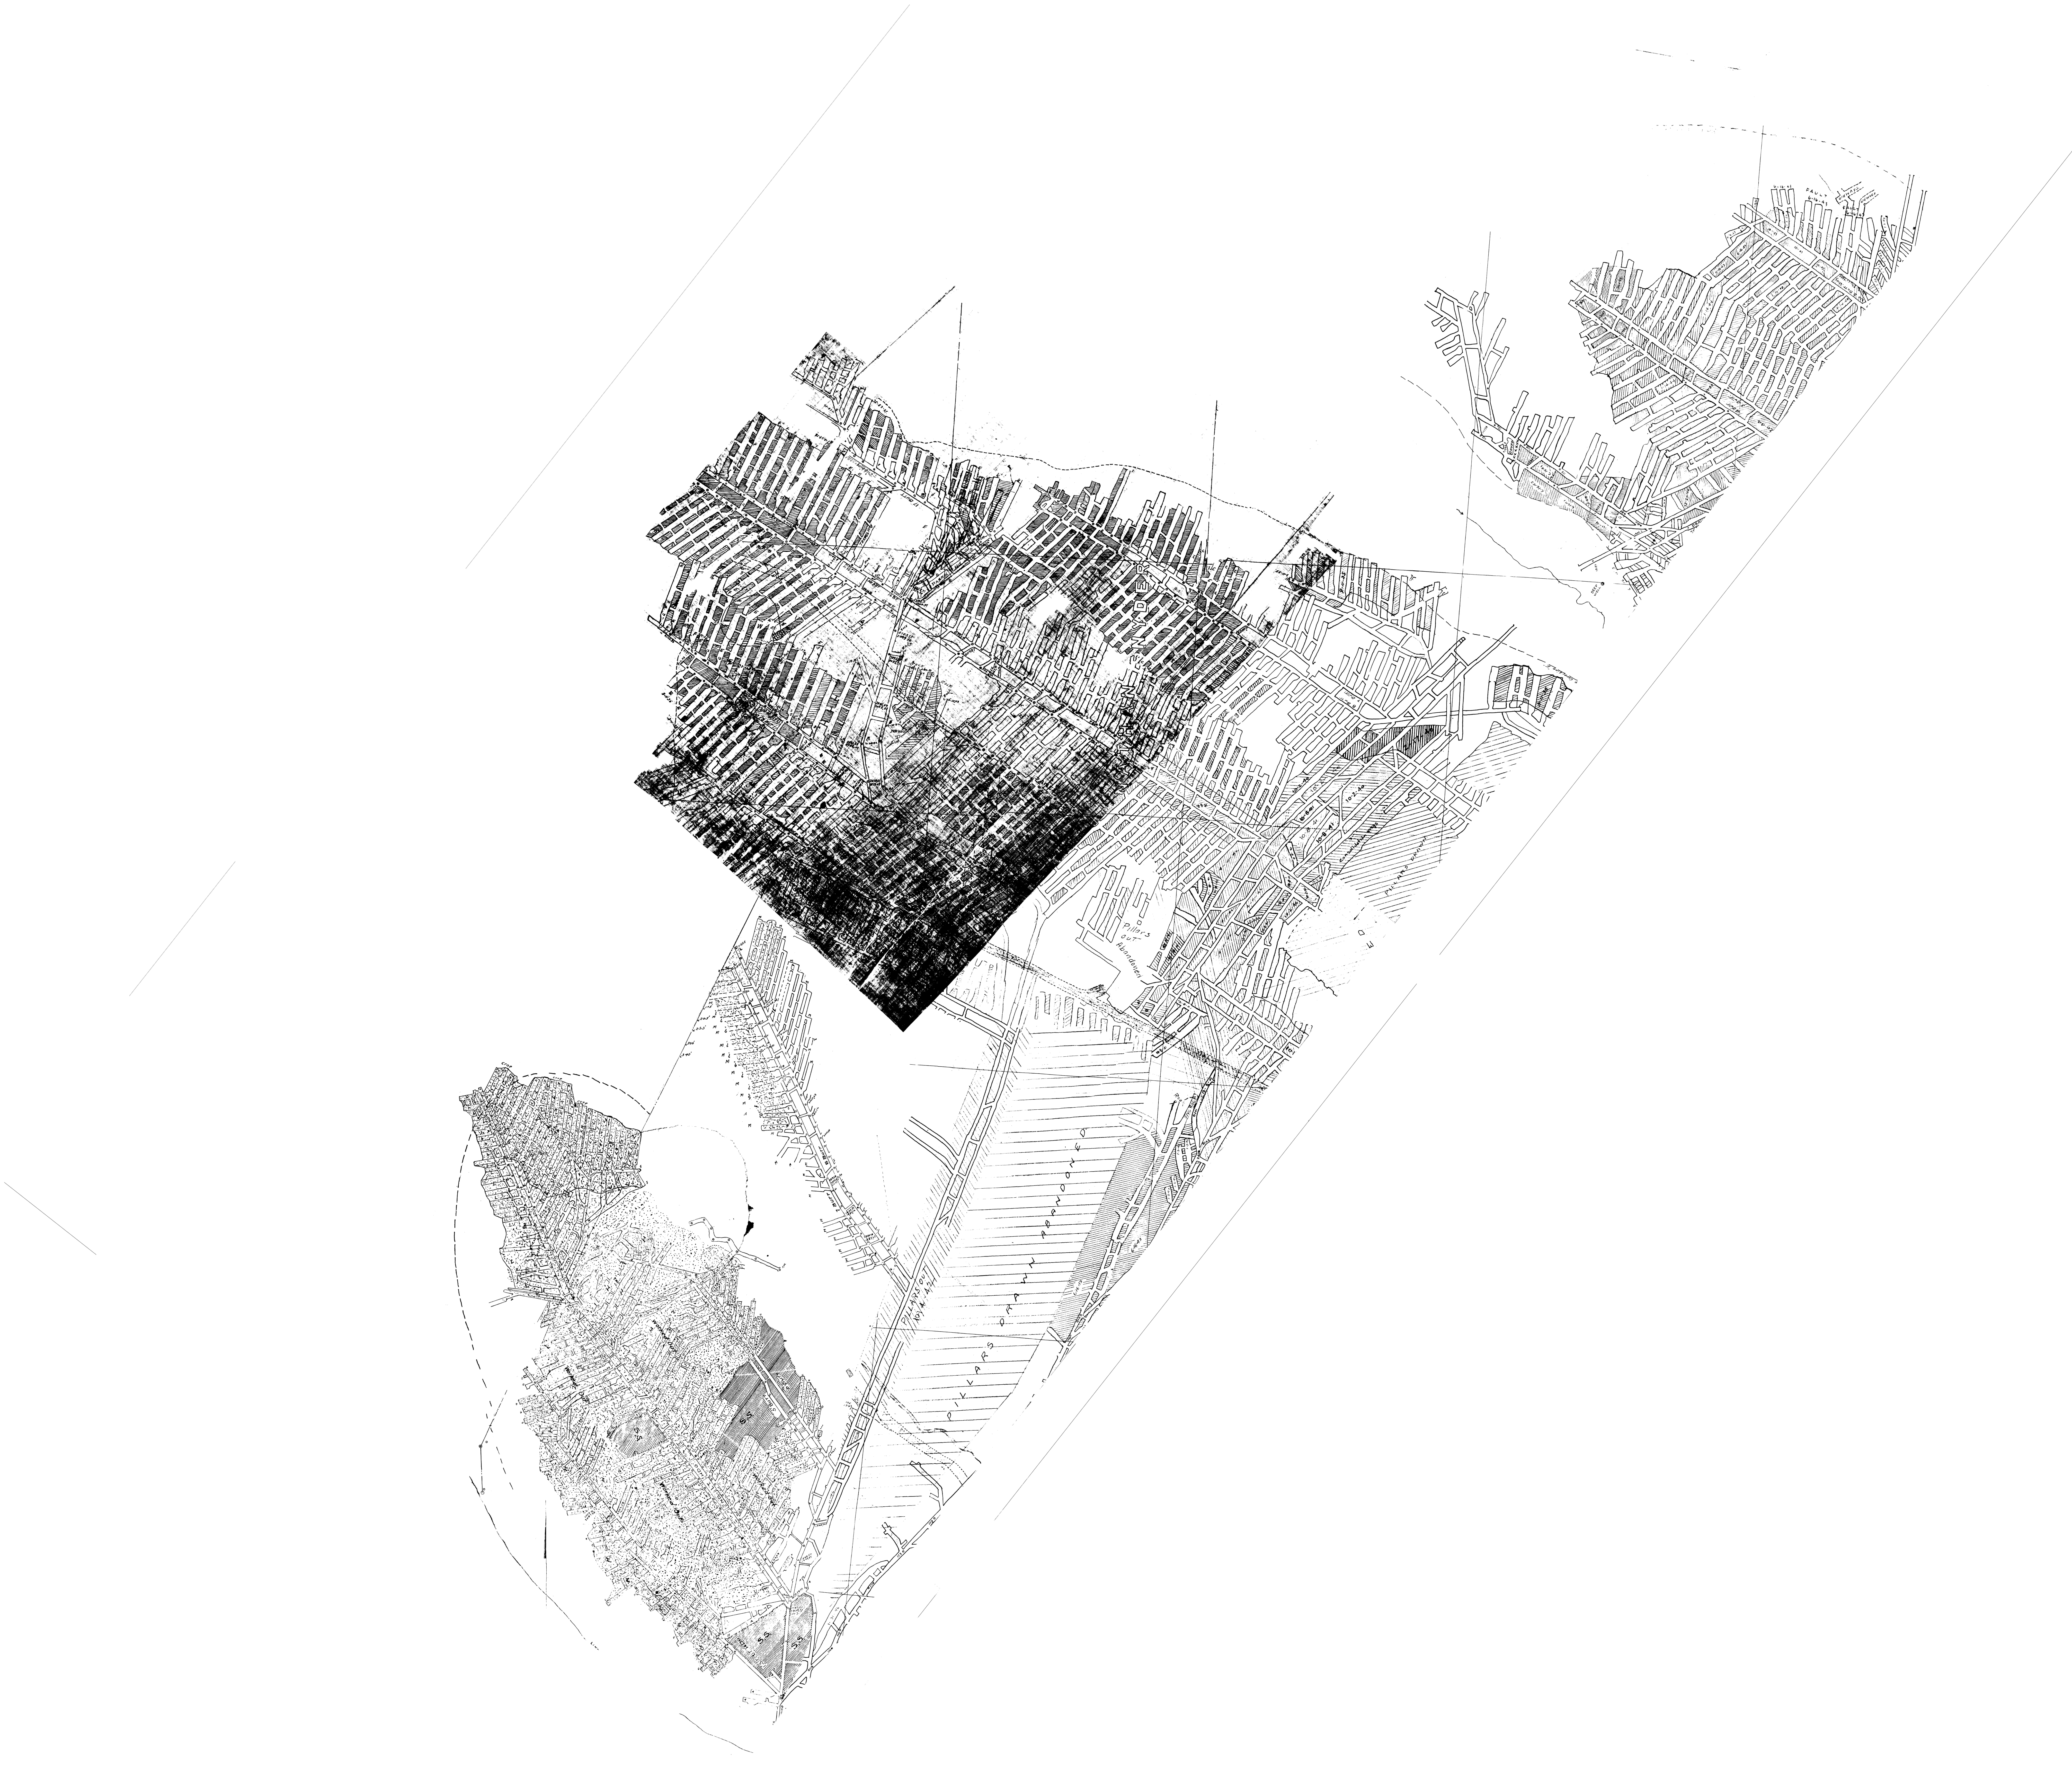
Pillars out Abandoned
DRAWN ABANDONED
Consolidation Wings
PILLARS DRAWN
10-2-40
10-8-41