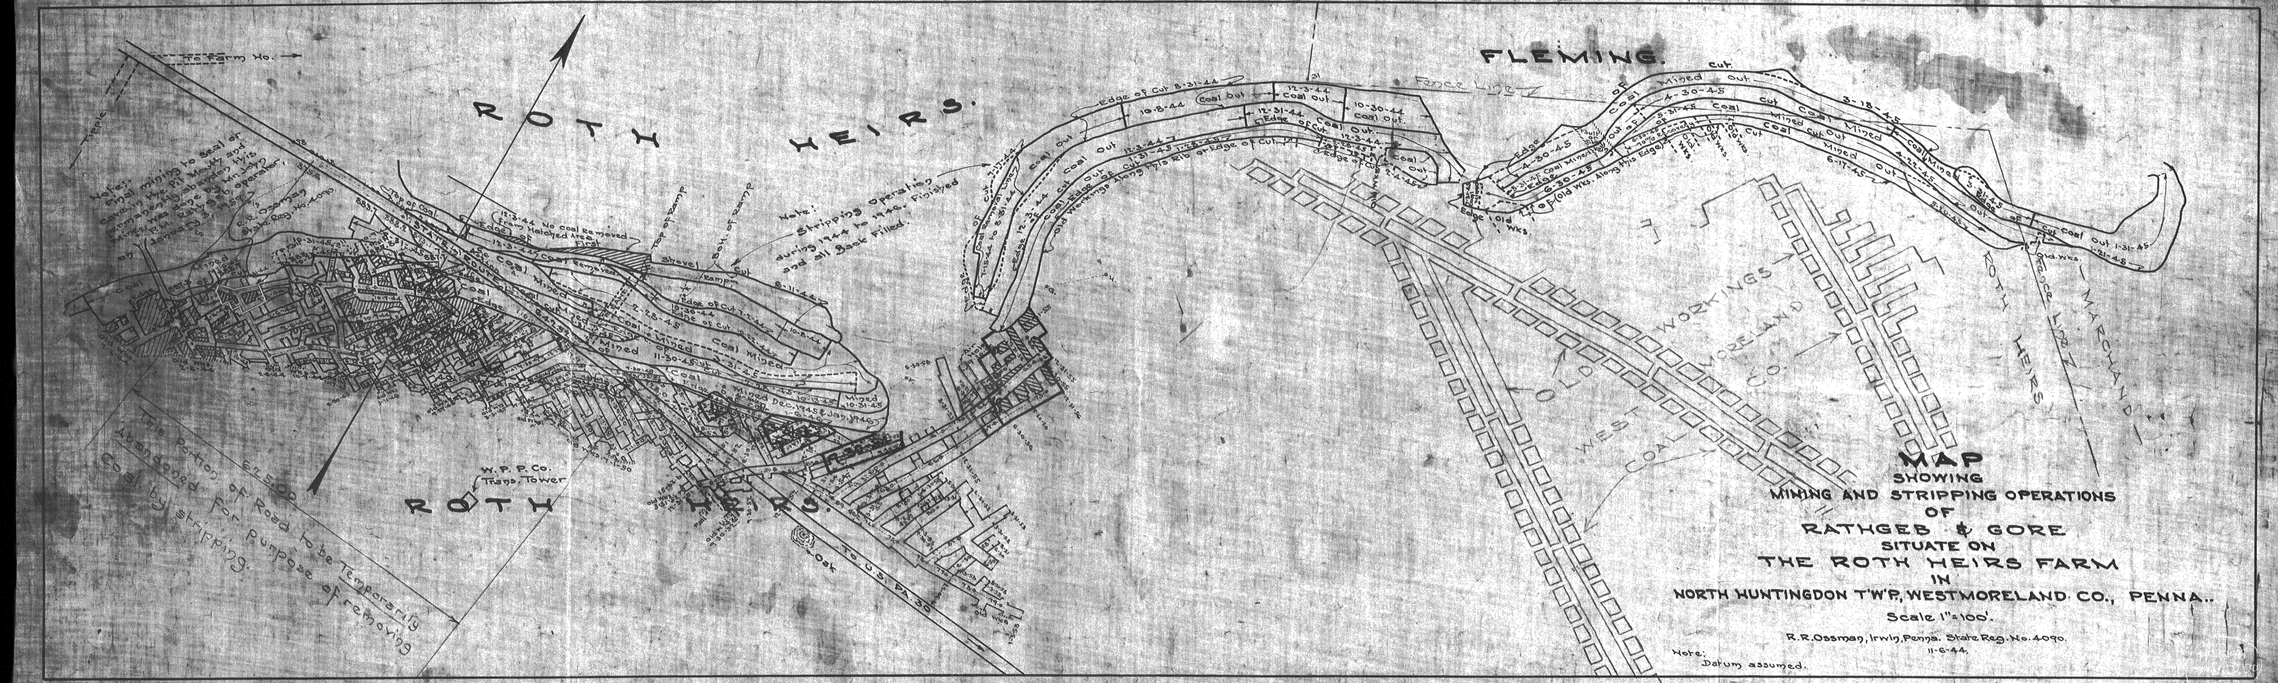
ROTH HEIRS.
ROTH HEIRS.
FLEMING.
MARCHAND
WESTMORELAND COAL CO.
ROTH HEIRS
Property Line
Fence
Top of Slope
Bank of Slope
Edge of Cut
Coal Cut
Mined Out
Shovel Ramp
W. P. P. Co. Trans. Tower
Oak
Spring
Old Wks.
Coal Wks.
Mined Coal
Coal Mined
Coal Out
Edge of Coal
Edge of Old Wks.
Edge of Cut
Top of Coal
Bank of Coal
Fence Line
Property Line
Road
Creek
Run
