


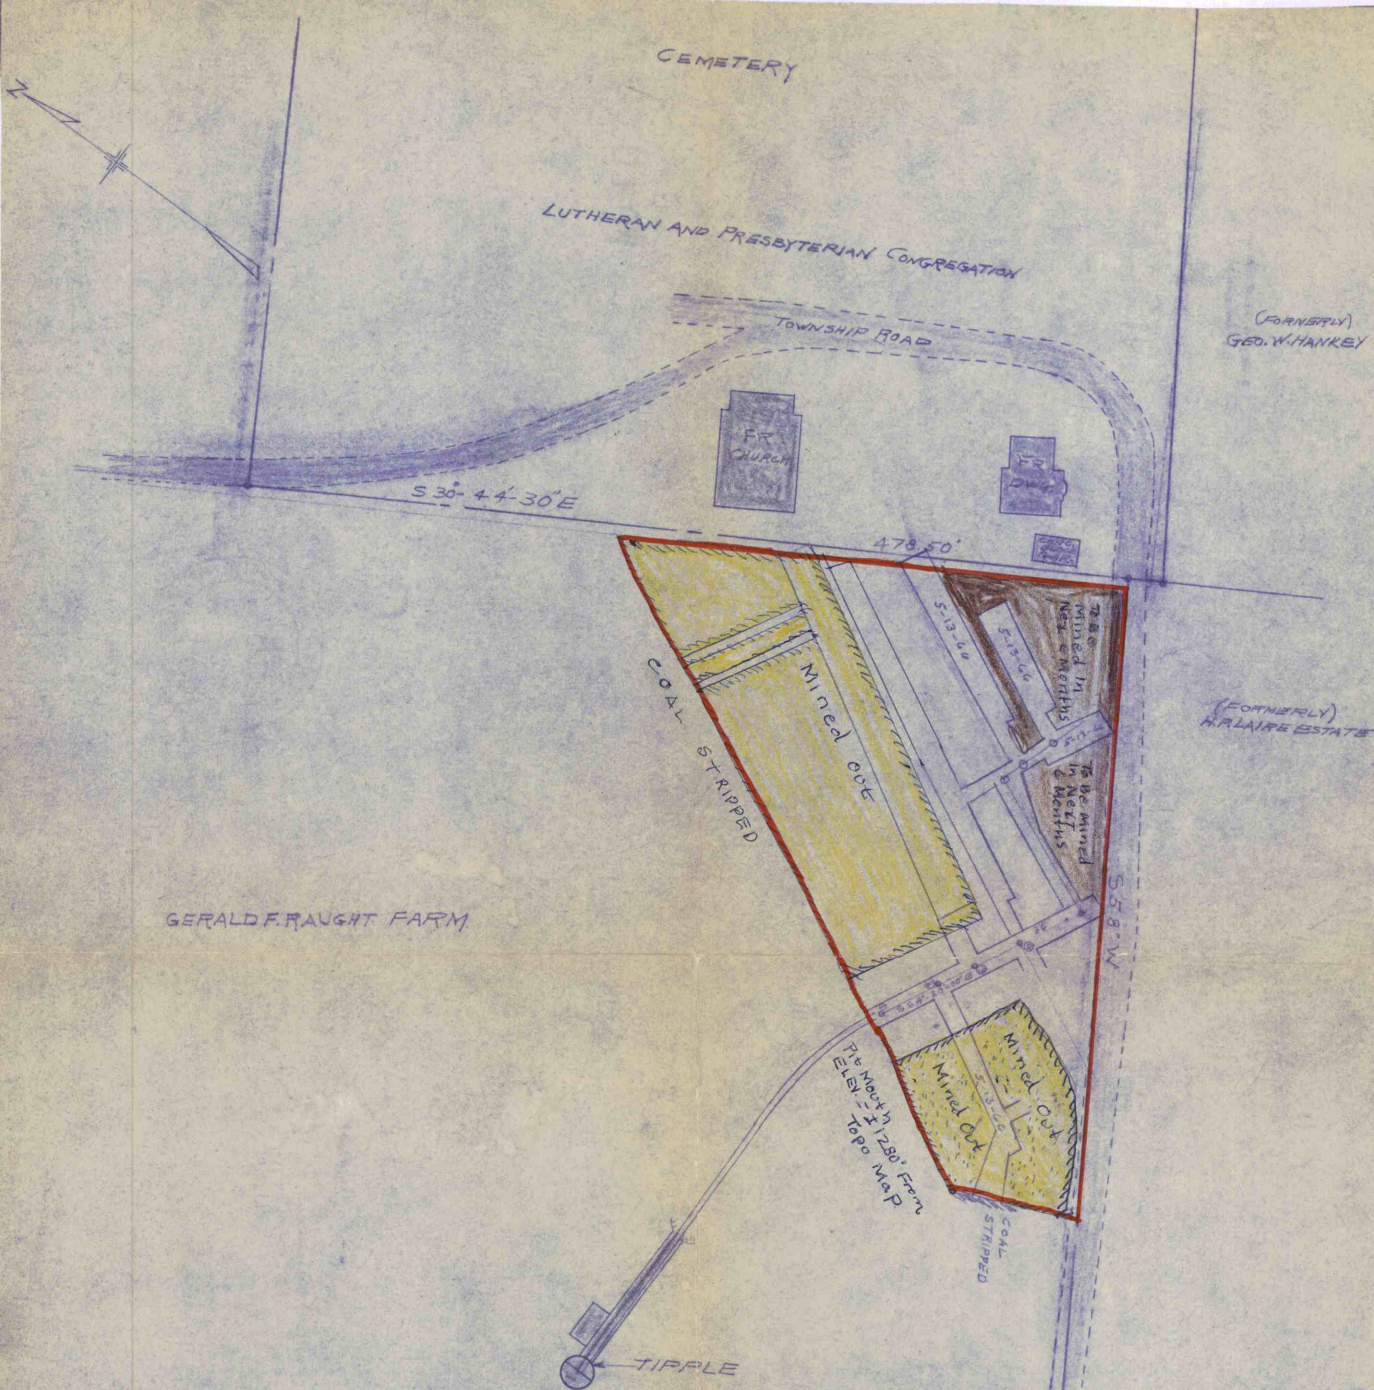

LEGEND

- EXTENT OF MINING OPERATION
- MINED OUT AREA
- TO BE MINED IN NEXT 6 MONTHS FROM July 27, 1966 TO Jan 27, 1967

PITTSBURGH SEAM

MAP SHOWING
RAUGHT MINE
SITUATED IN

FRANKLIN TWP. WESTMORELAND CO., PA.
SCALE 1" = 50' DEC. 30, 1963
Herminia D. Simone R. S. N. 483E

#2047
1-6-2000
CC

DWG. No H-57