


DATE OF SURVEY

R-2 = MAR - 7 - 1930	O-3 DEC - 17 - 1935	L-4 SEPT 27 1941
S-2 = JUN - 18 - 1930	P-3 = MAR 20 - 1936	
T-2 = SEPT - 18 - 1930	Q-3 = JUNE - 15 - 1936	
U-2 = DEC - 19 - 1930	R-3 = SEPT 19 - 1936	
V-2 = MAR - 19 - 1931	S-3 = DEC 14 - 1936	
W-2 = JUNE - 19 - 1931	T-3 = MAR 20 - 1937	
X-2 = SEPT - 19 - 1931	U-3 = JUNE - 16 - 1937	
Y-2 = DEC - 23 - 1931	V-3 = SEPT - 17 - 1937	
Z-2 = MAR 23 - 1932	W-3 = DEC - 14 - 1937	
A-3 = JUNE - 18 - 1932	X-3 = MAR - 16 - 1938	
B-3 = SEPT - 19 - 1932	Y-3 = JUNE - 16 - 1938	
C-3 = DEC - 17 - 1932	Z-3 = SEPT - 20 - 1938	
D-3 = MAR - 17 - 1933	A-4 DEC 19 - 1938	
E-3 = JUNE - 19 - 1933	B-4 MAR 21 - 1939	
F-3 = SEPT - 15 - 1933	C-4 = JUNE - 20 - 1939	
G-3 = DEC - 20 - 1933	D-4 = SEPT - 22 - 1939	
H-3 = MAR - 16 - 1934	E-4 = DEC - 29 - 1939	
I-3 = JUNE - 19 - 1934	F-4 = MAR - 25 - 1940	
J-3 = SEPT - 14 - 1934	G-4 JUNE - 25 - 1940	
K-3 = DEC - 18 - 1934	H-4 OCT 15, 1940	
L-3 = MAR - 20 - 1935	I-4 = JAN 4, 1941	
M-3 = JUNE - 19 - 1935	J-4 = MAY 1 1941	
N-3 = SEPT - 23 - 1935	K-4 = JULY 21 1941	

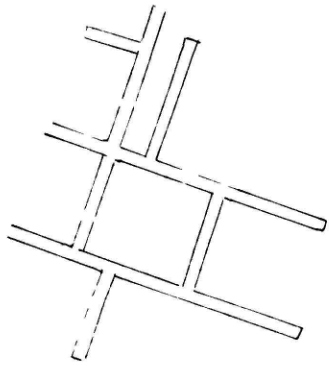

K
G
I
R
F

G

H

COKE

