



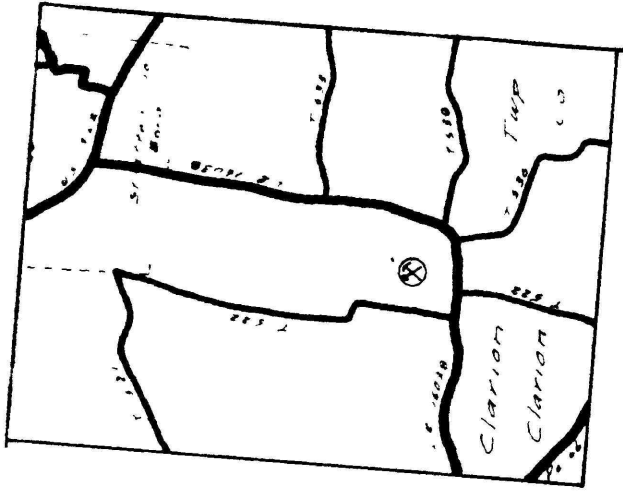

LOCATION MAP
SCALE 1" = 3000'

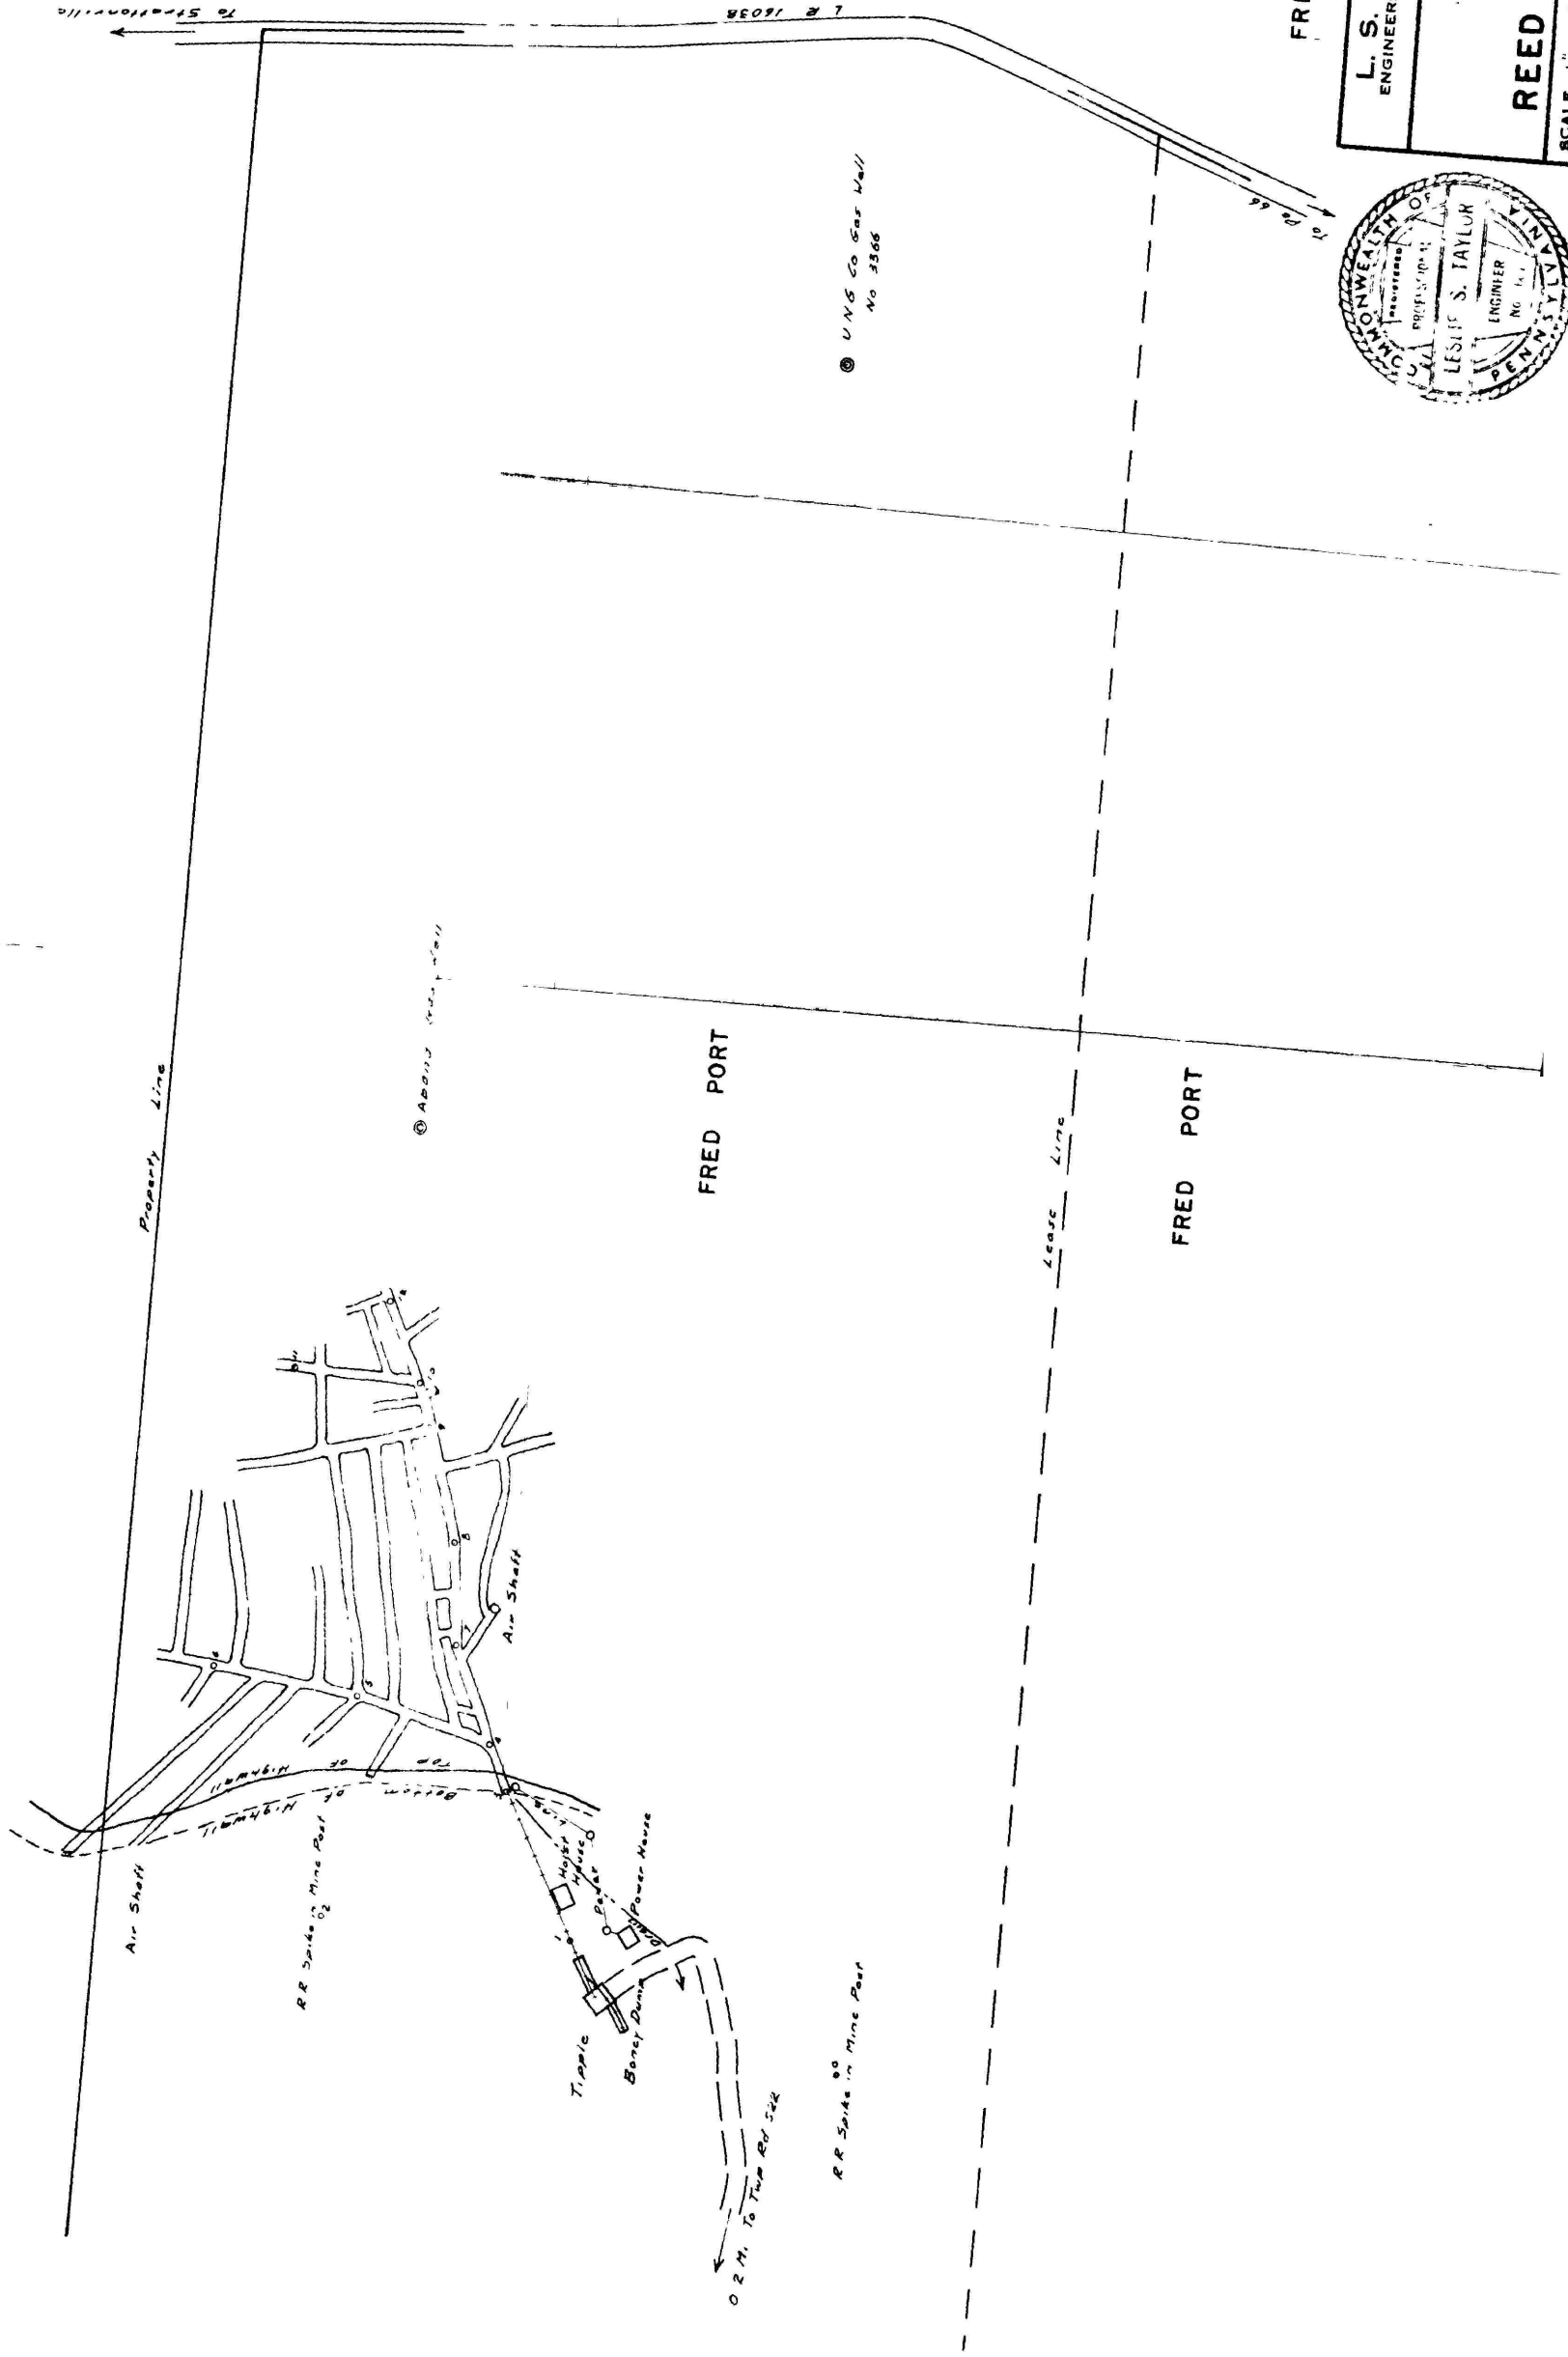

FRED PORT & L. L. THEISS
PROPERTIES

L. S. TAYLOR ENGINEERING
ENGINEERS
SURVEYORS
CLARION PA TOPOGRAPHERS

MINE MAP
FOR
REED & FOUST COAL CO.

SCALE 1" = 100' FILE NO. 310
DATE OCTOBER, 1957 SHEET NO. 1/1

Dist. &
Clarion Co.

