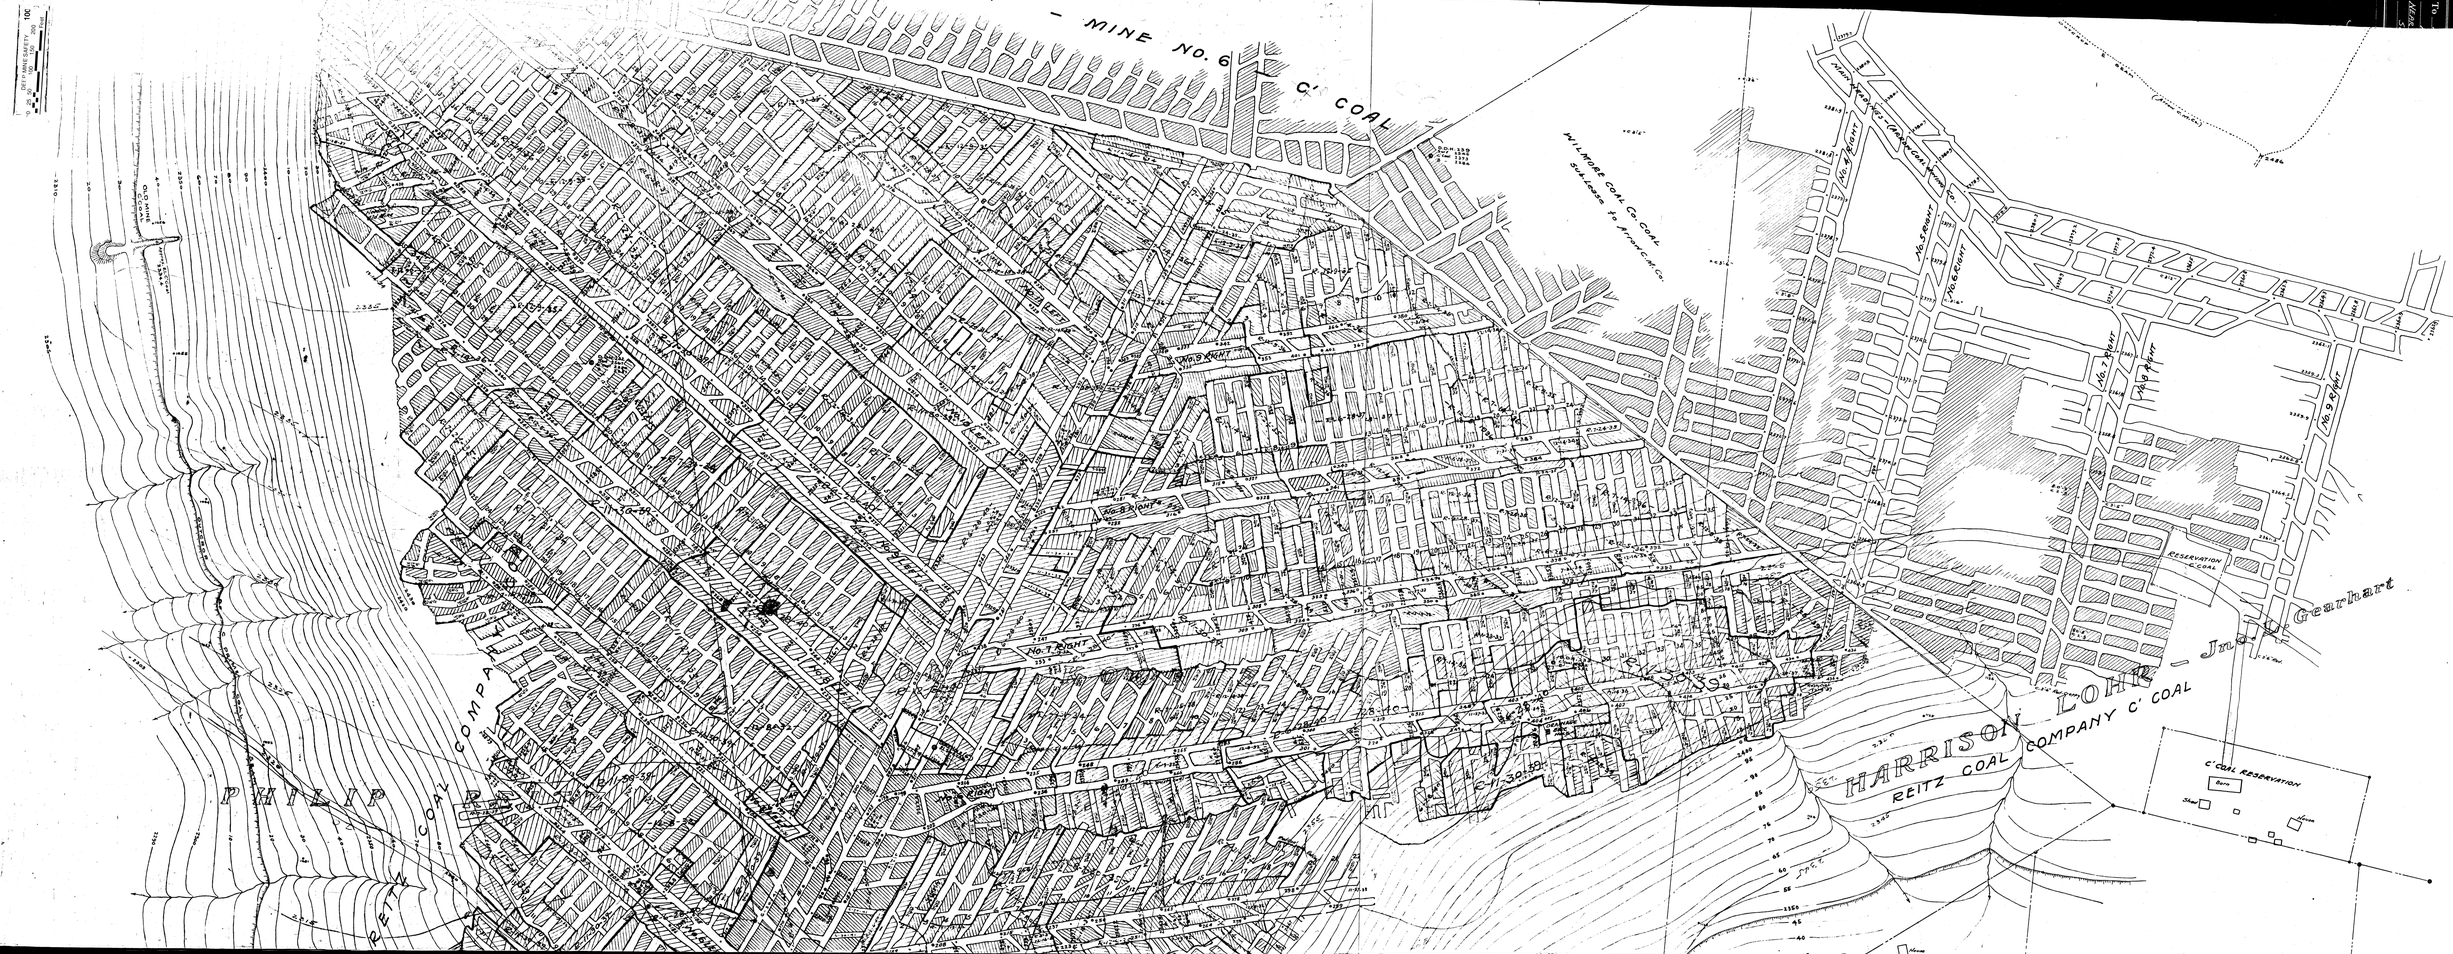

DEEP MINE SAFETY
0 25 50 100 150 200 Feet
100
2290
2300
2305
2310
2350
2400
2420
2430
2335
C PRIME COAL SEAM
OUTCROP
OLD MINE
C'COAL
Approx. El. C'Coal 2334.4
REITZ COAL COMPANY
ANY – MINE NO. 6
C' COAL
No. 8 LEFT
No. 9 LEFT
No. 10 LEFT
No. 11 LEFT
No. 7 RIGHT
No. 8 RIGHT
No. 9 RIGHT
DRAINAGE
WILMORE COAL Co. COAL
Sub-Lease to Arrow C.M. Co.
D.D.H. 2239
HARRISON LOHR – Jno. D. Gearhart
REITZ COAL COMPANY C' COAL
C' COAL RESERVATION
Shed
Barn
House
RESERVATION
C' COAL
No. 4 RIGHT
No. 5 RIGHT
No. 6 RIGHT
No. 7 RIGHT
No. 8 RIGHT
No. 9 RIGHT
MAIN HEADINGS – (ARROW COAL MINING CO.)
OUTCROP E SEAM
(Arrow C.M. Co.)
2486
2380.3
2374.9
2379.2
2370.3
2377.4
2372.4
2363.5
2360.8
2363.3
2364.3
2362.8
2360.9
2362.9
2381.8
2381.9
2379.7
2380.1
2380.7
2380.8
2379.9
2379.5
To
NEAR
CO
DMAD-2