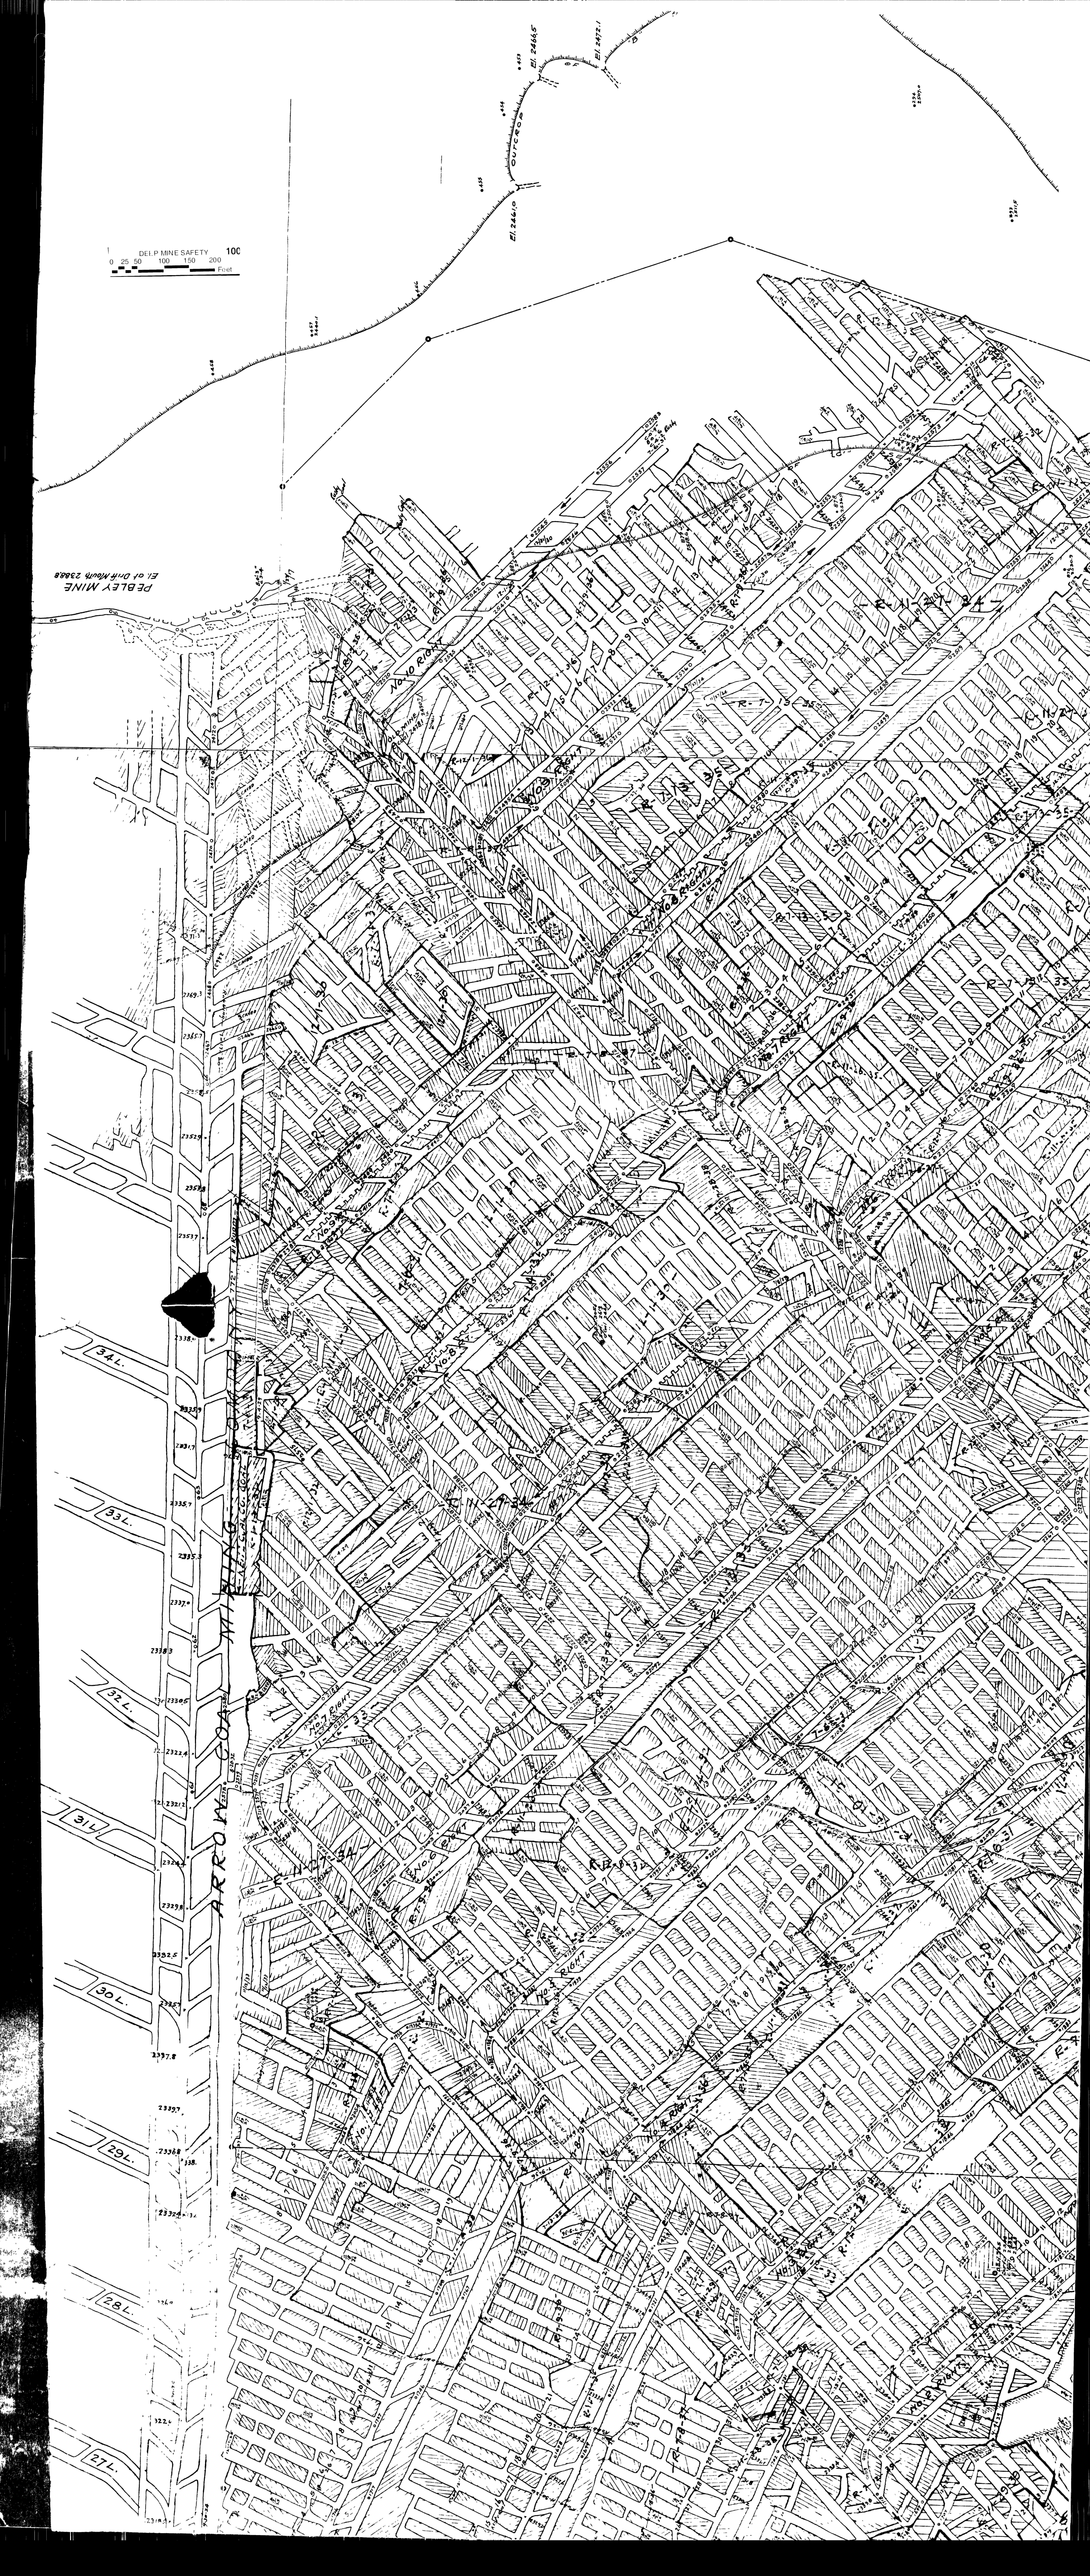
DELP MINE SAFETY
0 25 50 100 150 200
Feet
100
PEBLEY MINE
El. at Drift Mouth 2368
ARROW COAL MINING
34L.
33L.
32L.
31L.
30L.
29L.
28L.
27L.