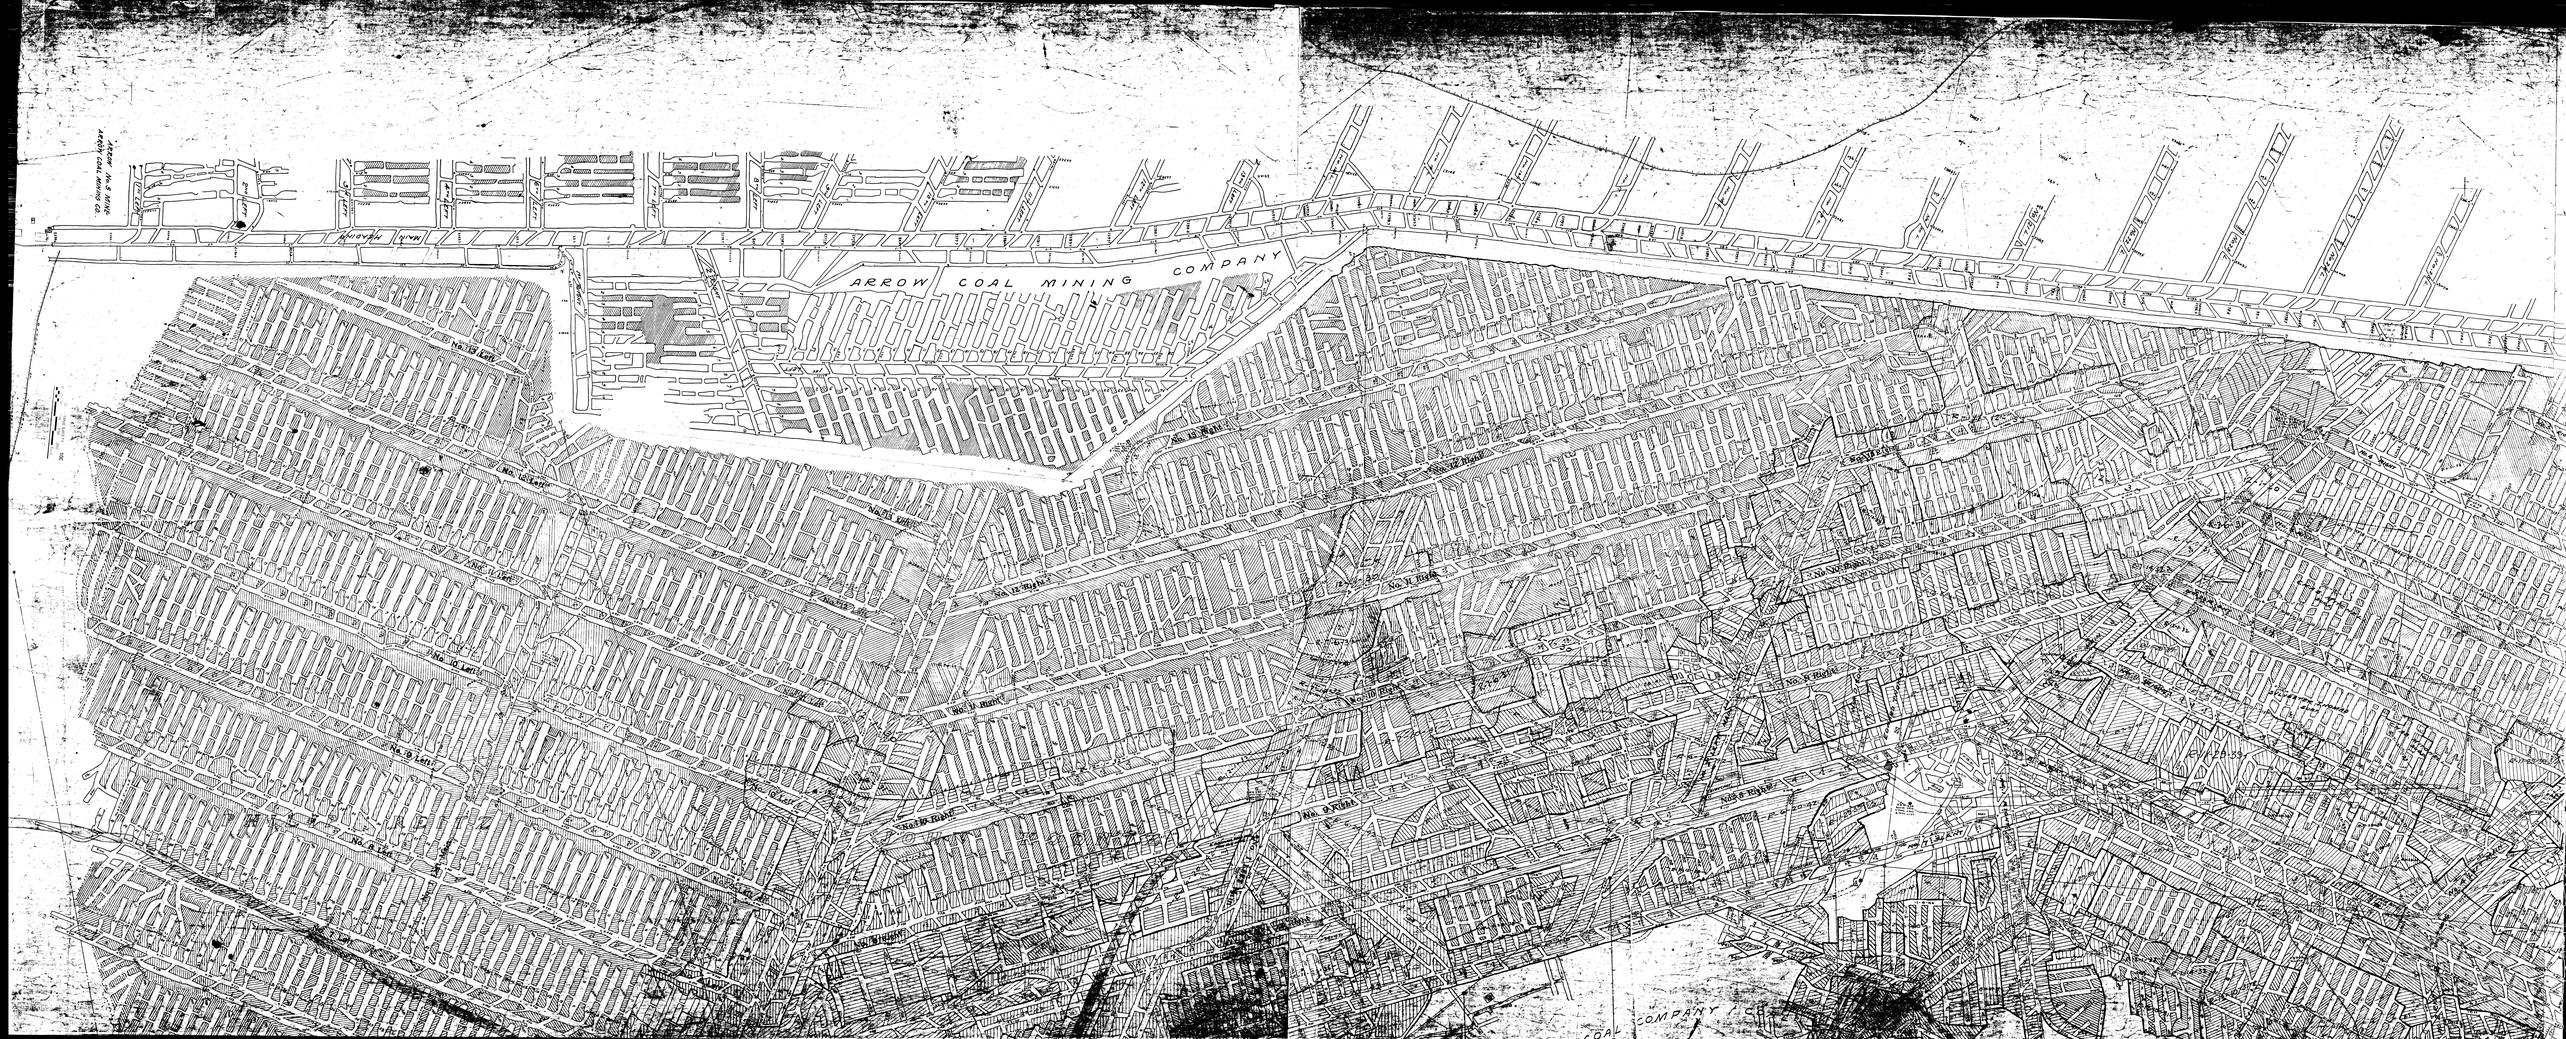
ARROW COAL MINING COMPANY
No. 15 Left
No. 14 Left
No. 13 Left
No. 12 Left
No. 11 Left
No. 10 Left
No. 9 Left
No. 8 Left
No. 7 Left
No. 6 Left
No. 5 Left
No. 4 Left
No. 3 Left
No. 2 Left
No. 1 Left
No. 15 Right
No. 14 Right
No. 13 Right
No. 12 Right
No. 11 Right
No. 10 Right
No. 9 Right
No. 8 Right
No. 7 Right
No. 6 Right
No. 5 Right
No. 4 Right
No. 3 Right
No. 2 Right
No. 1 Right
COAL COMPANY