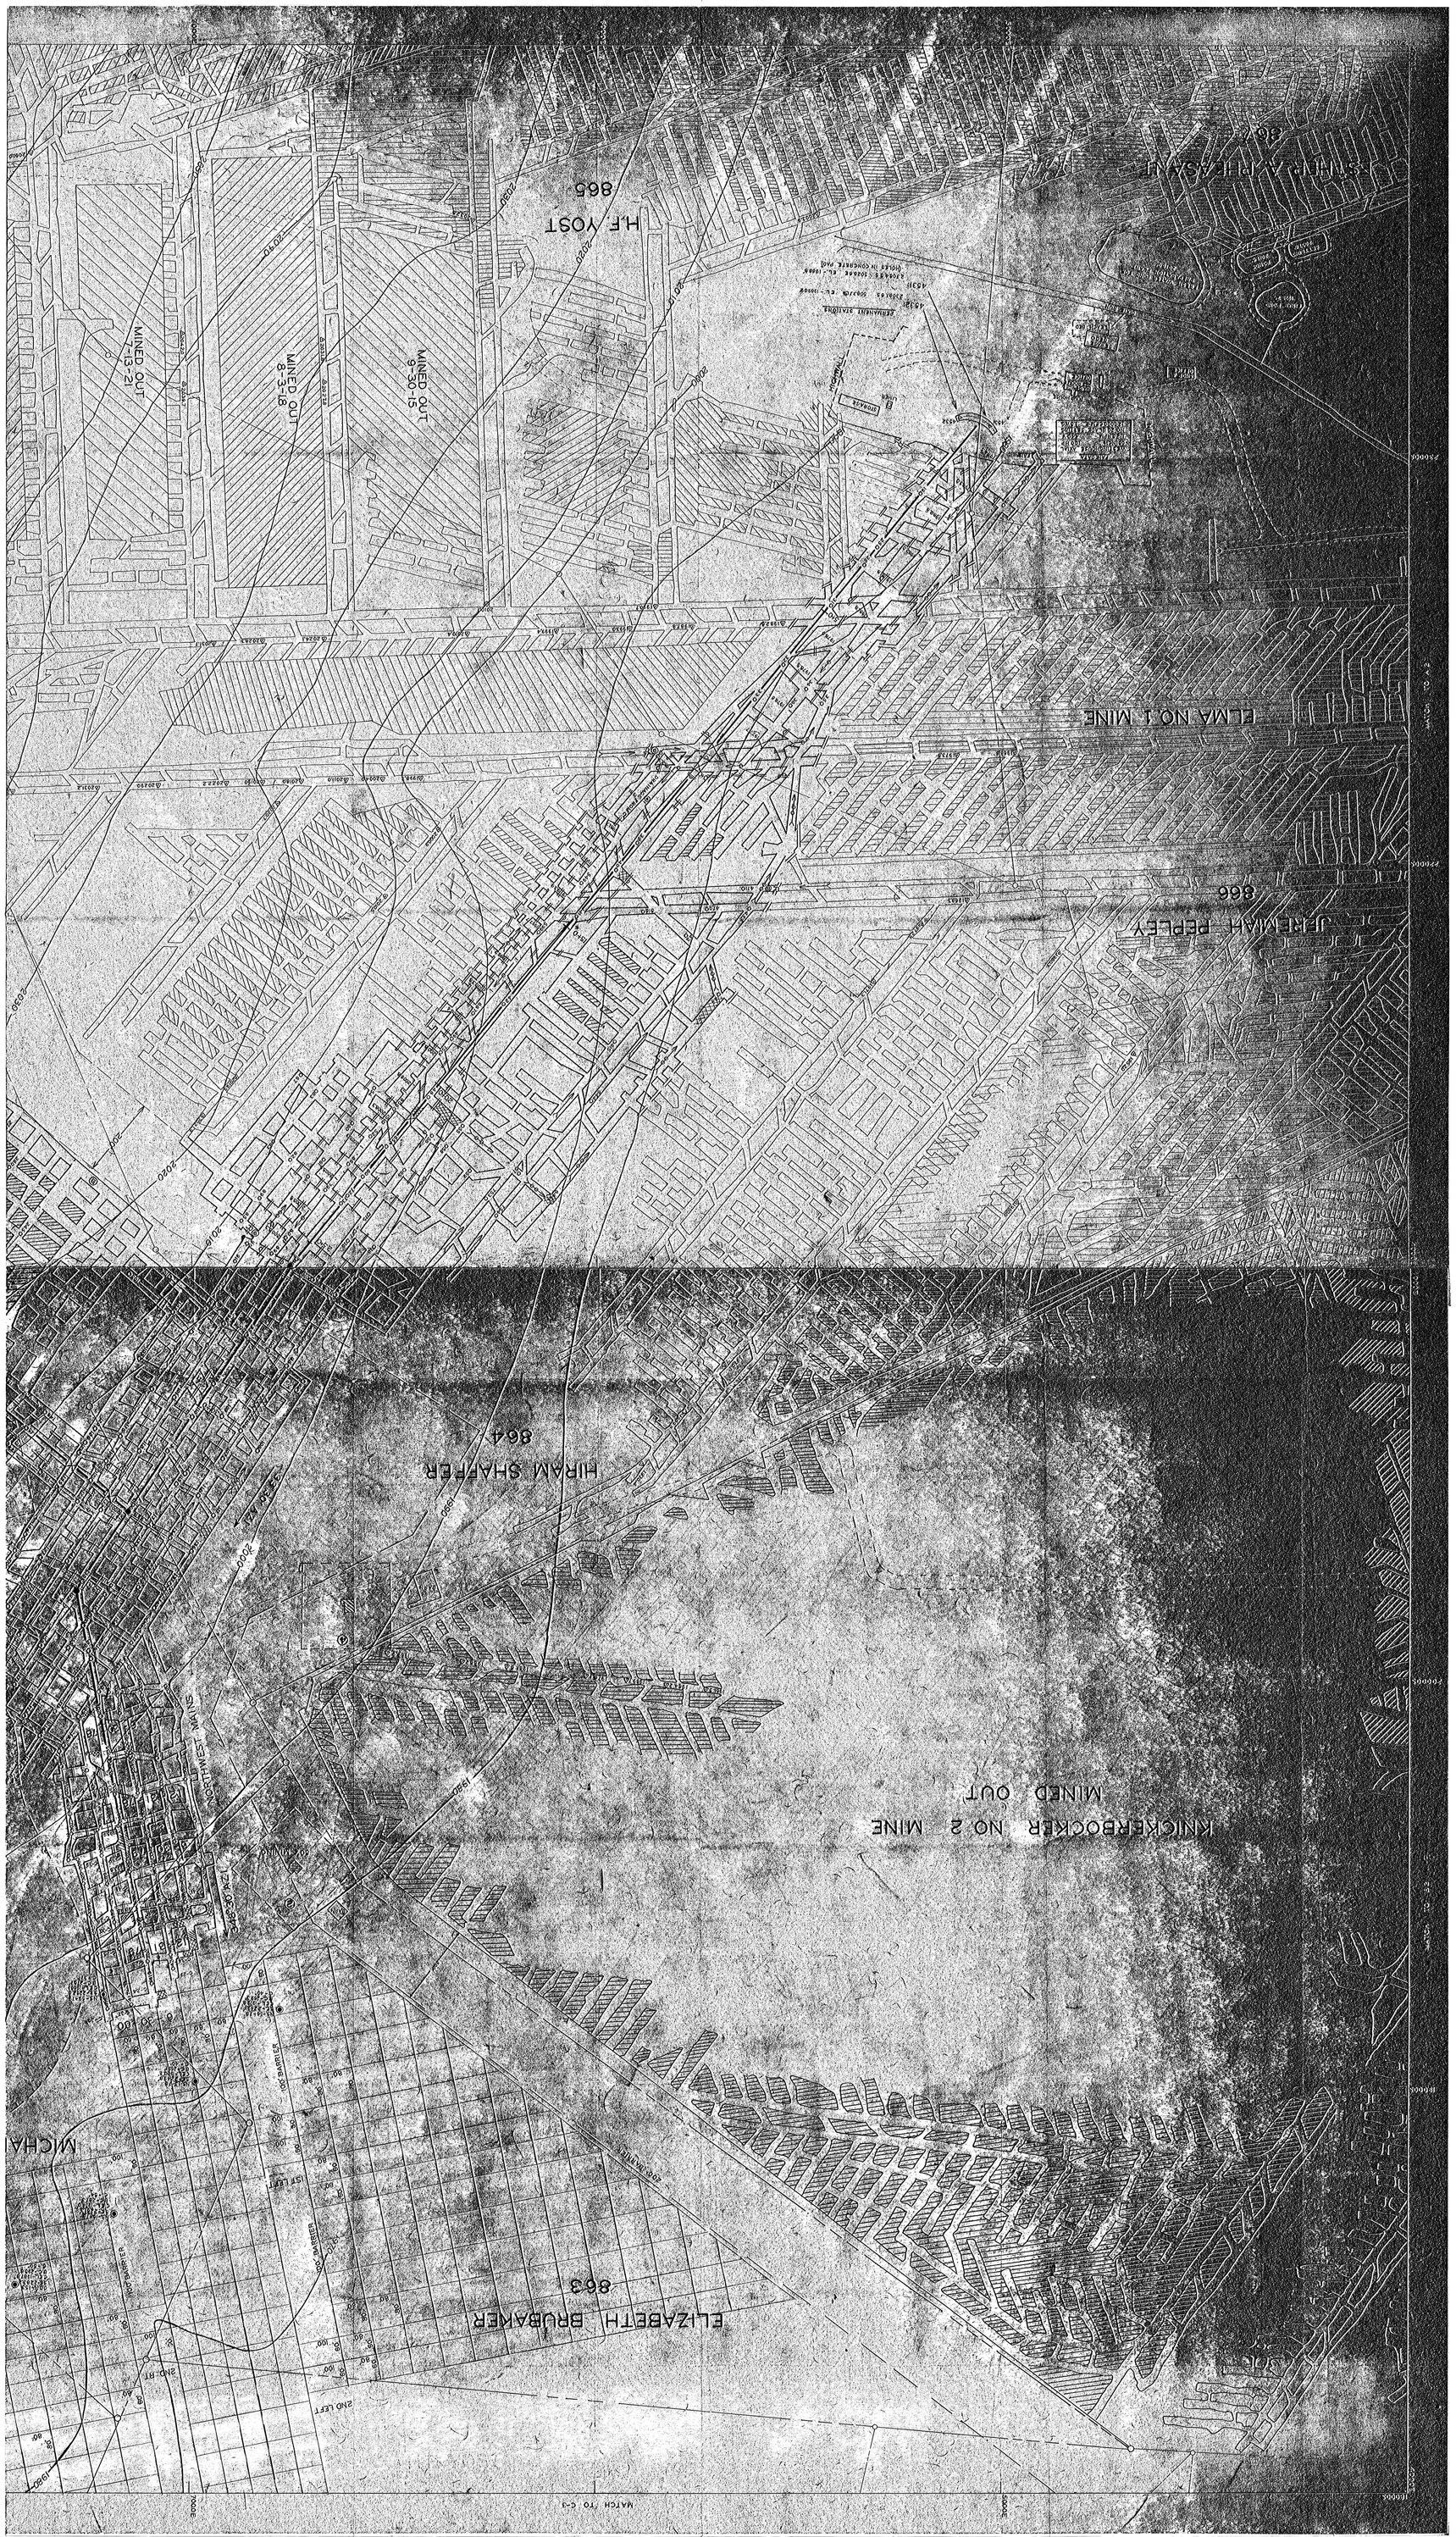
H.F VOST
865
MINED OUT
9-30-15
MINED OUT
8-31-18
MINED OUT
7-13-21
ELMA NO 1 MINE
JEREMIAH PEPLEY
866
HIRAM SHAFFER
864
KNICKERBOCKER NO 2 MINE
MINED OUT
ELIZABETH BRUBAKER
863
MATCH TO C-4