


NE JOHNSON


932

PERMANENT STATIONS
 3196 - S. 765.18 W. 20,555.89
 3197 - S. 762.21 W. 20,554.76

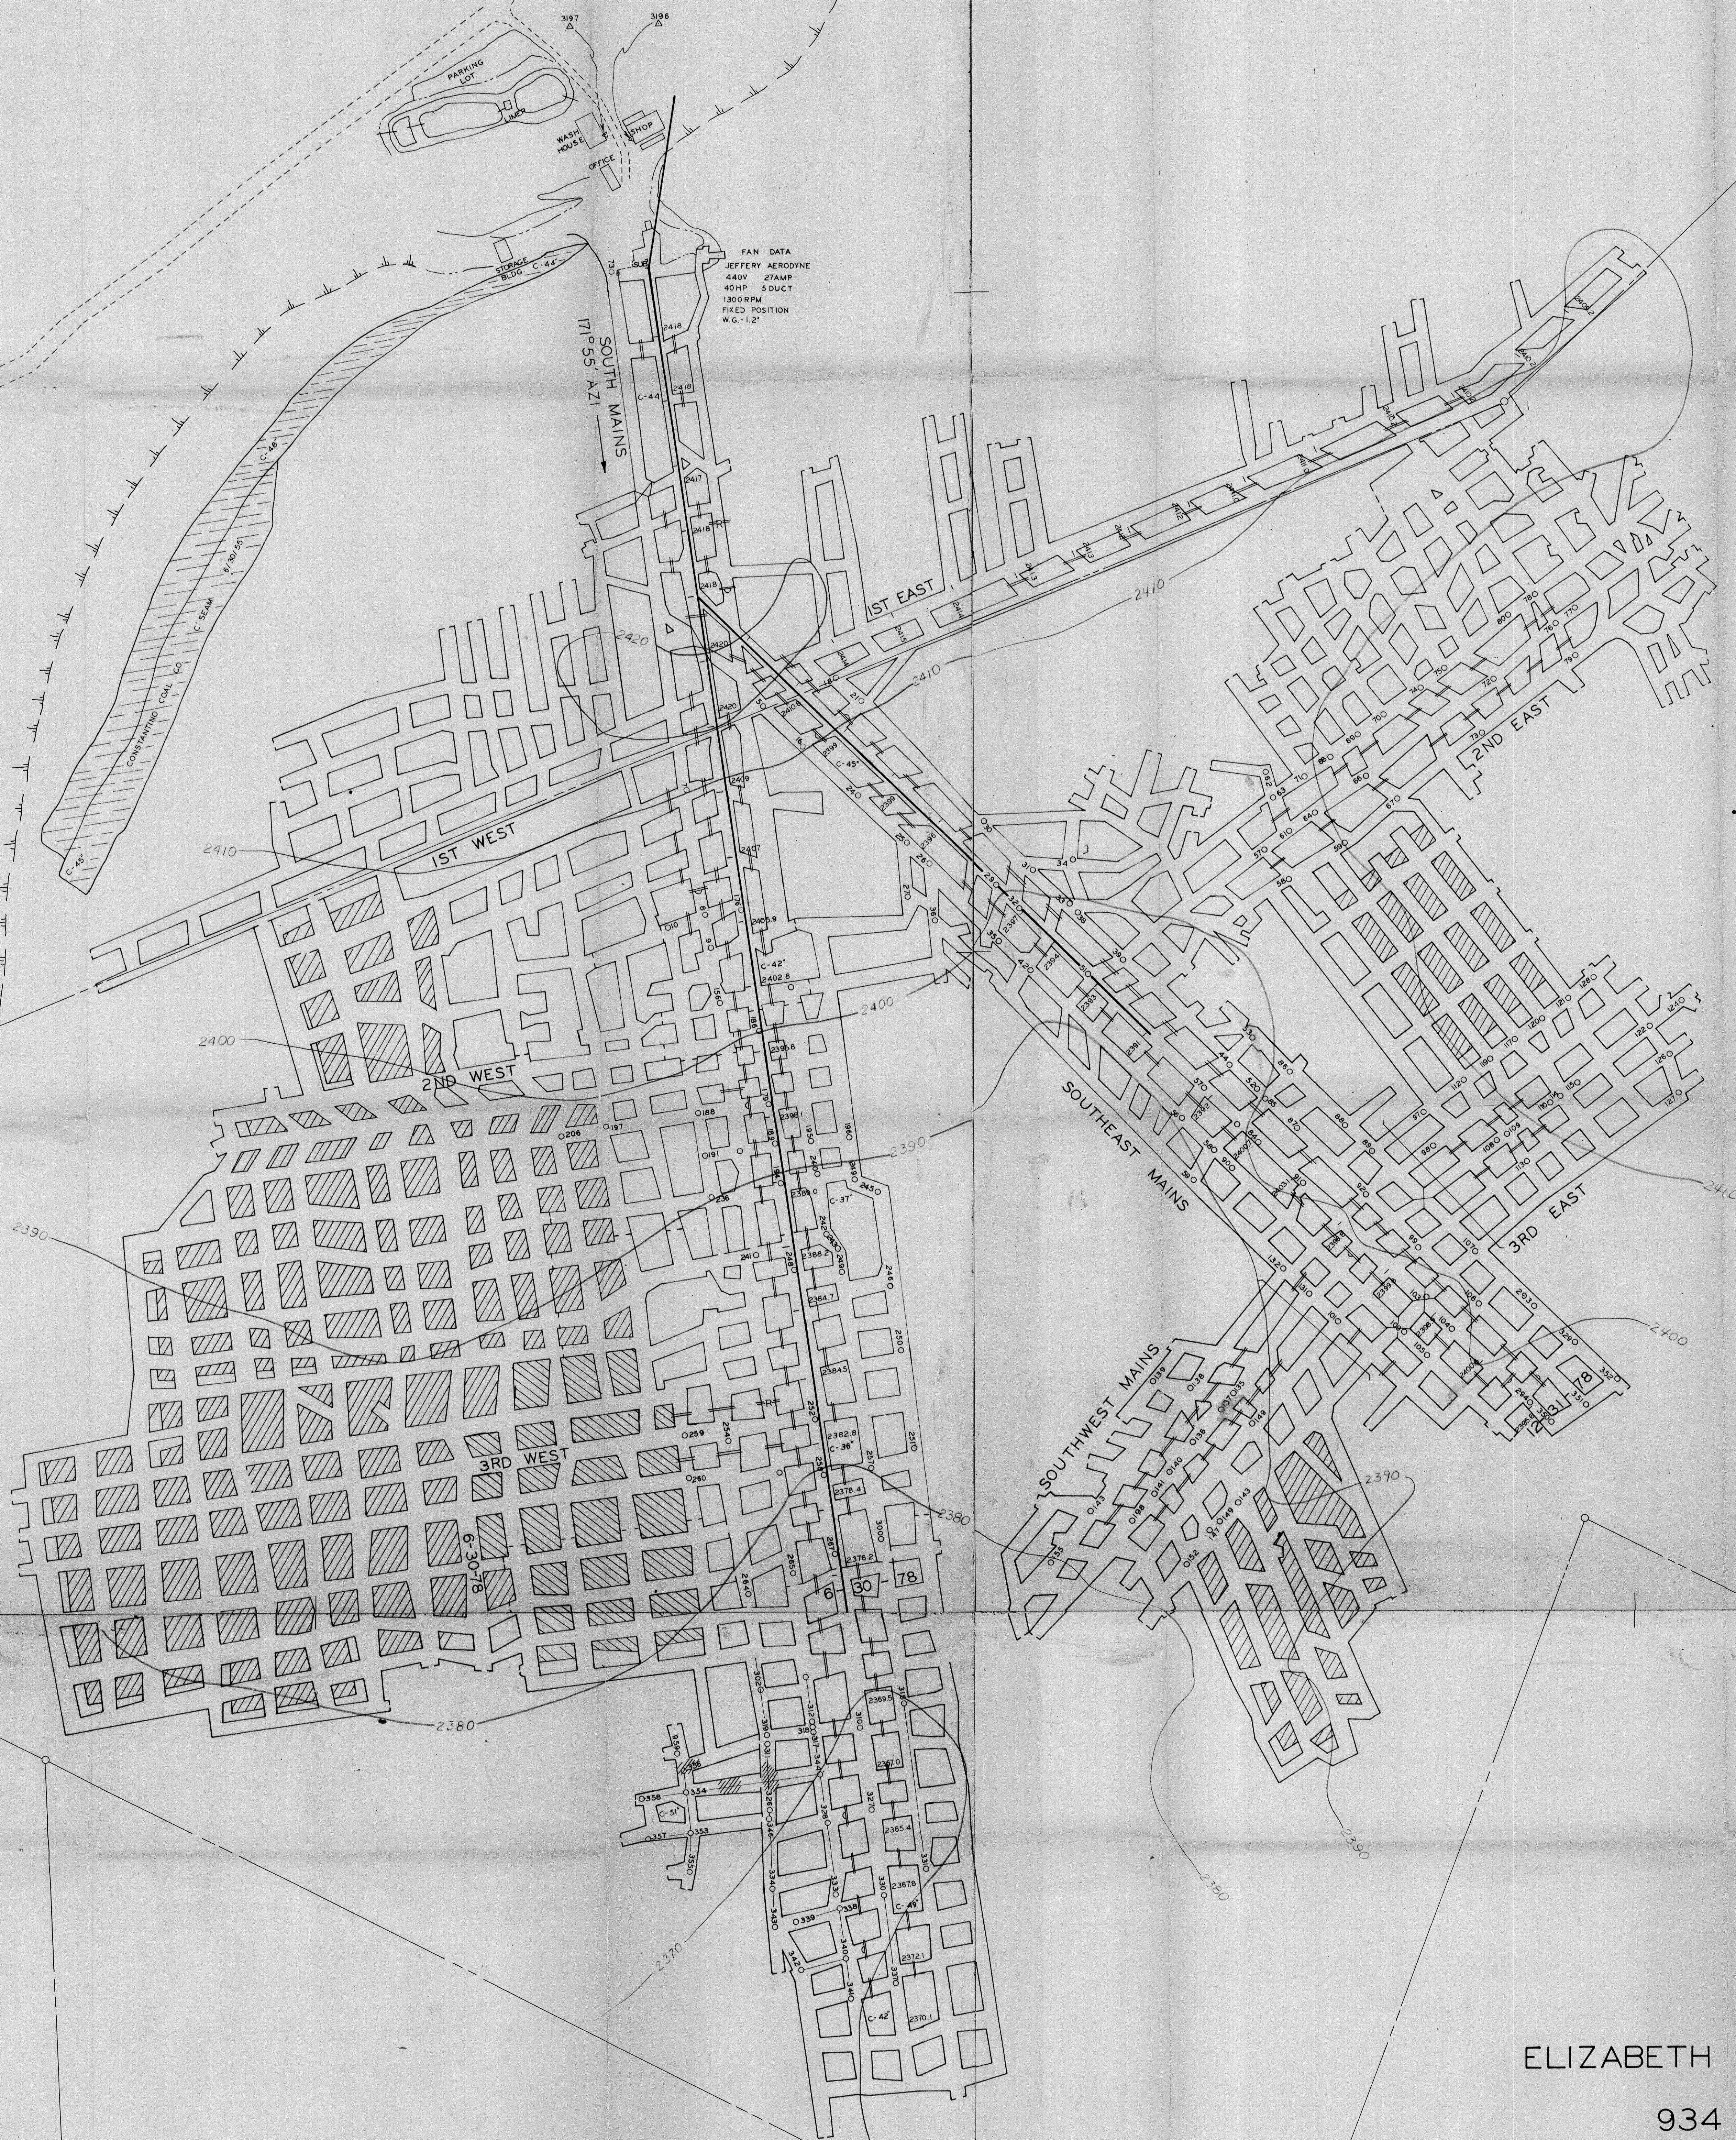

ELIZABETH LAPE

934

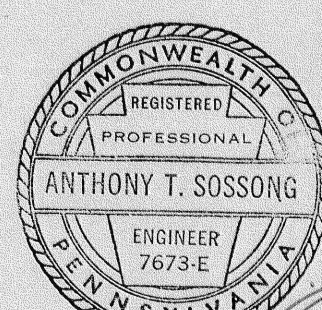

REITZ COAL COMPANY
 REITZ NO. 23
 J.T. MINE

UPPER KITTANNING SEAM
 SHADE TWP. SOMERSET CO.
 SCALE: 1" = 100' SURVEY DATE: 6-26-79

SF. 11
 SEL. 7834.2
 CEL. 2369.8
 BC. 284.4
 C. 45