


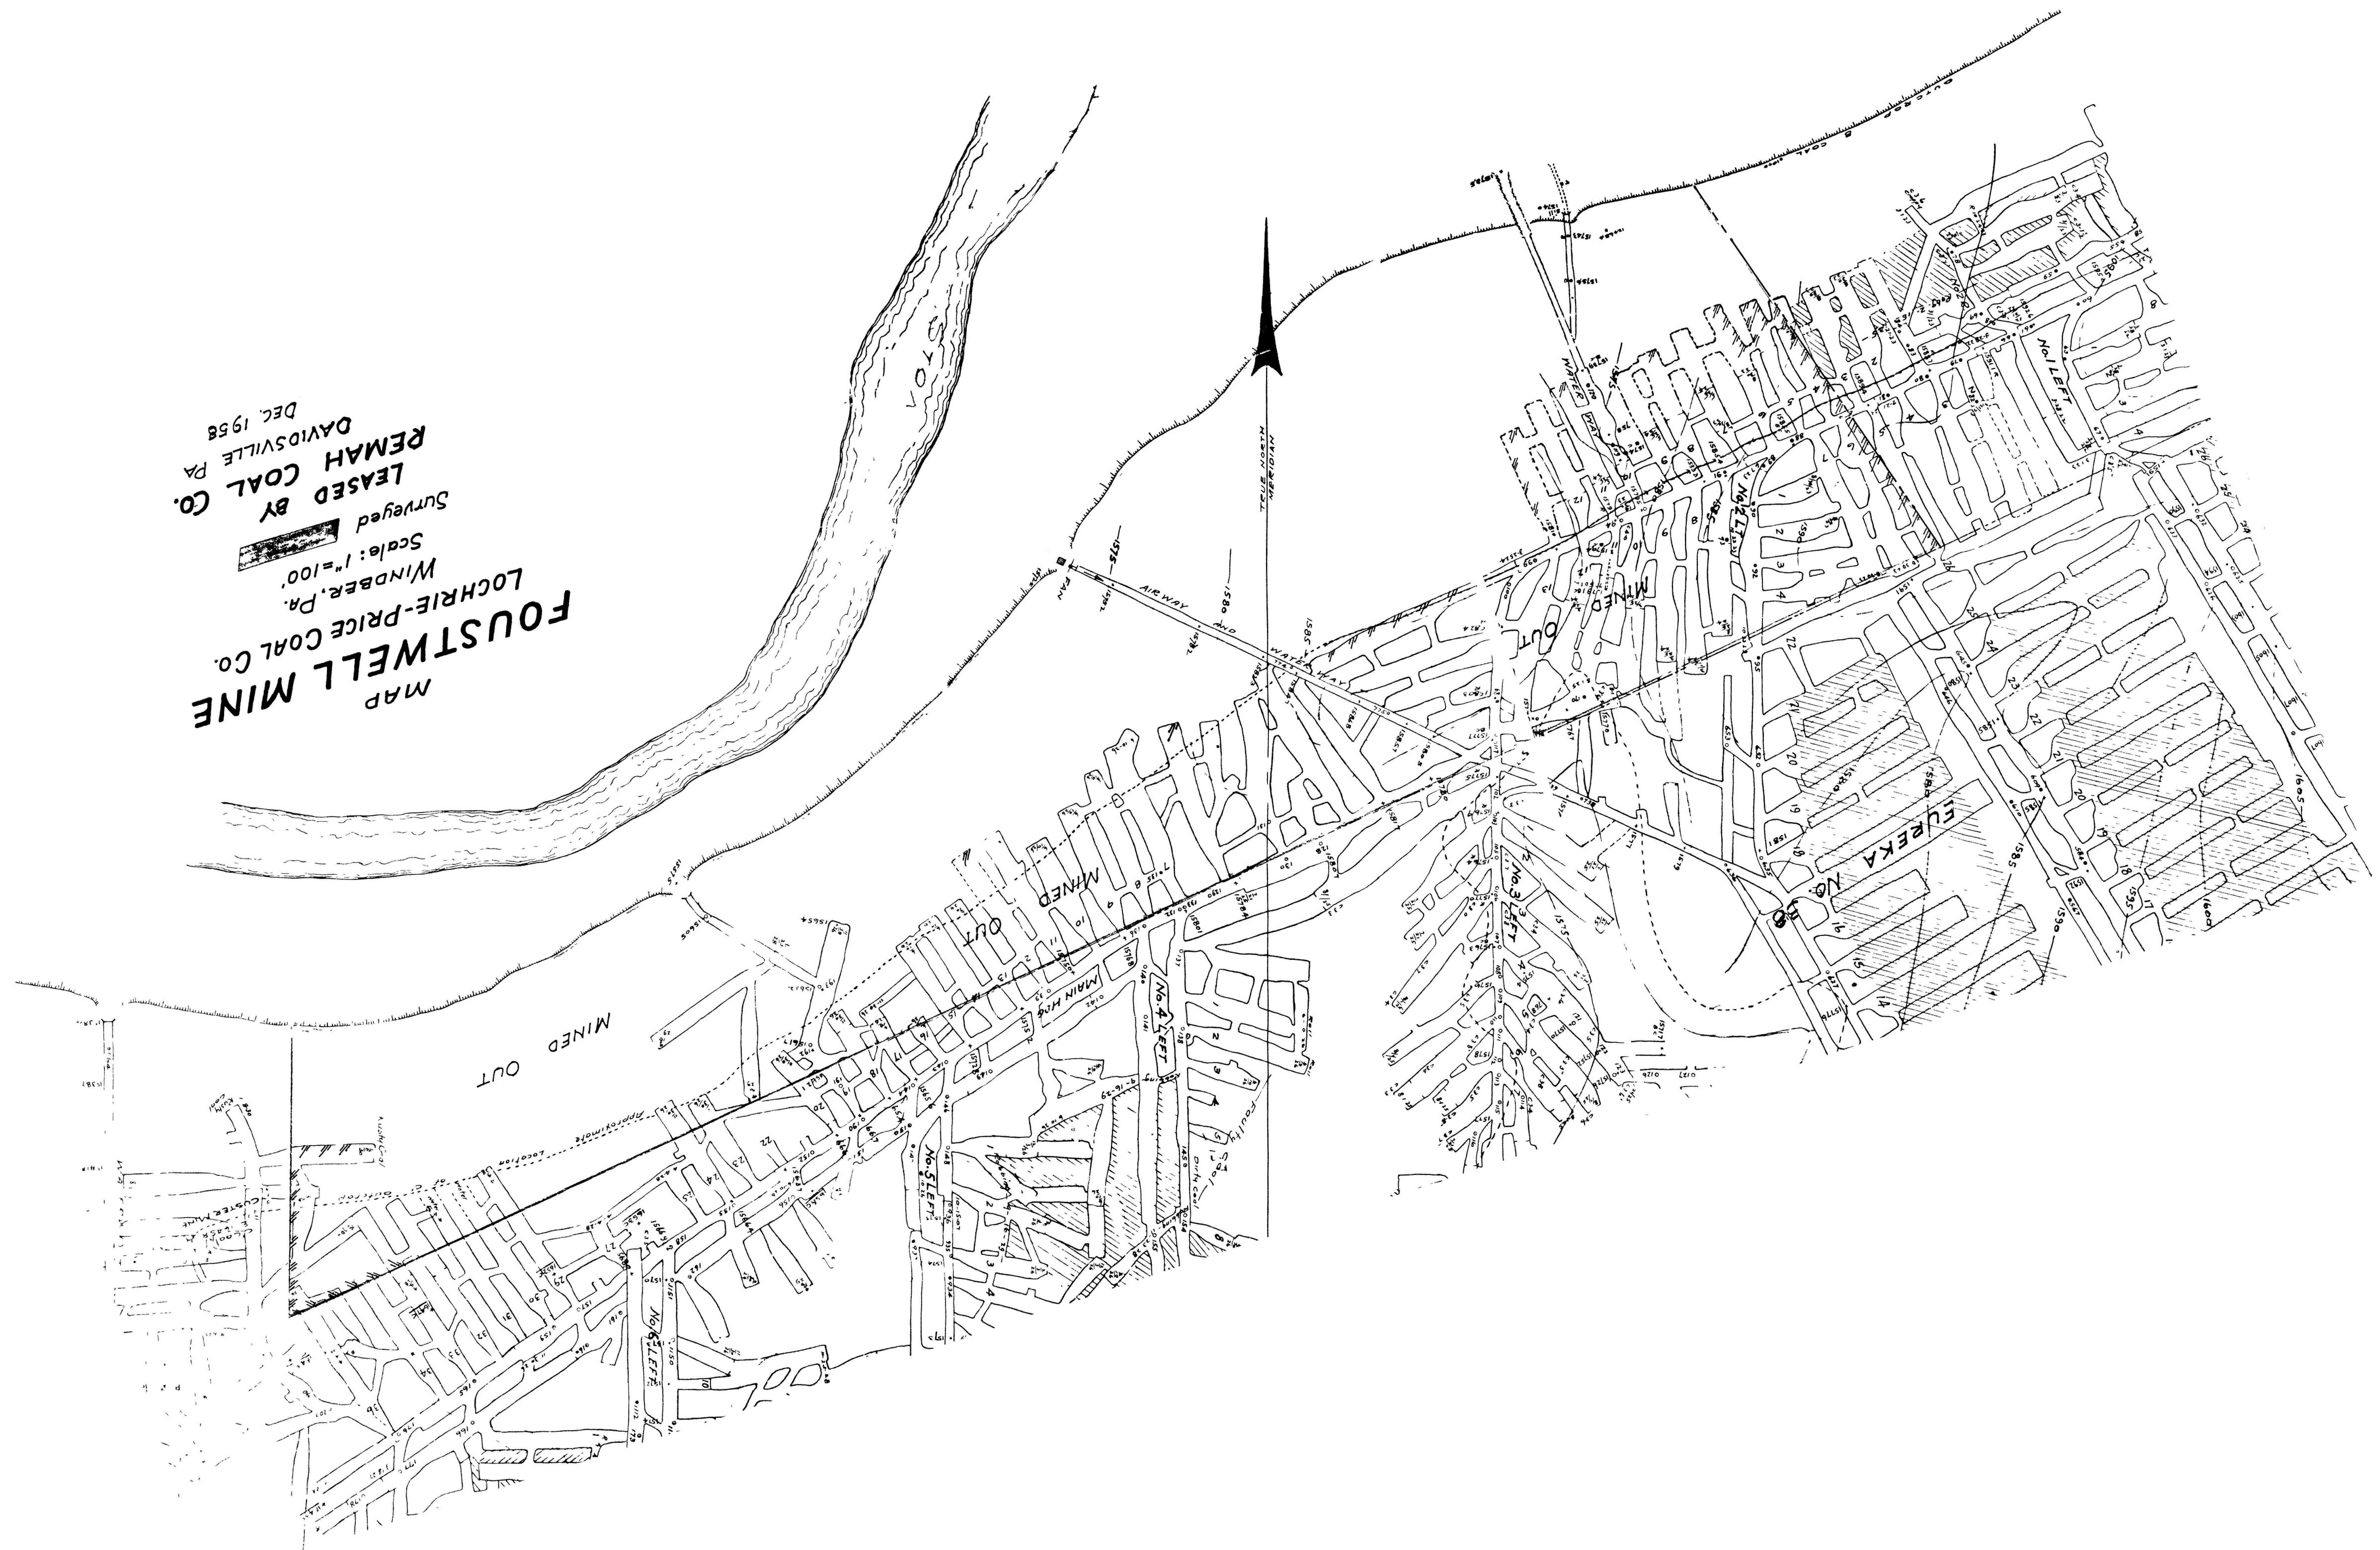

MAP
FOUSTWELL MINE
LOCHRIE-PRICE COAL CO.
WINDBER, PA.
Scale: 1"=100'
Surveyed BY
LEASD BY
REMAH COAL CO.
DAVIDSVILLE PA
DEC. 1958