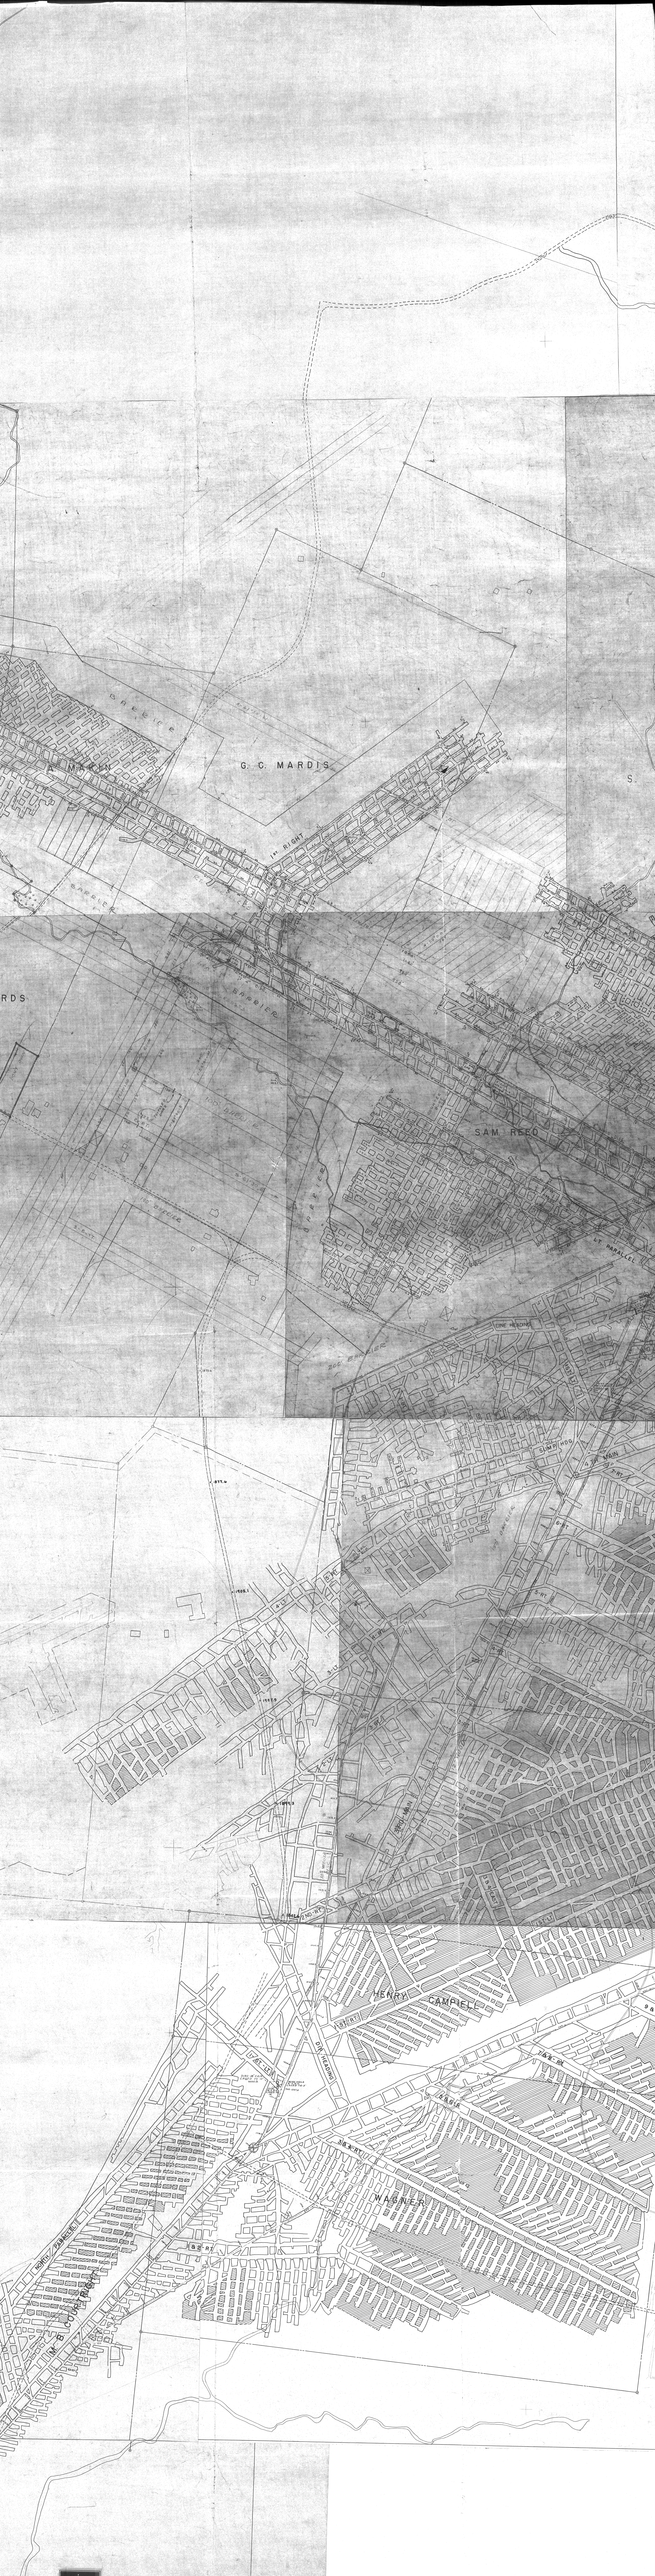

G. C. MARDIS
SAM REED
HENRY CAMPBELL
